


HARDY TOWNSHIP  
1ST. QTR. LOT 3  
T-9N; R-7W  
HOLMES COUNTY, OHIO  
(SURVEYED FOR LES HACKADAY)

9600001872  
Filed for Record in  
HOLMES COUNTY, OH  
SALLY MILLER  
On 06-20-1996 At 11:25 am.  
PLSM 20.00  
Vol. 16 Page 128  
Need Vol. 274 Pg. 5

INDEXED

0 50 100 200

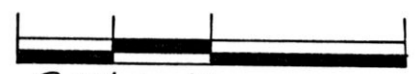


- SCALE: 1" = 100'
- P.K. NAIL FOUND
  - IRON PIN FOUND
  - 5/8" RE BAR WITH I.D. CAP SET
  - I.D. CAP MARKED "BAKER 6938"

REFERENCES:

DEED Vol. 209 PAGE 536  
 " " 267 " 29  
 " " 243 " 73

PLAT Vol. 15 PAGE 40  
 " " 9 " 66  
 " " 13 " 170

BEARINGS FROM PLAT Vol. 15  
PAGE 40

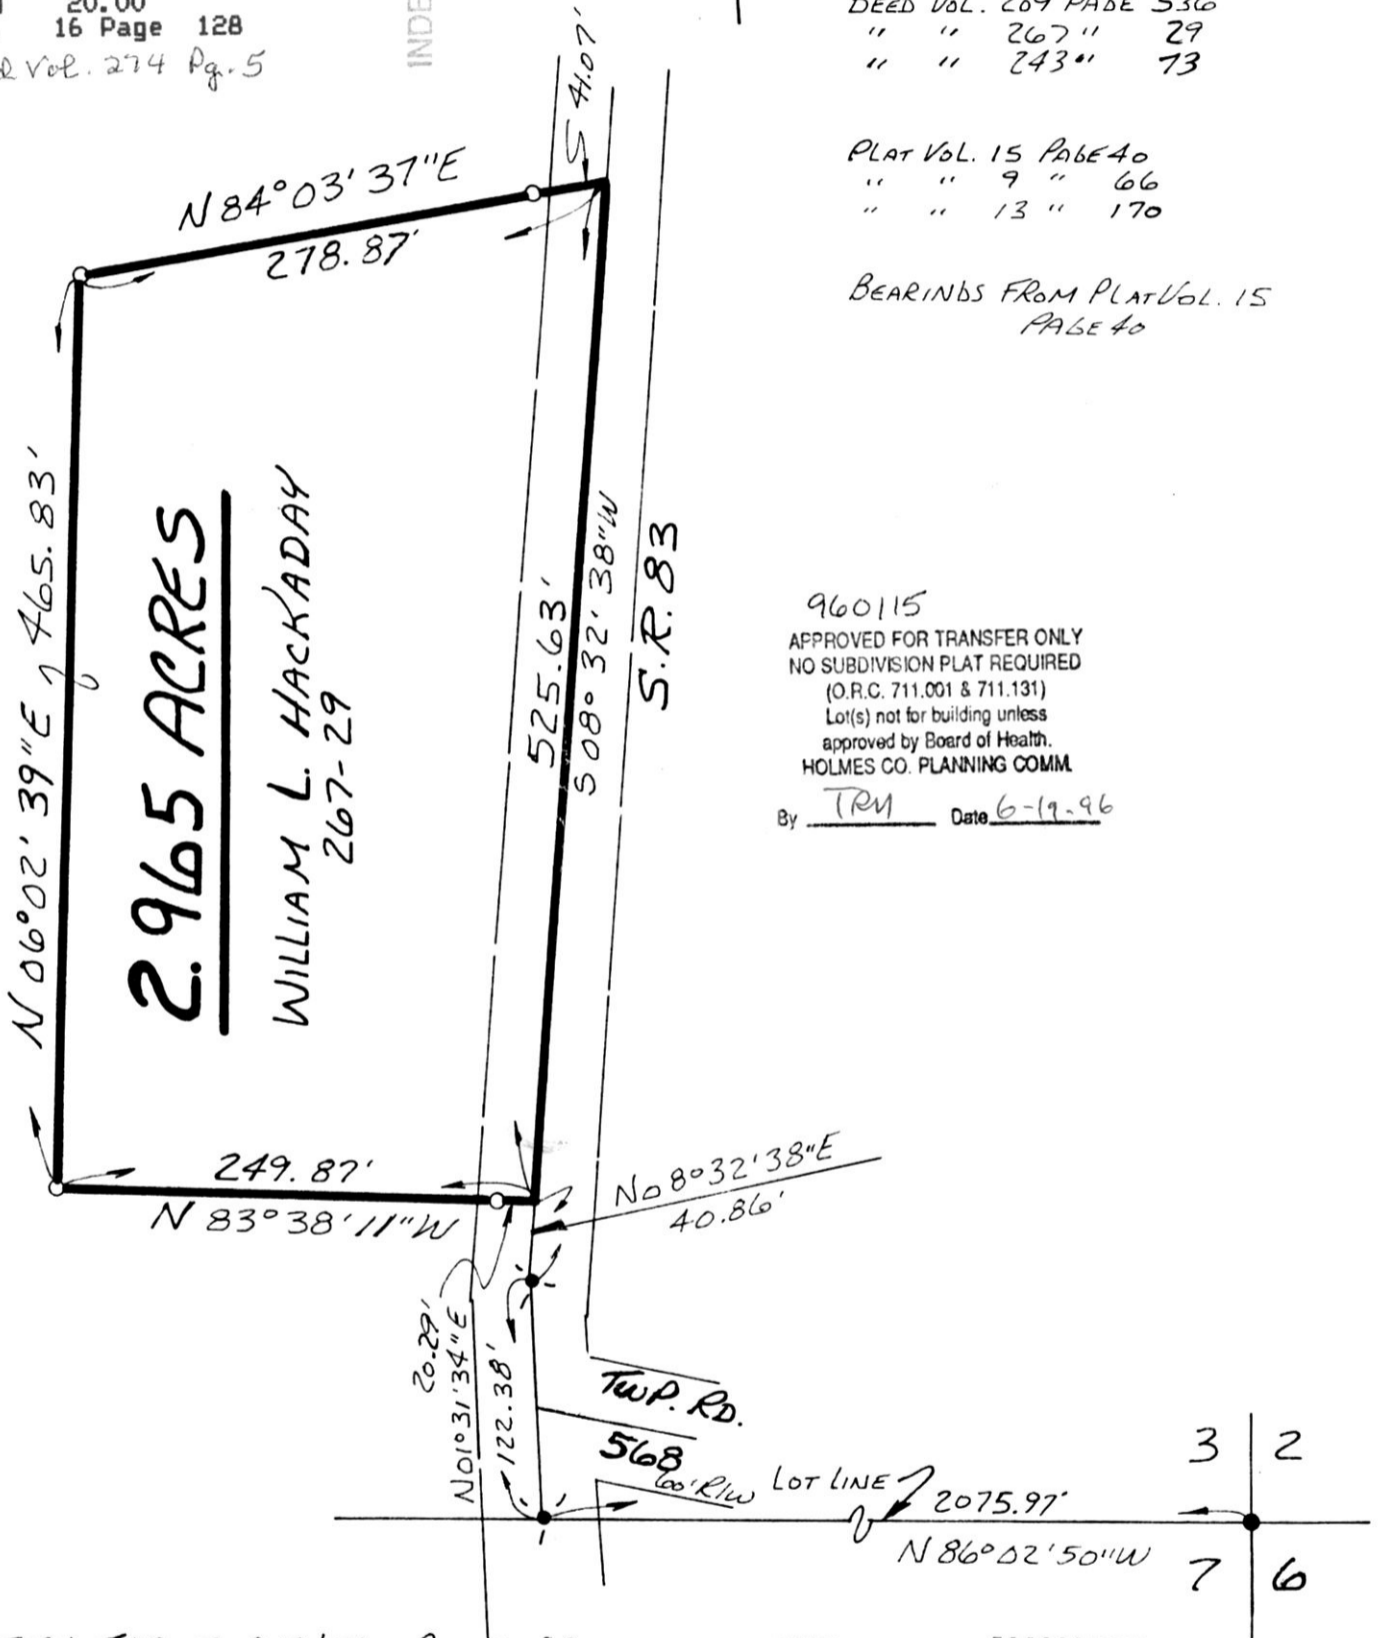

960115  
 APPROVED FOR TRANSFER ONLY  
 NO SUBDIVISION PLAT REQUIRED  
 (O.R.C. 711.001 & 711.131)  
 Lot(s) not for building unless  
 approved by Board of Health.  
 HOLMES CO. PLANNING COMM.  
 By TRM Date 6-19-96

I CERTIFY THIS SURVEY TO BE CORRECT  
TO THE BEST OF MY KNOWLEDGE.

Donald C. Baker  
 DONALD C. BAKER P.S. 6938  
 5958 T.R. 322  
 MILLERSBURG, OHIO 44654  
 Ph. (330) 674-4788

JUNE 10, 1996

31996-MLS



9600001872  
 GARRETT ROACH ATTY  
 MILLERSBURG,

PLAT APPROVED

6/20/96 B