



SCALE: 1" = 200'


- ▲ R.R. SPIKE FOUND
- IRON PIN FOUND
- 5/8" REBAR WITH I.D. CAP SET
- I.D. CAP MARKED "BAKER 6938"

VILLAGE OF GLENMONT
 RICHLAND TOWNSHIP
 N.E. & S.E. QTR. SECTION 1
 T-8N:R-9W
 HOLMES COUNTY, OHIO

REFERENCES:

| DEED VOL. | PAGE | NO. |
|-----------|------|---------|
| 269 | 708 | |
| " | 271 | 468 |
| " | 262 | 670 |
| " | 133 | 557 |
| " | 271 | 451 |
| " | 219 | 11 |
| " | 77 | 545 |
| PLAT VOL. | 10 | PAGE 81 |
| " | 7 | 416 |
| " | 1 | 323 |
| " | 14 | 984 |

BEARINGS FROM DEED VOL.
 255 PAGE 497

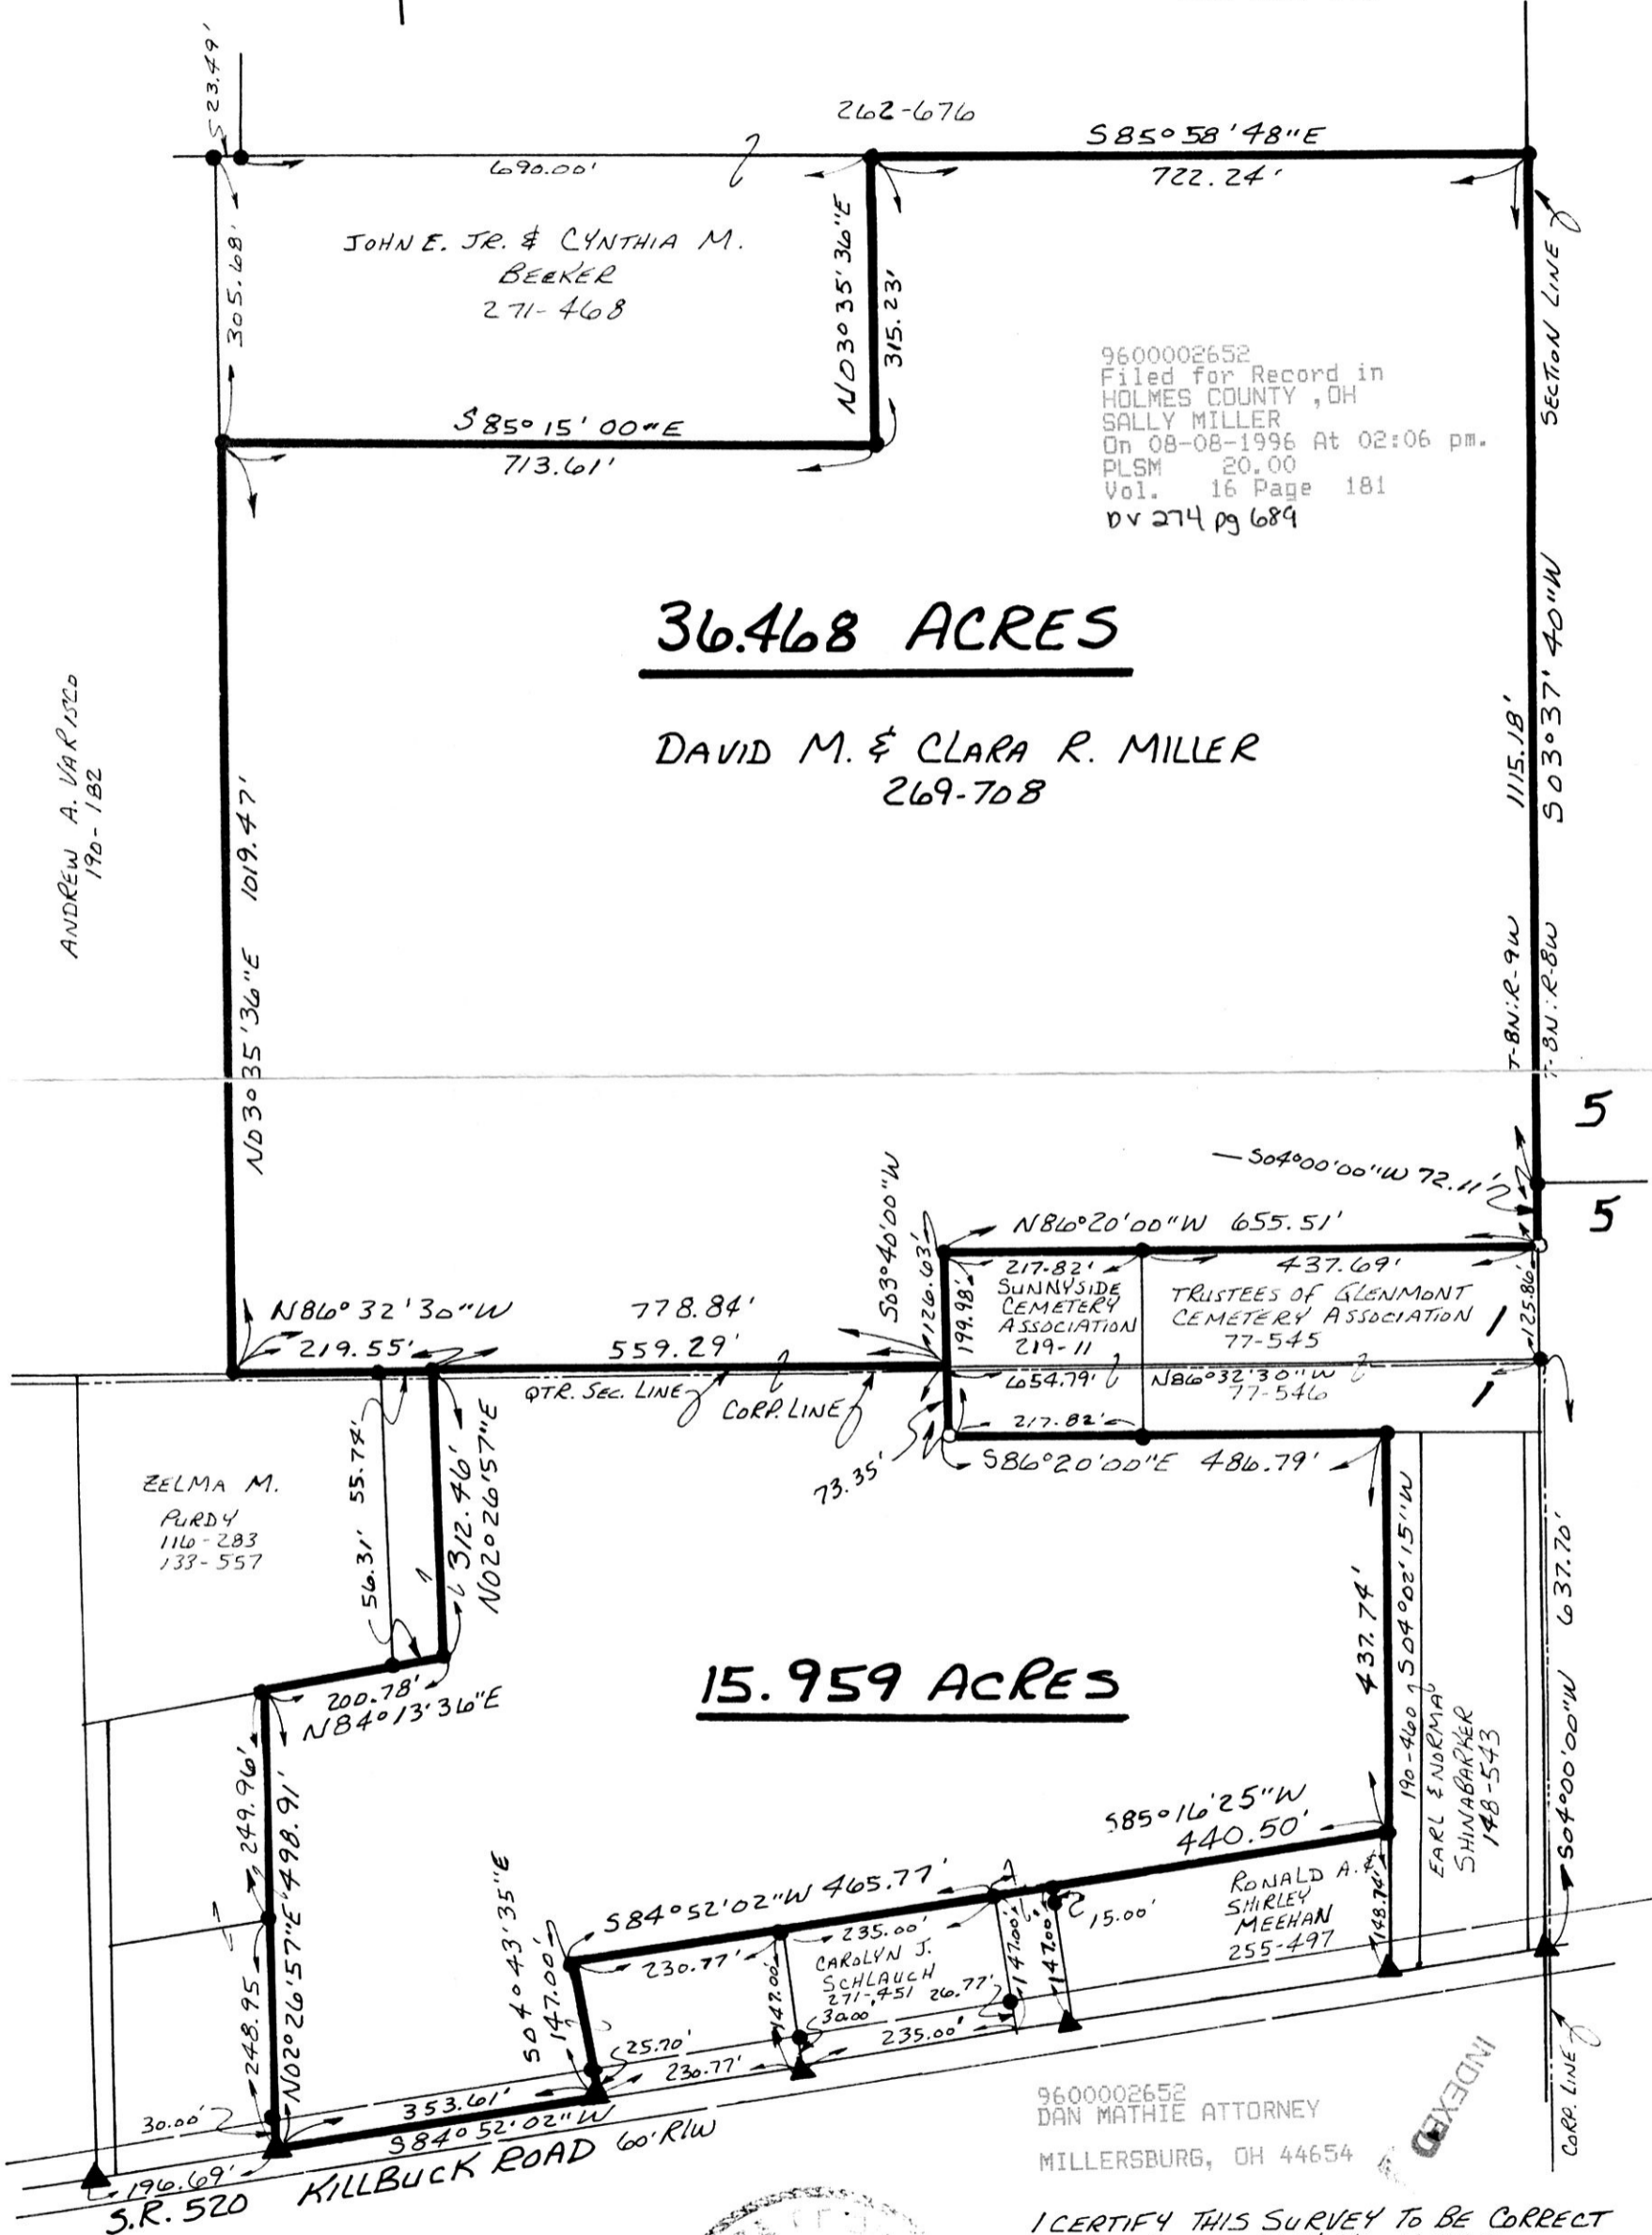

36.468 ACRES

DAVID M. & CLARA R. MILLER
 269-708

15.959 ACRES

9600002652
 DAN MATHIE ATTORNEY
 MILLERSBURG, OH 44654

I CERTIFY THIS SURVEY TO BE CORRECT
 TO THE BEST OF MY KNOWLEDGE.

Donald C. Baker
 DONALD C. BAKER P.S. 6938
 5958 T.R. 322
 MILLERSBURG, OHIO 44654
 PH. (330) 674-4788
 MARCH 26, 1996



PLAT APPROVED

8/2/968-

16896-MLS