


SCALE: 1"=100'

- ▲ R.R. SPIKE FOUND
- IRON PIN FOUND
- BOAT SPIKE FOUND
- △ R.R. SPIKE SET
- 5/8" RE BAR WITH I.D. CAP SET
- I.D. CAP MARKED "BAKER 6938"

SALT CREEK TOWNSHIP
4TH. QTR. LOT 16
T-10N; R-6W
HOLMES COUNTY, OHIO
 (SURVEYED FOR ROYAL RIDGE FARM)

REFERENCES:
 DEED Vol. 165 PAGE 555
 " " 225 " 886
 PLAT Vol. 5 PAGE 117
 " " 11 " 118
 BEARINGS FROM
 PLAT Vol. 4 PAGE 160

9600002669
 Filed for Record in
 HOLMES COUNTY, OH
 SALLY MILLER
 On 08-09-1996 At 12:01 pm.
 PLSM 20.00
 Vol. 16 Page 182
 DV 274 pg 701 5704

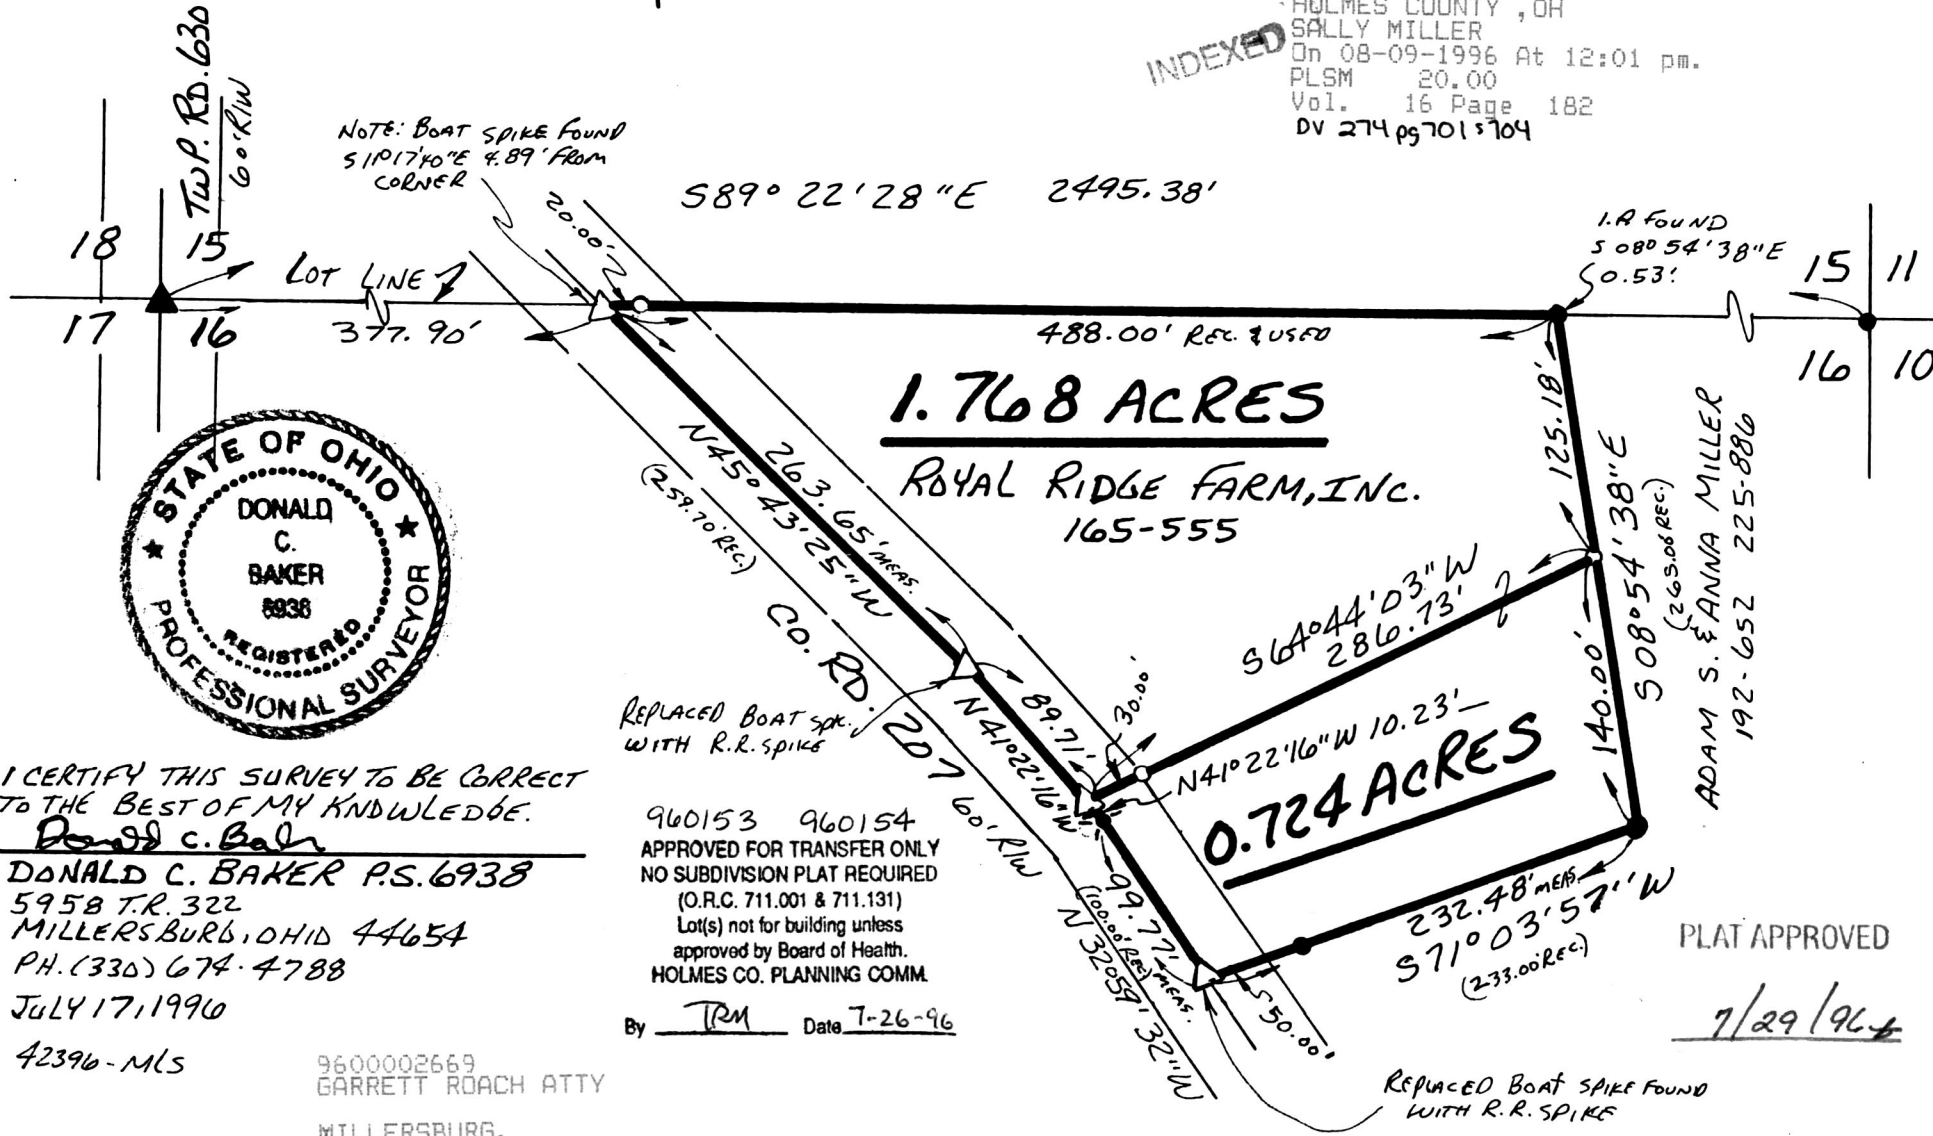

Vol. 16 page 182

I CERTIFY THIS SURVEY TO BE CORRECT TO THE BEST OF MY KNOWLEDGE.

Donald C. Baker

DONALD C. BAKER P.S. 6938
 5958 T.R. 322
 MILLERSBURG, OHIO 44654
 PH. (330) 674-4788
 42396-MLS

REPLACED BOAT SPIKE WITH R.R. SPIKE

960153 960154
 APPROVED FOR TRANSFER ONLY
 NO SUBDIVISION PLAT REQUIRED
 (O.R.C. 711.001 & 711.131)
 Lot(s) not for building unless approved by Board of Health.
 HOLMES CO. PLANNING COMM.

By TRM Date 7-26-96

9600002669
 GARRETT ROACH ATTY
 MILLERSBURG,

ADAM S. & ANNA MILLER
 192-652 225-886

PLAT APPROVED
7/29/96

REPLACED BOAT SPIKE FOUND WITH R.R. SPIKE