

**REFERENCES:**

DEED	VOL.	126	PAGE	220
"	"	209	"	822
"	"	274	"	985
"	"	274	"	987
"	"	175	"	515
"	"	214	"	405

BEARINGS FROM PLAT VOL. 16  
PAGE 207


**KILLBUCK TOWNSHIP  
S.E. QTR. SECTION 17  
T-8N; R-7W  
HOLMES COUNTY, OHIO**

0 100 200 400


SCALE: 1" = 200'

- STONE FOUND
- ▲ R.R. SPIKE FOUND
- IRON PIN FOUND
- 5/8" REBAR WITH I.D. CAP SET
- I.D. CAP MARKED "BAKER 6938"

960261  
APPROVED FOR TRANSFER OF  
NO SUBDIVISION PLAT REQUIRED  
(O.R.C. 711.001 & 711.191)  
Lot(s) not for building unless  
approved by Board of Health.  
HOLMES CO. PLANNING COMM  
By CDM Date 11/7/96

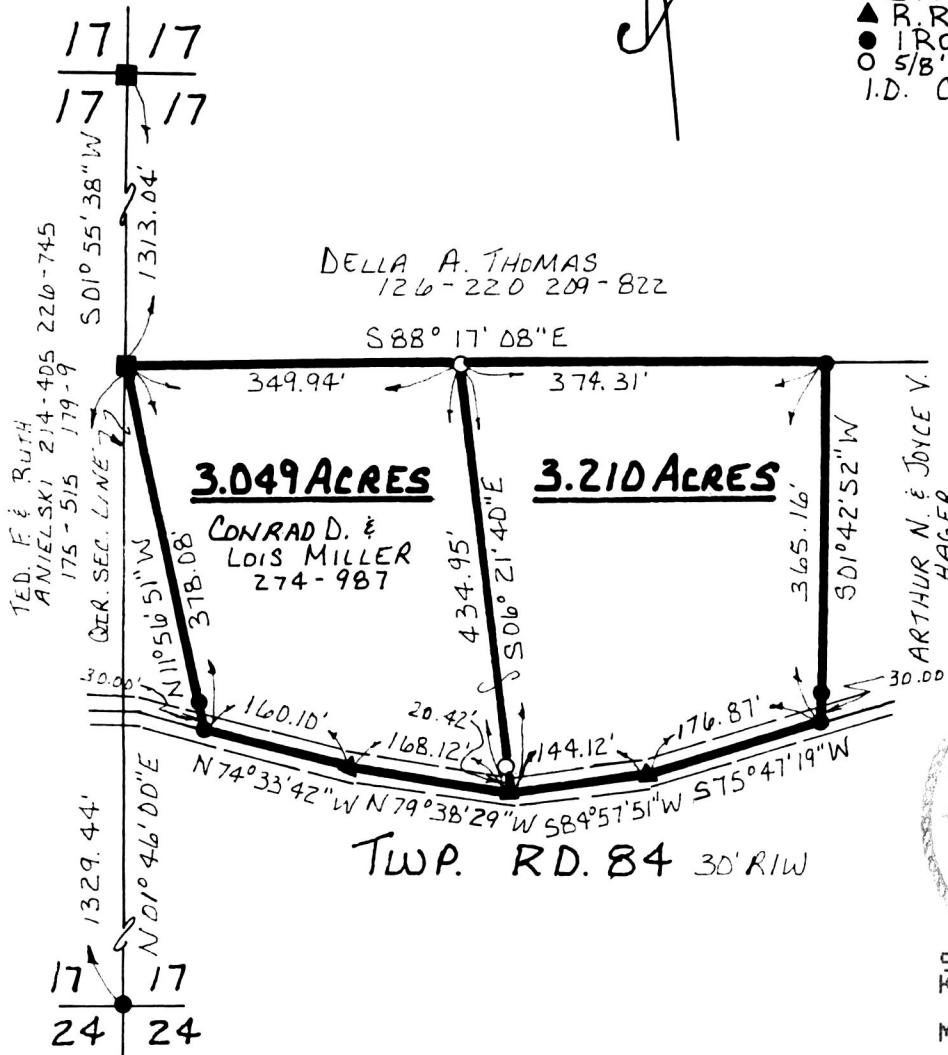

3.049 ac tract only  
9600004289  
Filed for Record in  
HOLMES COUNTY, OH  
SALLY MILLER  
on 11-08-1996 At 12:23 pm.  
PLSM 20.00  
Vol. 16 Page 274  
ov 276 page 125

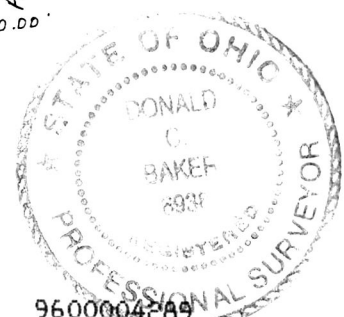

9600004289  
KURT MILLER  
MILLERSBURG, OH 44654

I CERTIFY THIS SURVEY TO BE CORRECT  
TO THE BEST OF MY KNOWLEDGE.

Donald C. Baker  
DONALD C. BAKER P.S. 6938  
5958 T.R. 322  
MILLERSBURG, OHIO 44654  
PH: (330) 674-4788  
OCTOBER 23, 1996

SURVEYED FOR CONRAD D. MILLER

PLAT APPROVED

63596 FJM

11/8/96