


DAVID A. & AMANDA TRBYER
269-460

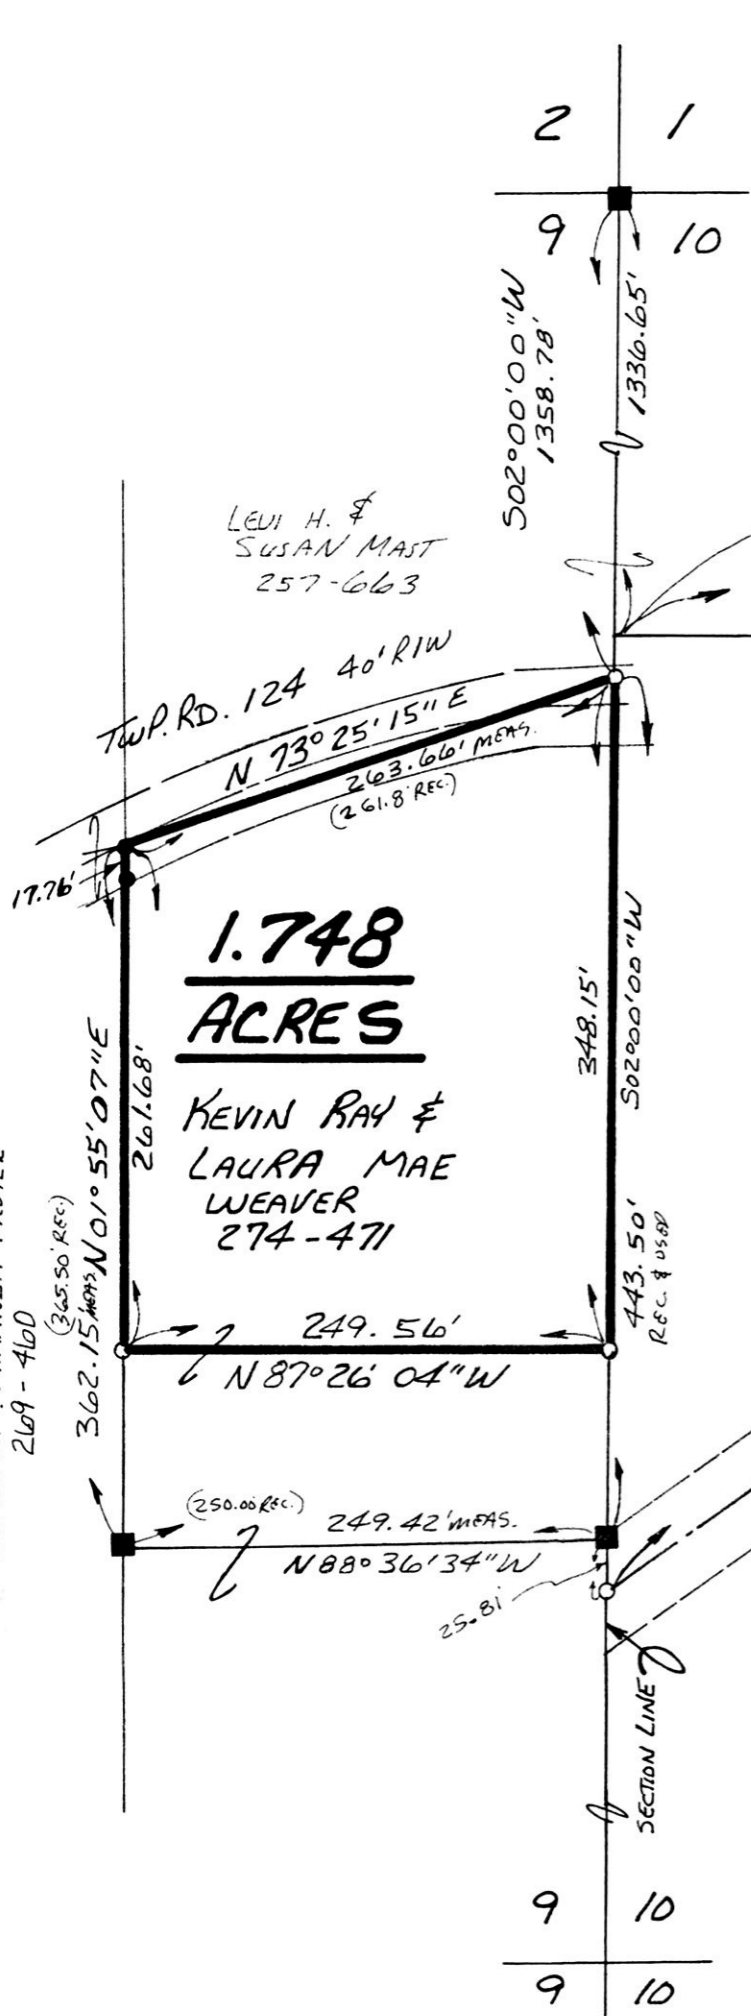

**1.748
ACRES**

KEVIN RAY &
LAURA MAE
WEAVER
274-471

LEVI H. &
SUSAN MAST
257-663


ELI N. & ANNA MILLER
222-890

INDEXED

970006026
Filed for Record in
HOLMES COUNTY, OH
SALLY MILLER
On 03-14-1997 At 09:02 am.
PLSM 20.00
Vol. 16 Page 364
01 277 page 477

MECHANIC TOWNSHIP
N.E. QTR. SECTION 9 & N.W. QTR. SECTION 10
T-8N; R-6W
HOLMES COUNTY, OHIO

(SURVEYED FOR: KEVIN WEAVER)

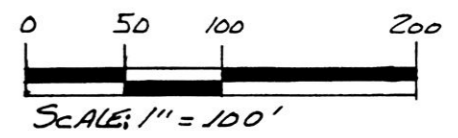

- STONE FOUND
- IRON PIN FOUND
- 5/8" RE BAR WITH I.D. CAP SET I.D. CAP MARKED "BAKER 6938"

- REFERENCES:
- DEED VOL. 274 PAGE 471
 - " " 222 " 890
 - " " 257 " 663
 - " " 212 " 861

BEARINGS FROM PLAT VOL. 4
PAGE 90



970033
 APPROVED FOR TRANSFER ONLY
 NO SUBDIVISION PLAT REQUIRED
 (O.R.C. 711.001 & 711.131)
 Lot(s) not for building unless
 approved by Board of Health.
 HOLMES CO. PLANNING COMM.
 By TRM Date 3-12-97

970006026
 LAUREL HINES ATTY
 MILLERSBURG,

I CERTIFY THIS SURVEY TO BE
CORRECT TO THE BEST OF MY
KNOWLEDGE.

Donald C. Baker
 DONALD C. BAKER P.S. 6938
 5958 T.R. 322
 MILLERSBURG, OHIO 44654
 PH. (330) 674-4788
 DECEMBER 10, 1996

PLAT APPROVED
3/13/97