


KNOX TOWNSHIP
 S.E. QTR. SECTION 19
 S.W. QTR. SECTION 20
 N.W. QTR. SECTION 29
 N.E. QTR. SECTION 30
 T-19 N; R-15W
 HOLMES COUNTY, OHIO

(SURVEYED FOR BYRON & SUE BURWELL)

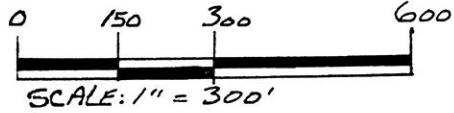

- STONE FOUND
- IRON PIN FOUND
- ▲ R.R. SPIKE FOUND
- 5/8" RE BAR WITH I.D. CAP SET
- I.D. CAP MARKED "BAKER 6938"

REFERENCES:

DEED VOL. 259 PAGE 601
 " " 276 " 739
 " " 255 " 599
 " " 251 " 176

PLAT VOL. 7 PAGE 358

PLAT OF OCTOBER HILL'S PHASE III



I CERTIFY THIS SURVEY TO BE CORRECT TO THE BEST OF MY KNOWLEDGE.

Donald C. Baker
 DONALD C. BAKER P.S. 6938
 138 N. CLAY ST.
 MILLERSBURG, OHIO 44654
 PH. (330) 674-4788

FEBRUARY 26, 1997
 6699-MLD
 F.C.C.-F.D. BAKER


970006144
 SOUTHERN TITLE
 MANSFIELD, OH 44901

NOTE:

DEED DISTANCES ALONG TWP. RD. 211 DID NOT FIT THE EXISTING ROAD. NO MONUMENTATION WAS FOUND. THE EXISTING ROAD WAS USED AS THE PROPERTY LINE.

970006144
 Filed for Record in
 HOLMES COUNTY, OH
 SALLY MILLER
 On 03-24-1997 At 10:28 am.
 PLSM 20.00
 Vol. 16 Page 370
 of 277 page 540

BEARING FROM DEED VOL. 259 PAGE 601

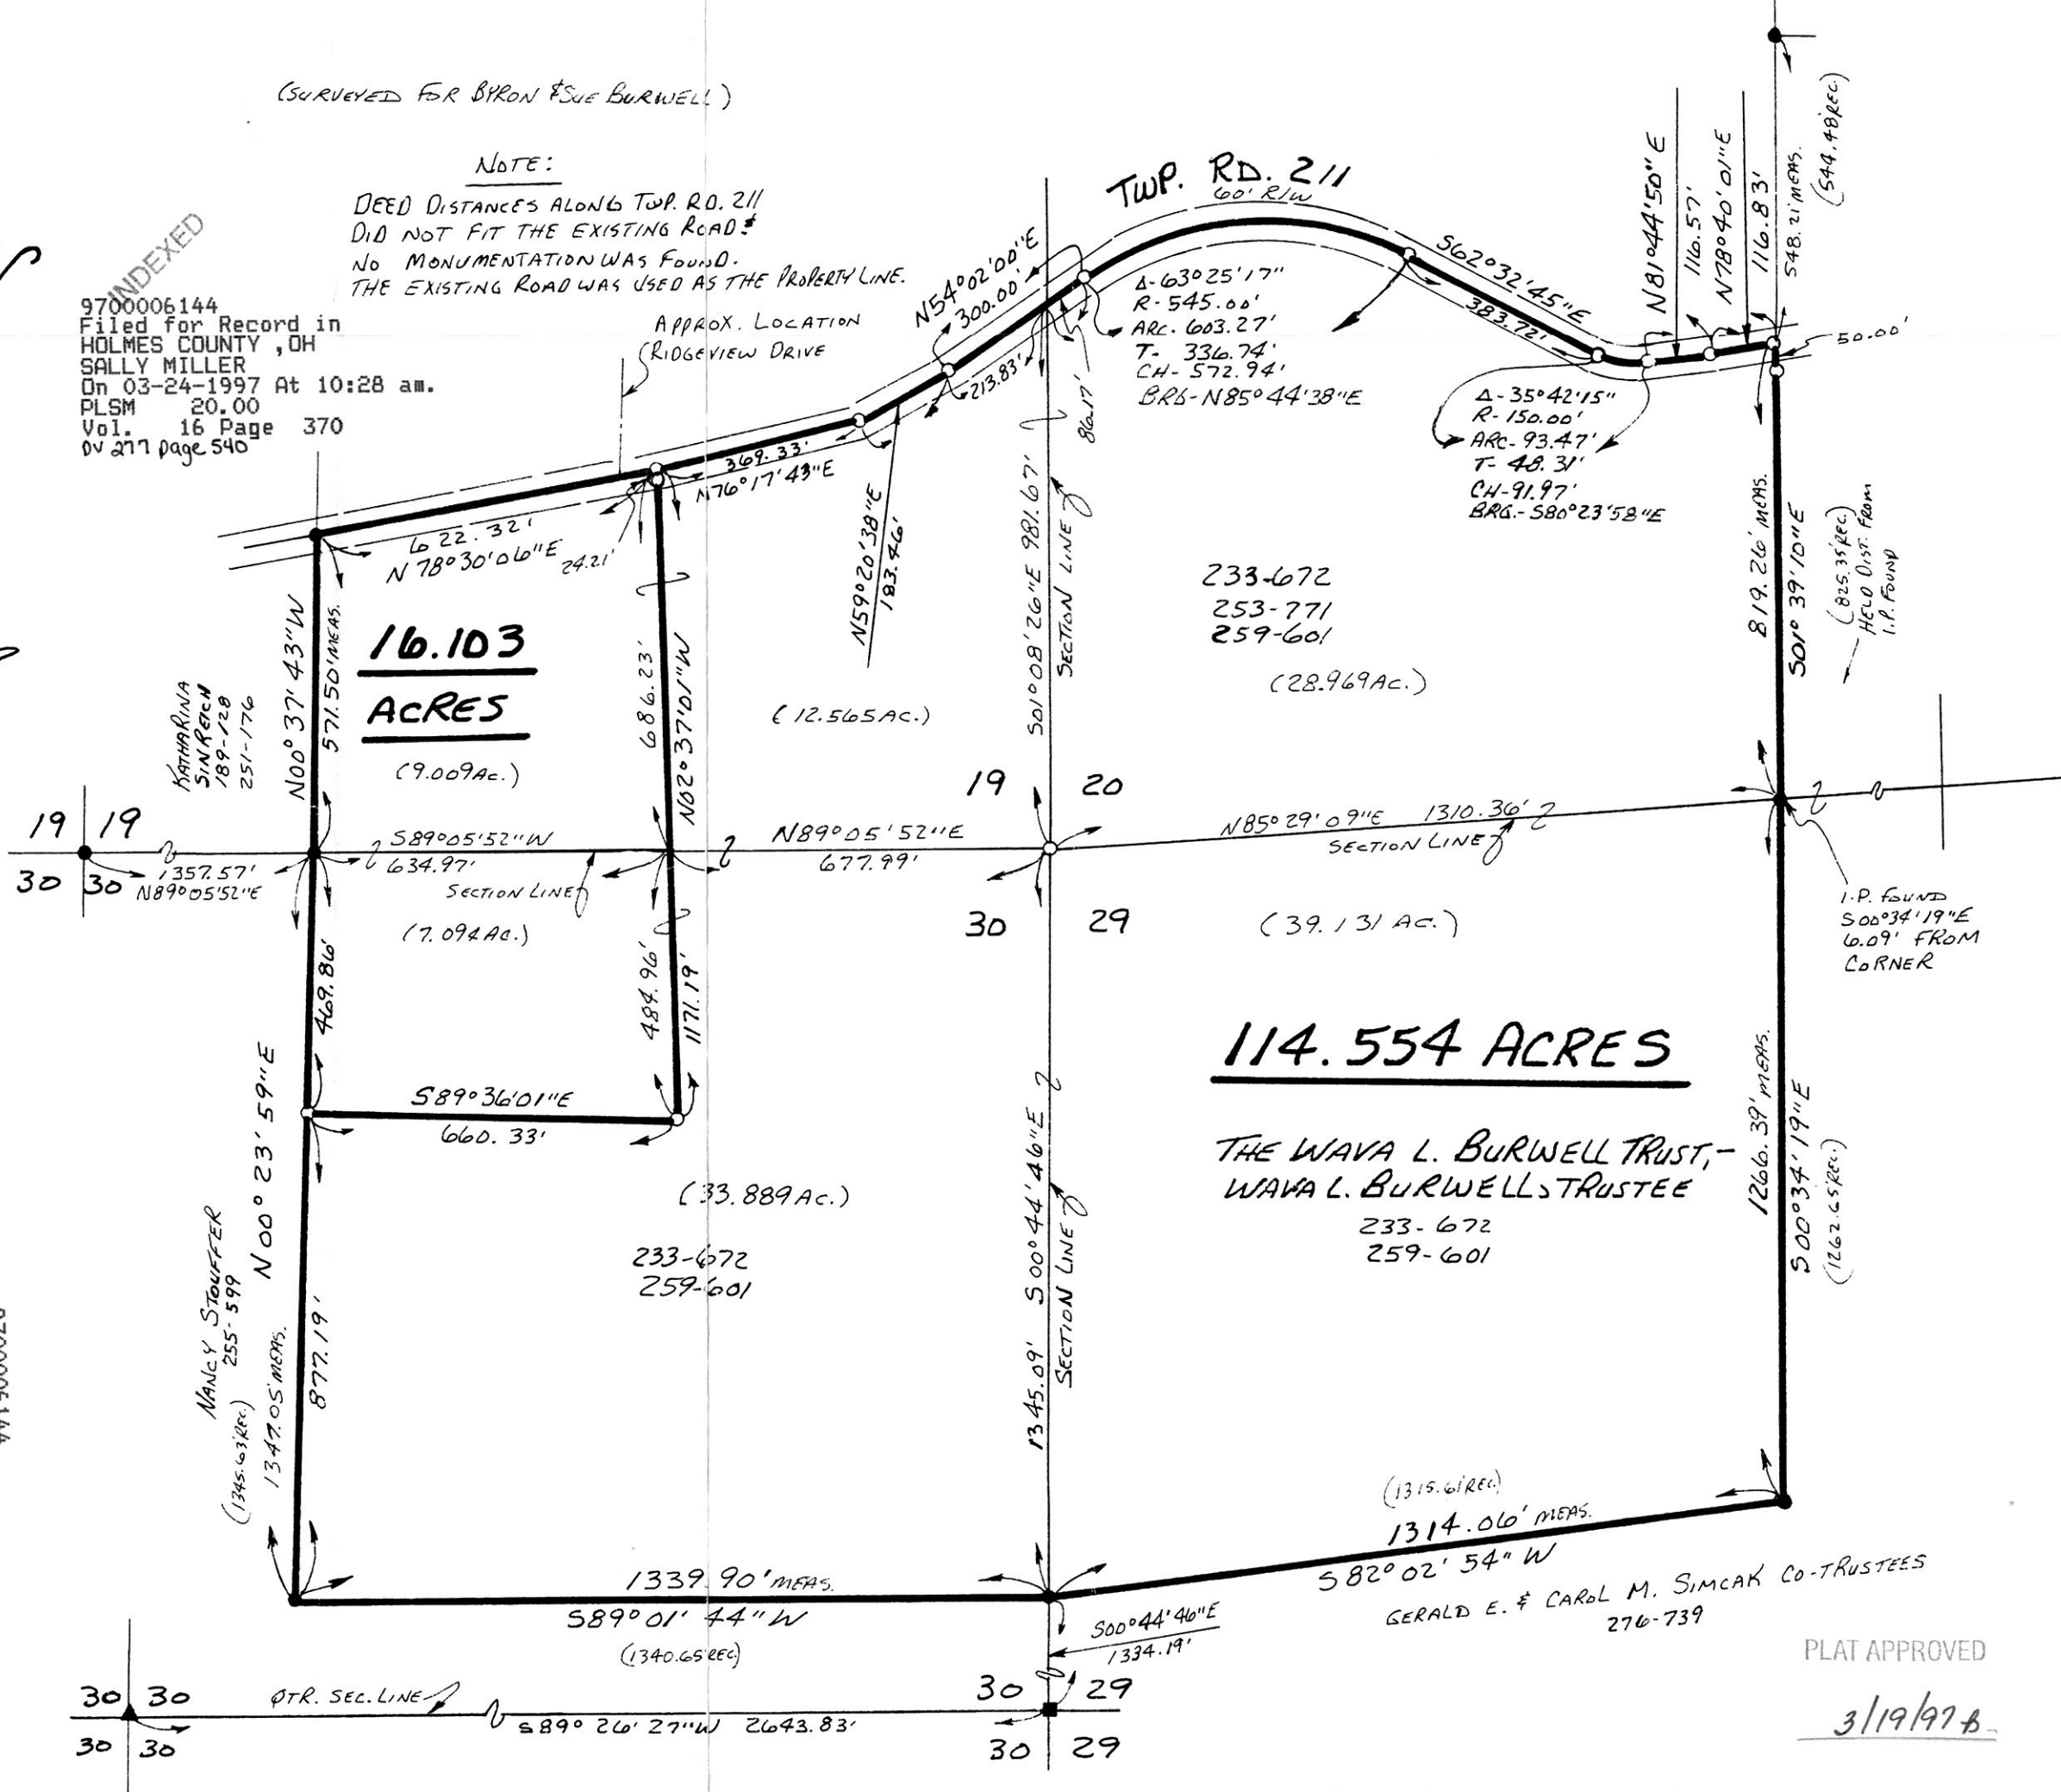

PLAT APPROVED
 3/19/97 B

VOL 16 PAGE 370