
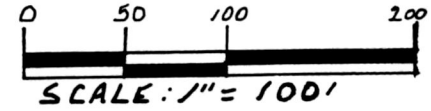


REFERENCES:

DEED VOL. 249 PAGE 926
" " 180 " 339
" " 245 " 969

SURVEY RECORD 2 PAGE 134
" " 5 " 185

HARDY TOWNSHIP
2ND. QTR. Lot 7
T-9N:R-7W
HOLMES COUNTY, OHIO

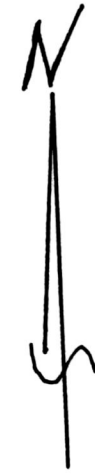


- IRON PIN FOUND
- 5/8" RE BAR WITH I.D. CAP SET
I.D. CAP MARKED "BAKER 6938"

970061
APPROVED FOR TRANSFER ONLY
NO SUBDIVISION PLAT REQUIRED
(O.R.C. 711.001 & 711.131)
Lot(s) not for building unless
approved by Board of Health.
HOLMES CO. PLANNING COMM.
By TRU Date 4-17-97

9700006562
Filed for Record in
HOLMES COUNTY, OH
SALLY MILLER
On 04-17-1997 At 12:32 pm.
PLSM 20.00
Vol. 16 Page 391
of 277 page 872


INDEXED

9700006562
LAUREL HINES ATTORNEY
MILLERSBURG, OH 44654

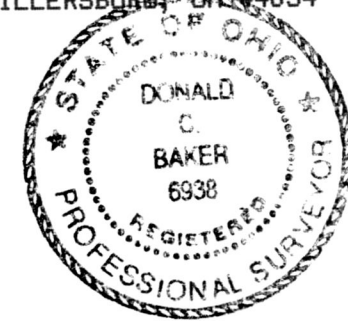

I CERTIFY THIS SURVEY TO BE CORRECT
TO THE BEST OF MY KNOWLEDGE.

Donald C Baker
DONALD C. BAKER P.S. 6938
5958 T. R. 322
MILLERSBURG, OHIO 44654
PH. (330) 674-4788
MARCH 28, 1996

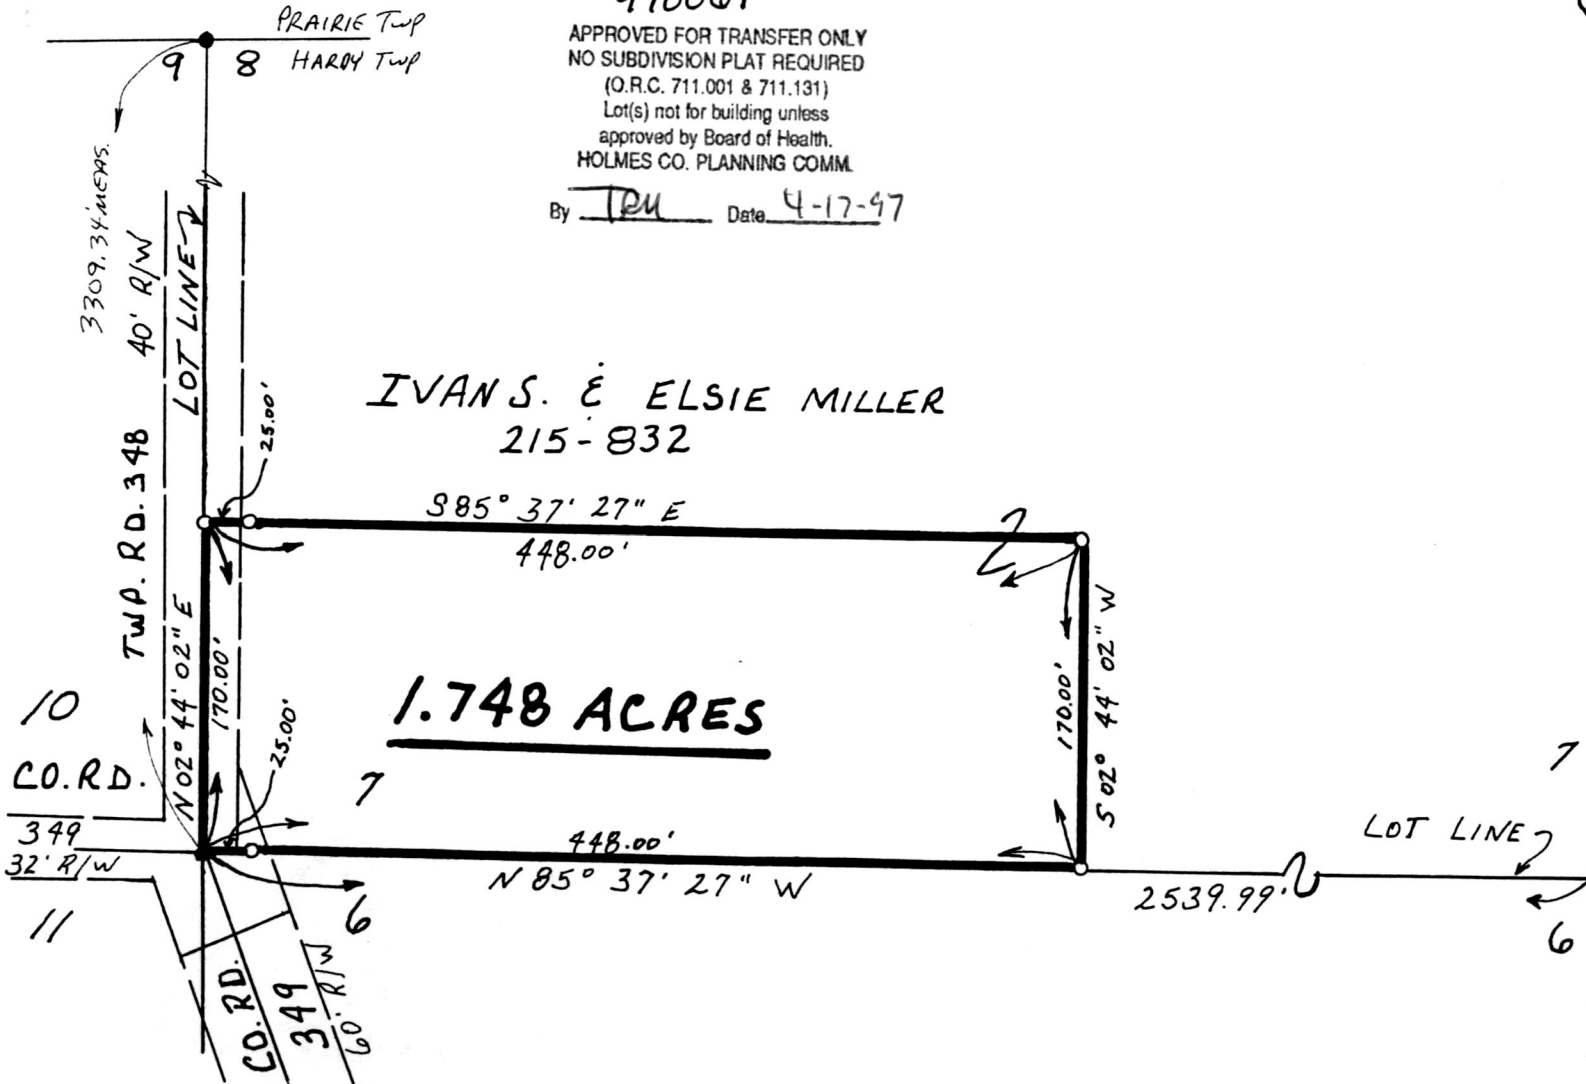

PLAT APPROVED

17696-SRU

4/17/97-B