


MECHANIC TOWNSHIP
 3RD. QTR. LOTS 6 & 7
 T-8N R-6W
 HOLMES COUNTY, OHIO

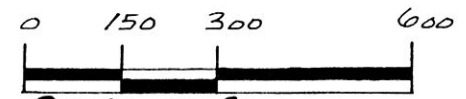

- SCALE: 1" = 300'
- STONE FOUND
 - IRON PIN FOUND
 - △ R.R. SPIKE SET
 - 5/8" REBAR WITH I.D. CAP SET
 - I.D. CAP MARKED "BAKER 6938"

REFERENCES:


DEED Vol. 223 PAGE 13
 " " 151 " 95
 " " 171 " 89

PLAT Vol. 9 PAGE 217

BEARINGS FROM DEED Vol. 151
 PAGE 95

9700006619
 Filed for Record in
 HOLMES COUNTY, OH
 SALLY MILLER
 On 04-21-1997 At 12:16 pm.
 PLSM 20.00
 Vol. 16 Page 393
 of 277 page 905-908

INDEXED

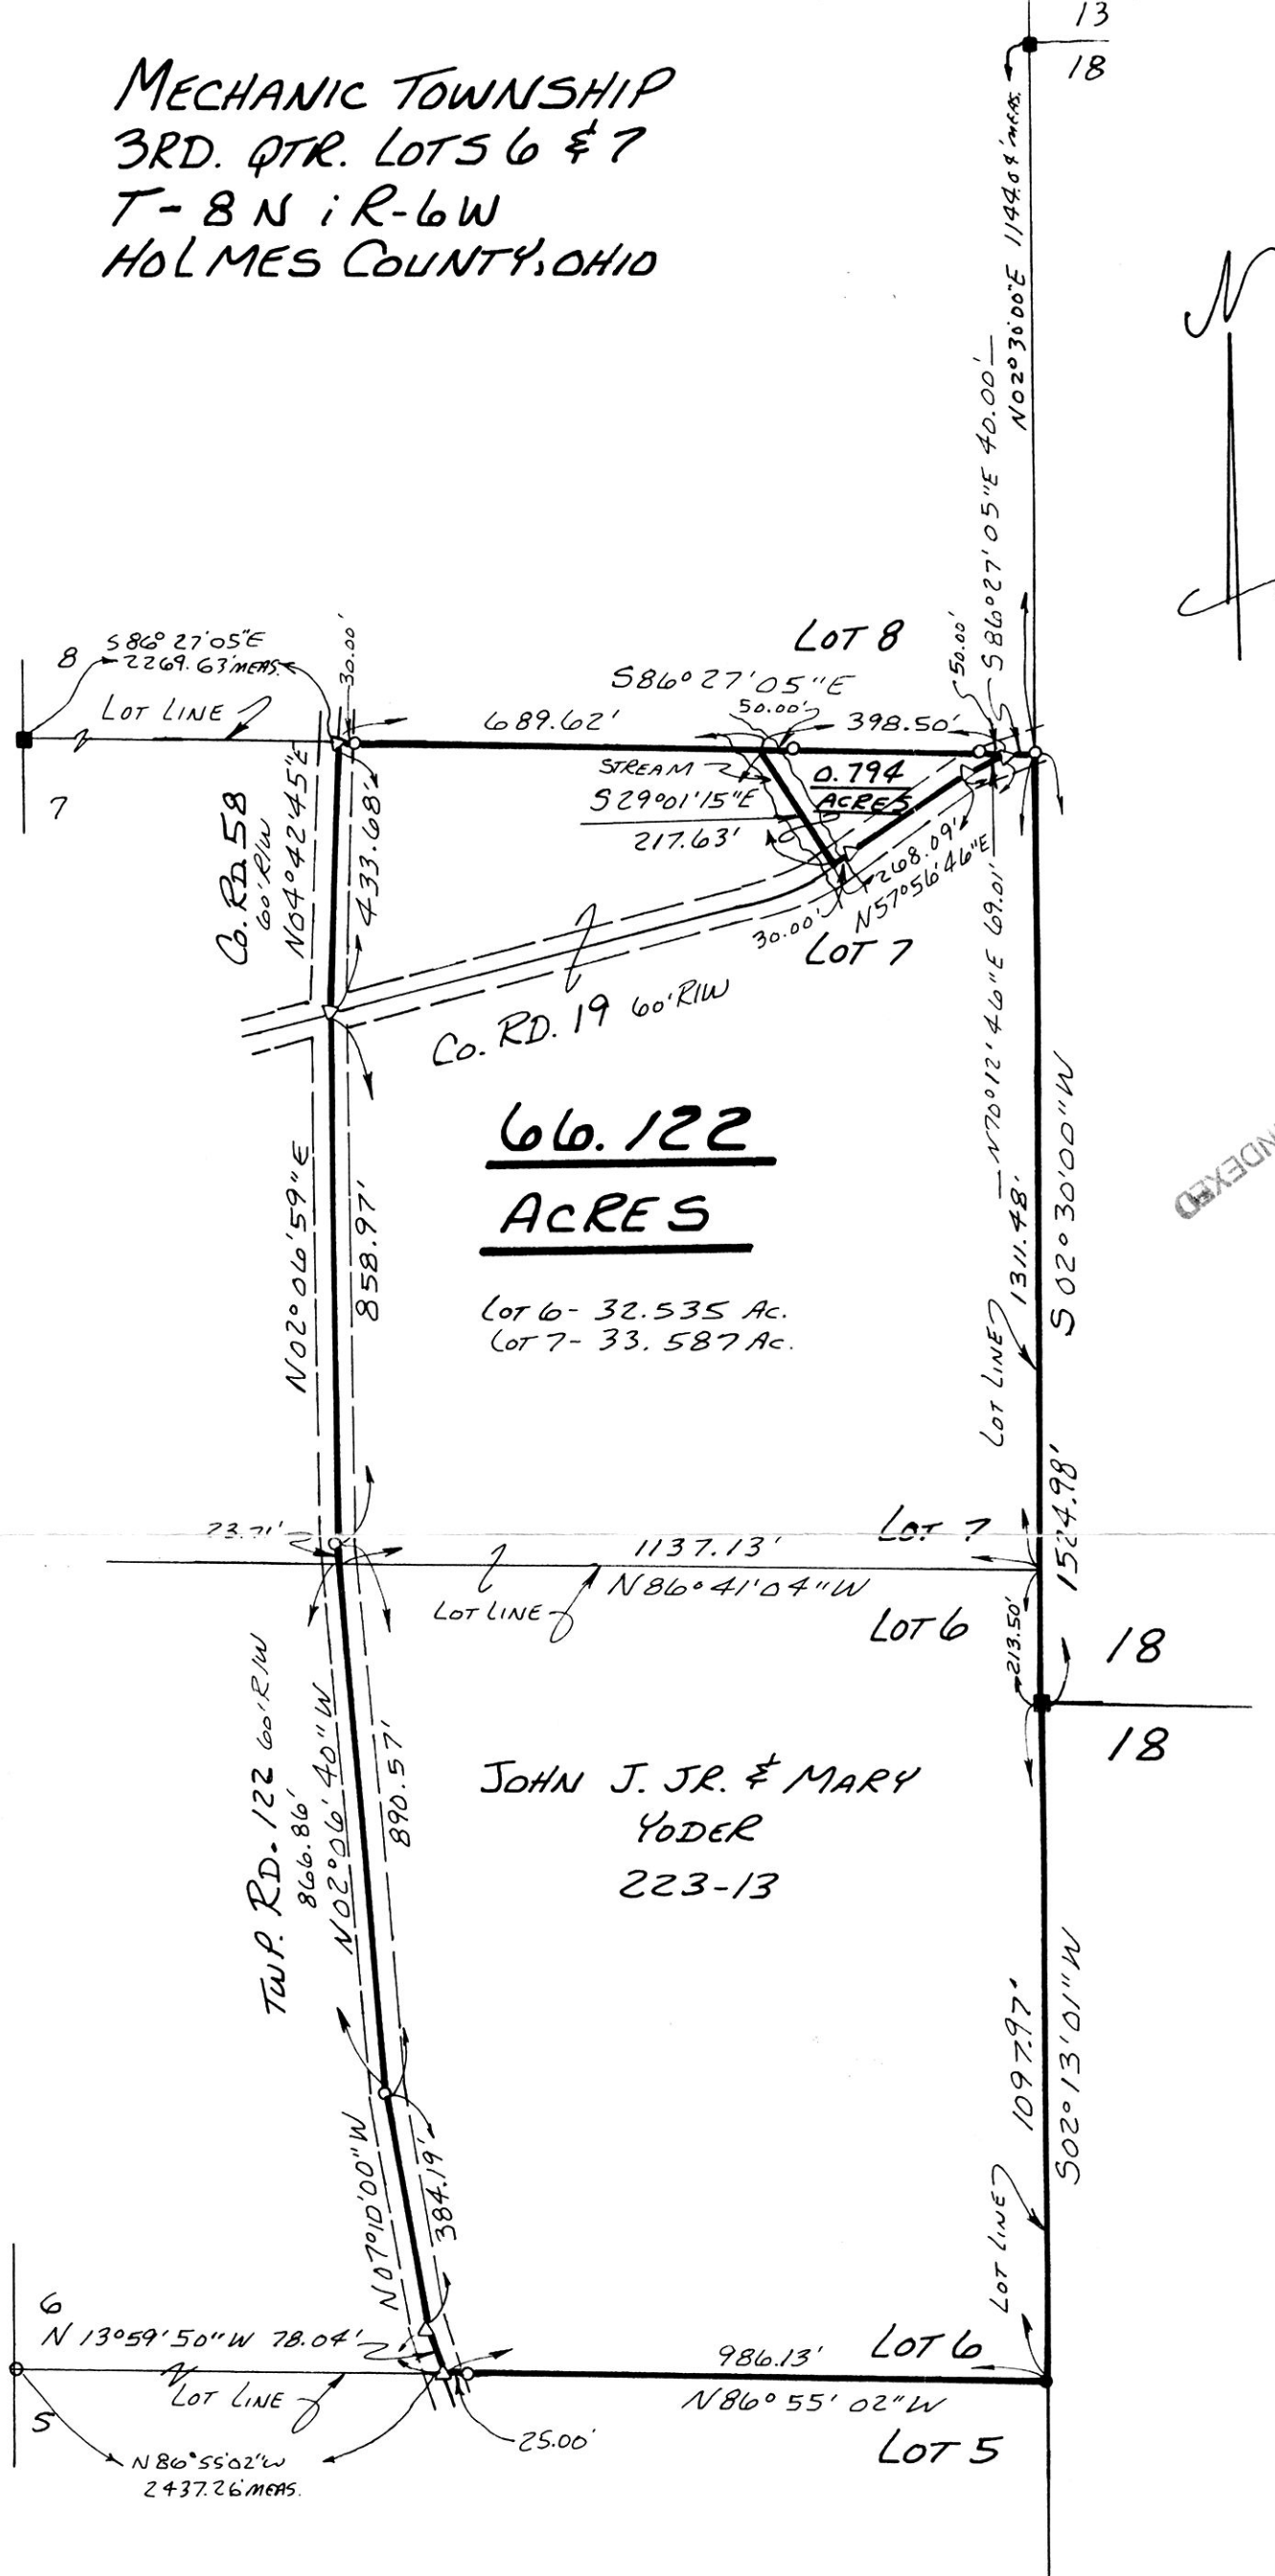

66.122
ACRES

Lot 6 - 32.535 Ac.
 Lot 7 - 33.587 Ac.

JOHN J. JR. & MARY
 YODER
 223-13



I CERTIFY THIS SURVEY TO BE
 CORRECT TO THE BEST OF MY
 KNOWLEDGE.

Donald C. Baker
 DONALD C. BAKER P.S. 6938
 5958 T.R. 322
 MILLERSBURG, OHIO 44654
 PH. (216) 674-4788

JANUARY 3, 1996

9700006619
 MAX A MILLER ATTY
 MILLERSBURG,

69095-MLS
 FJM

APPROVED FOR TRANSFER ONLY
 NO SUBDIVISION PLAT REQUIRED
 (O.R.C. 711.001 & 711.131)
 Lot(s) not for building unless
 approved by Board of Health.
 HOLMES CO. PLANNING COMM.

PLAT APPROVED

By *TRM* Date *3/26/97*

3/26/97 B