


WALNUT CREEK TOWNSHIP
1ST. QTR. LOT 11
T-9N; R-5W
HOLMES COUNTY, OHIO

970105
APPROVED FOR TRANSFER ONLY
NO SUBDIVISION PLAT REQUIRED
(O.F.C. 711.001 & 711.131)
Lot(s) not for building unless
approved by Board of Health.
HOLMES CO. PLANNING COMM


By CDM Date 6/3/97

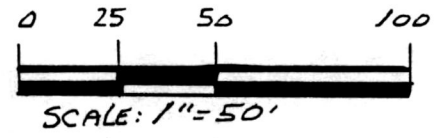

- ▲ R.R. SPIKE FOUND
- IRON PIN FOUND
- STONE FOUND

REFERENCES:
 DEED Vol. 192 PAGE 825
 " " 103 " 578
 " " 206 " 527
 " " 228 " 424
 " " 209 " 242

PLAT Vol. 7 PAGE 558
 " " 14 " 639
 BEARINGS FROM PLAT Vol. 8 PAGE 427

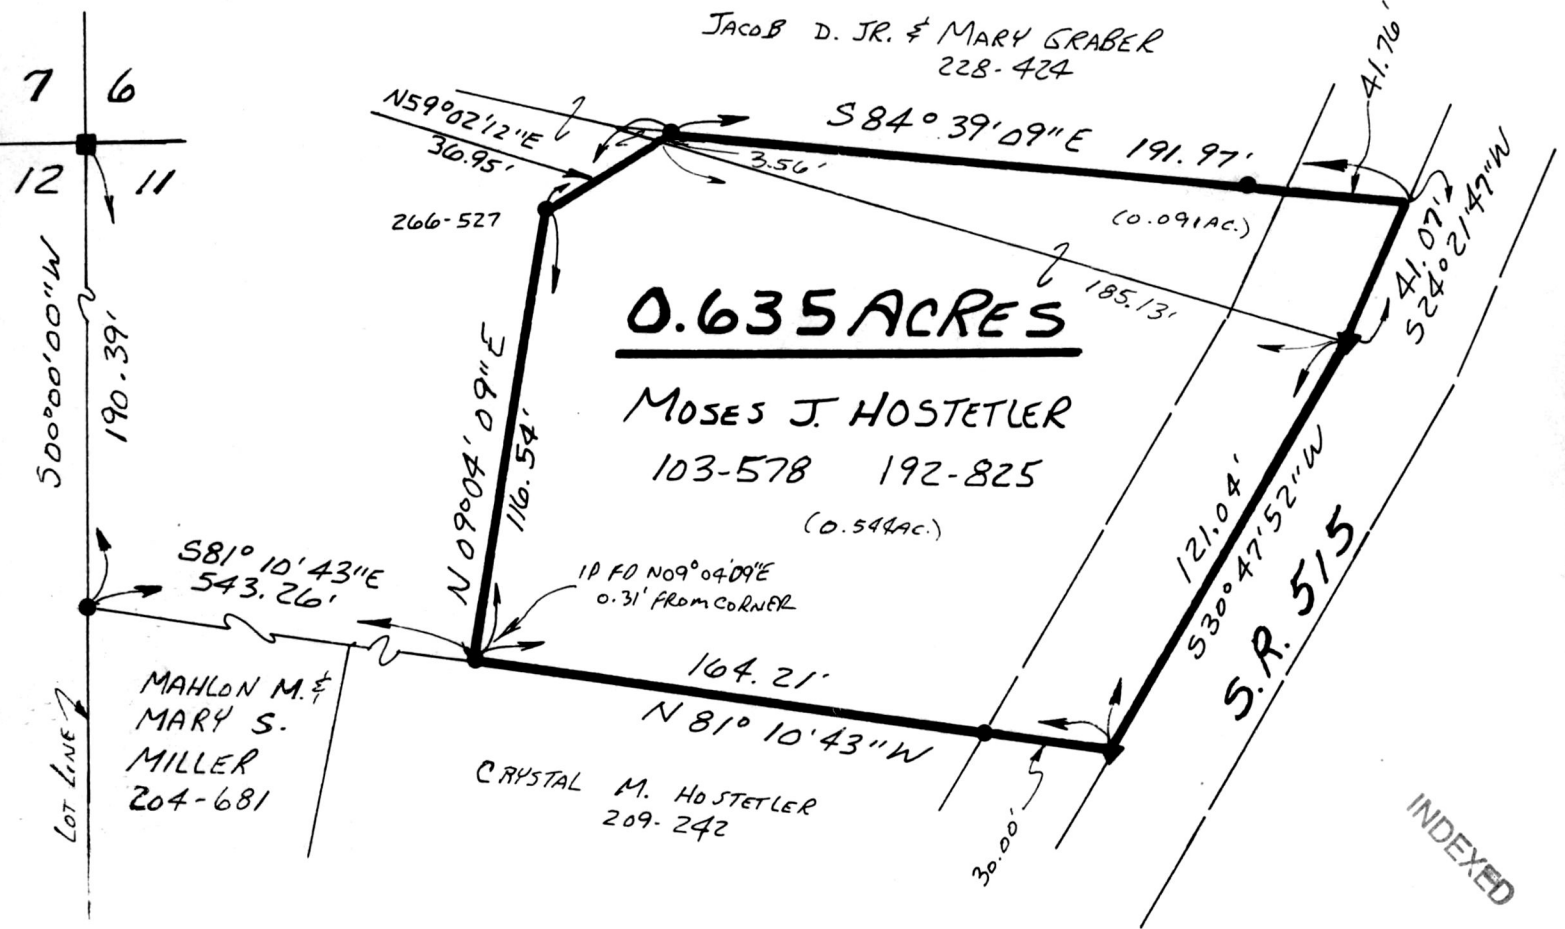

I CERTIFY THIS SURVEY TO BE CORRECT TO THE BEST OF MY KNOWLEDGE.

Donald C. Baker
DONALD C. BAKER P.S. 6938
138 N. CLAY STREET
MILLERSBURG, OHIO 44654
PH. (330) 674-4788

MARCH 27, 1997
13597-M.L. DAVIS
F.C.C. J.D. DARR

9700007343
DIANE STROMME MAST ATTY
MILLERSBURG,



9700007343
Filed for Record in
HOLMES COUNTY, OH
SALLY MILLER
On 06-04-1997 At 03:43 pm.
PLSM 20.00
Vol. 16 Page 438
DV 278 page 507

PLAT APPROVED

6/3/97

INDEXED