

SCALE: 1" = 30'

- IRON PIN FOUND
- 5/8" REBAR WITH ID. CAP SET ID. CAP MARKED "BAKER 693B"

REFERENCES:  
DEED VOL. 268 PAGE 420

VILLAGE OF NASHVILLE  
PART OF LOT 17  
WASHINGTON TOWNSHIP  
SECTION 13 T-19 N; R-15 W  
HOLMES COUNTY, OHIO

SURVEYED FOR LUTHER LAHM

9700007532  
Filed for Record in  
HOLMES COUNTY, OH  
SALLY MILLER  
On 06-16-1997 At 09:50 am.  
PLSM 20.00  
Vol. 16 Page 451  
Of 278 page 654

INDEXED




I CERTIFY THIS SURVEY TO BE CORRECT  
TO THE BEST OF MY KNOWLEDGE.

*Donald C. Baker*

DONALD C. BAKER P.S. 693B  
138 N. CLAY ST.  
MILLERSBURG, OHIO 44654  
PH. (330) 674-4788  
MAY 27, 1997

33297-SRU  
F.C.C. J.D. DARR

9700007532  
ROBERT RINFRET ATTY  
MILLERSBURG,

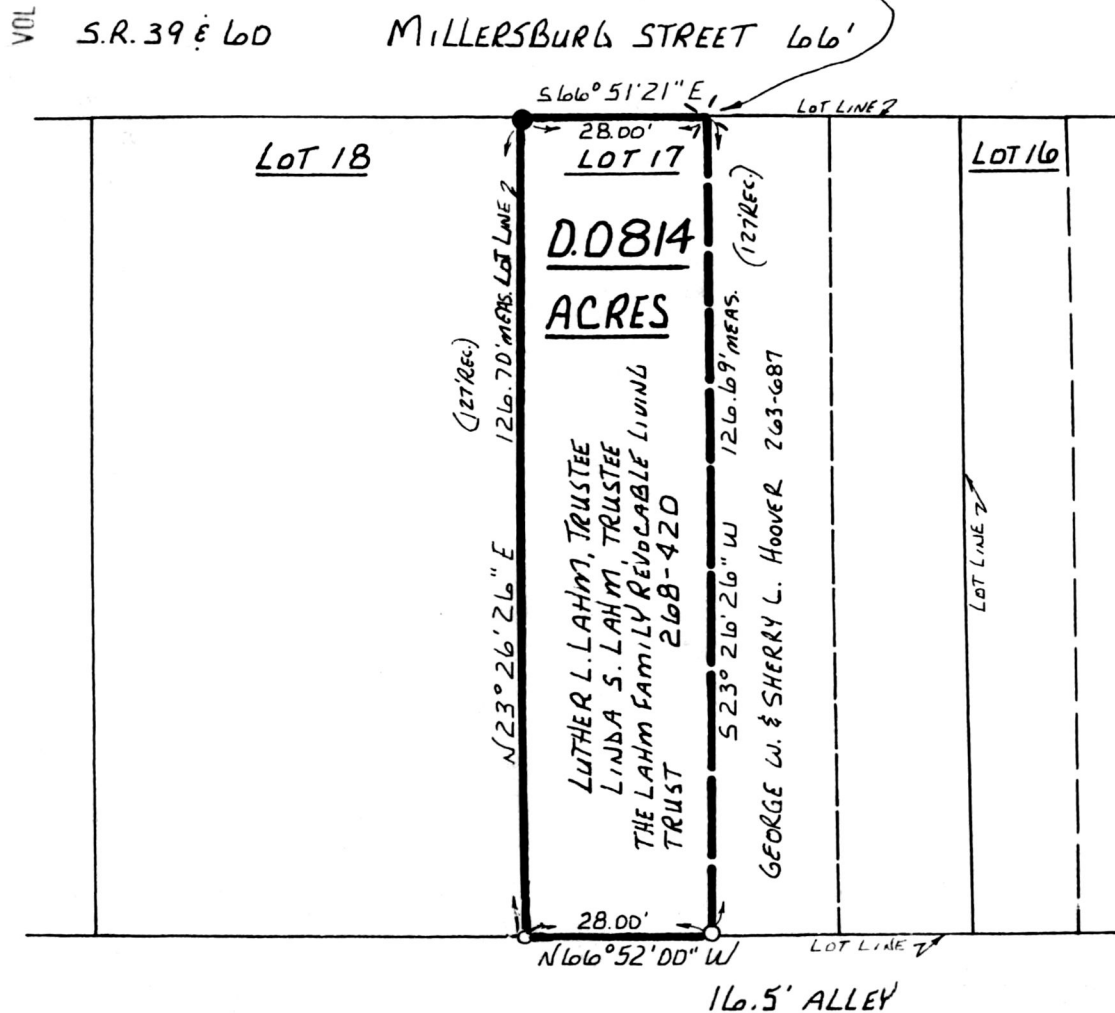

"X" SET ON STONE