


WASHINGTON TOWNSHIP
N.W. QTR. SECTION 14
T-19N; R-15W
HOLMES COUNTY, OHIO

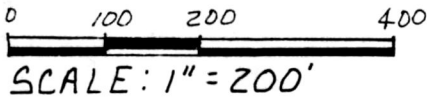

REFERENCES:


DEED VOL. 157 PAGE 49
" " 252 " 196

● IRON PIN FOUND
0.5/8" REBAR WITH I.D. CAPSET
I.D. CAP MARKED "BAKER 6938"

SURVEYED FOR WILLIAM TAILLON

9700009174
Filed for Record in
HOLMES COUNTY, OH
SALLY MILLER
On 09-24-1997 At 10:14 am.
SMALL PLAT 20.00
Vol. 16 Pg. 538 - 538
of 380 pg 79

9700009174
PREFERRED TITLE
CANTON, OH

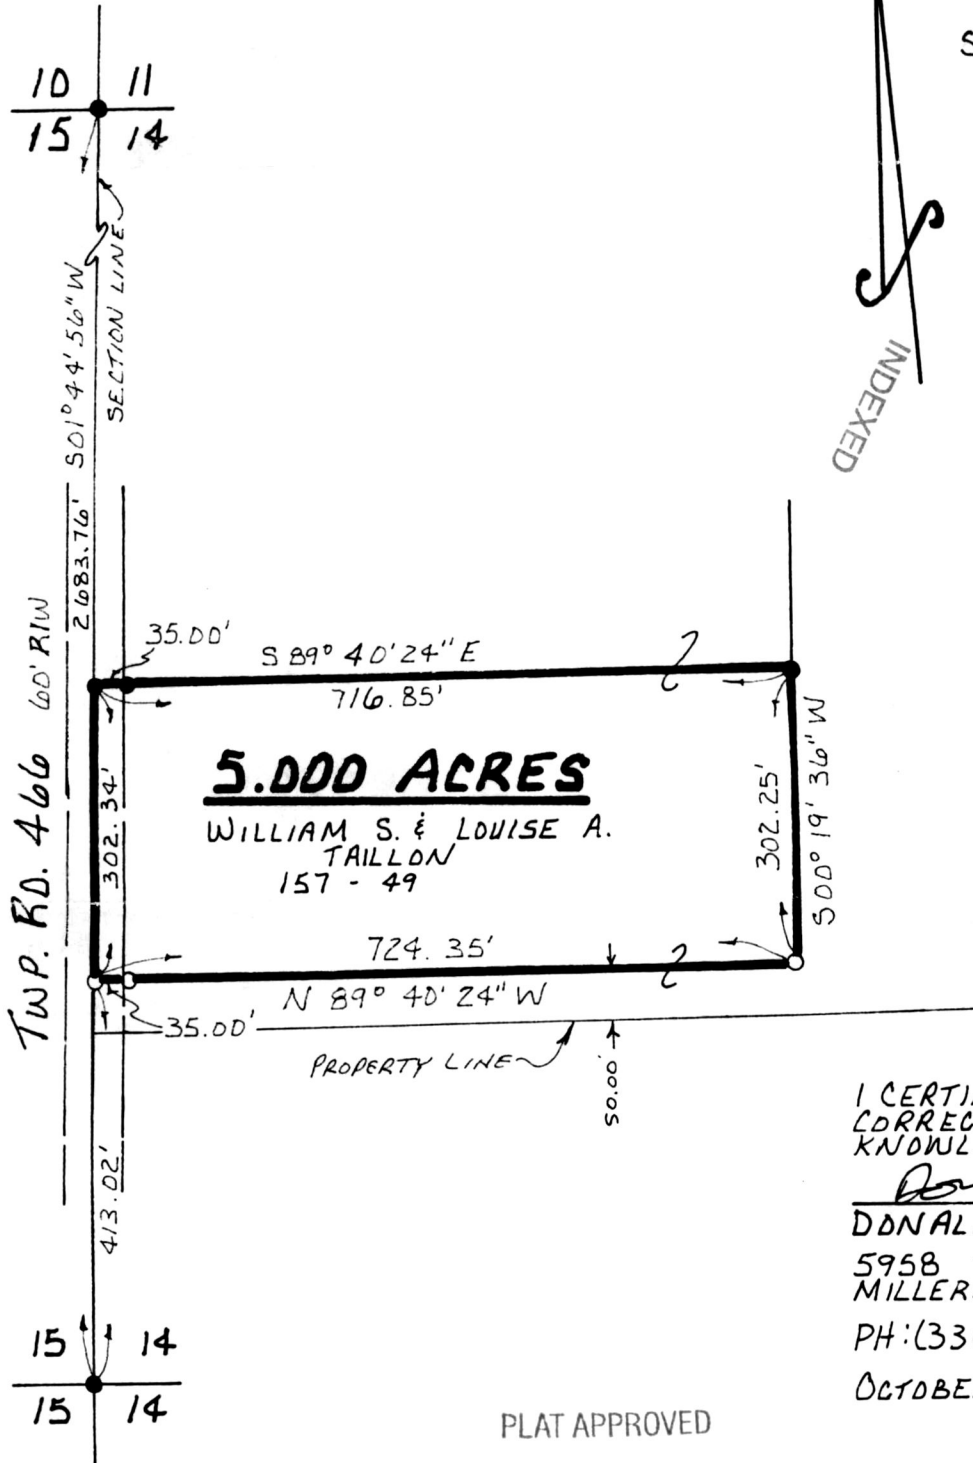

I CERTIFY THIS SURVEY TO BE
CORRECT TO THE BEST OF MY
KNOWLEDGE.

Donald C. Baker
DONALD C. BAKER P.S. 6938

5958 T.R. 322
MILLERSBURG, OHIO 44654

PH: (330) 674-4788

OCTOBER 30, 1996

PLAT APPROVED

9/22/97

66096 FJM