


PLAT OF CORRECTION TO  
CORRECT THE ROAD  
RIGHT-OF-WAY TO  
EXISTING ROAD AS  
CONSTRUCTED.

PAINT TOWNSHIP  
4TH. QTR., LOT 29  
T-10N; R-5W  
HOLMES COUNTY, OHIO

(SURVEYED FOR: TIMBERSTONE, LTD.)

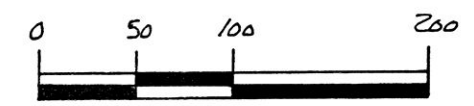

SCALE: 1"=100'

- STONE FOUND
- IRON PIN FOUND
- 5/8" RE BAR WITH I.D. CAP SET  
I.D. CAP MARKED "BAKER 6938"

INDEXED

REFERENCES:

DEED VOL. 276 PAGE 649  
" " 270 " 164  
" " 249 " 463

9700010130  
Filed for Record in  
HOLMES COUNTY, OH  
SALLY MILLER  
On 11-21-1997 At 10:54 am.  
CNTY SM PLT .00  
Vol. 16 Pg. 586 - 586  
OV 281 pg 489

PLAT VOL. 2 PAGE 224  
" " 15 " 114  
" " 13 " 179  
" " 13 " 197  
" " 10 " 58  
" " 10 " 319

BEARINGS FROM DEED VOL. 276 PAGE 649



I CERTIFY THIS SURVEY TO BE CORRECT  
TO THE BEST OF MY KNOWLEDGE.

Donald C. Baker  
DONALD C. BAKER P.S. 6938  
138 N. CLAY ST.  
MILLERSBURG, OHIO 44654  
PH. (330) 674-4788  
NOVEMBER 14, 1997  
#65797(B)-M.L. DAVIS  
F.C.C.-D.C. BAKER

1.912 ACRES

Δ-33°53'54"  
R-275.00'  
ARC-162.70'  
T-83.81'  
CH-160.34'  
BRG-S 55° 05' 33" E

Δ-33°53'54"  
R-325.00'  
ARC-192.28'  
T-99.05'  
CH-189.49'  
BRG-N 55° 05' 33" W

Δ-33°53'54"  
R-275.00'  
ARC-162.70'  
T-83.81'  
CH-160.34'  
BRG-S 55° 05' 33" E

Δ-44°00'03"  
R-60.00'  
ARC-46.08'  
T-24.24'  
CH-44.95'  
BRG-N 56° 02' 30" W

Δ-90°00'00"  
R-88.00'  
ARC-138.23'  
T-88.00'  
CH-124.45'  
BRG-S 27° 02' 30" E

Δ-134°00'00"  
R-88.00'  
ARC-205.81'  
T-207.32'  
CH-162.01'  
BRG-S 84° 57' 30" W

970231  
APPROVED FOR TRANSFER ONLY  
NO SUBDIVISION PLAT REQUIRED  
(O.R.C. 711.001 & 711.131)  
Lot(s) not for building unless  
approved by Board of Health.  
HOLMES CO. PLANNING COMM.  
By com Date 11/20/97

9700010130  
LAUREL SCHMID ATTY  
MILLERSBURG,

PLAT APPROVED  
11-20-97