


VILLAGE OF MILLERSBURG

HARDY TOWNSHIP
 S.W. QTR. SECTION 11
 T-9N; R-7W
 HOLMES COUNTY, OHIO
 (SURVEYED FOR: RANDY & DEBORAH AKINS)

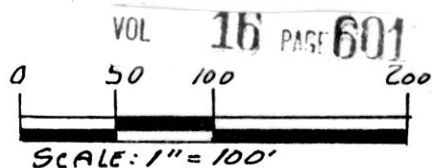

- HIGHWAY MONUMENT FOUND
- IRON PIN FOUND
- ▲ R.R. SPIKE FOUND

REFERENCES:



DEED VOL. 218 PAGE 414
" " 192 " 746
" " 229 " 200
" " 103 " 1
" " 100 " 457
" " 154 " 99
" " 151 " 350

PLAT VOL. 2 PAGE 38
" " 8 " 209
" " 8 " 445
" " 15 " 93
" " 7 " 549

SURVEY RECORD 5 PAGE 124

9700010467
 Filed for Record in
 HOLMES COUNTY, OH
 SALLY MILLER
 On 12-12-1997 At 12:47 pm.
 SMALL PLAT 20.00
 Vol. 16 Pg. 601 - 601
 DV 201-821

INDEXED

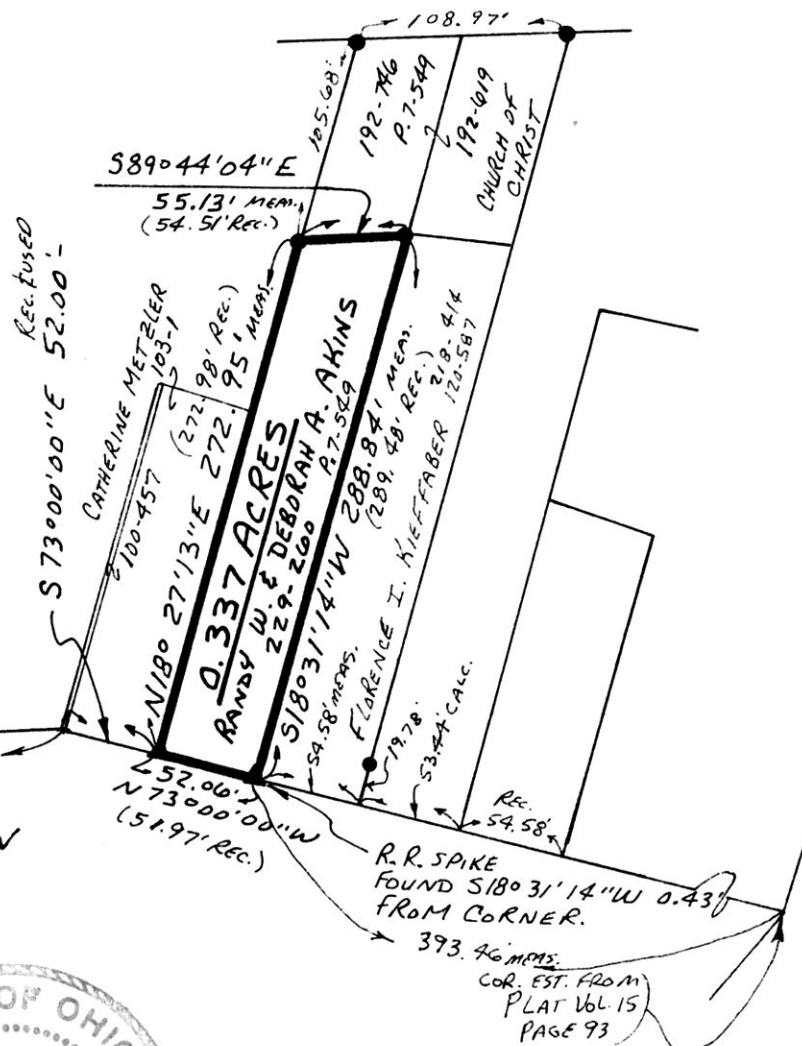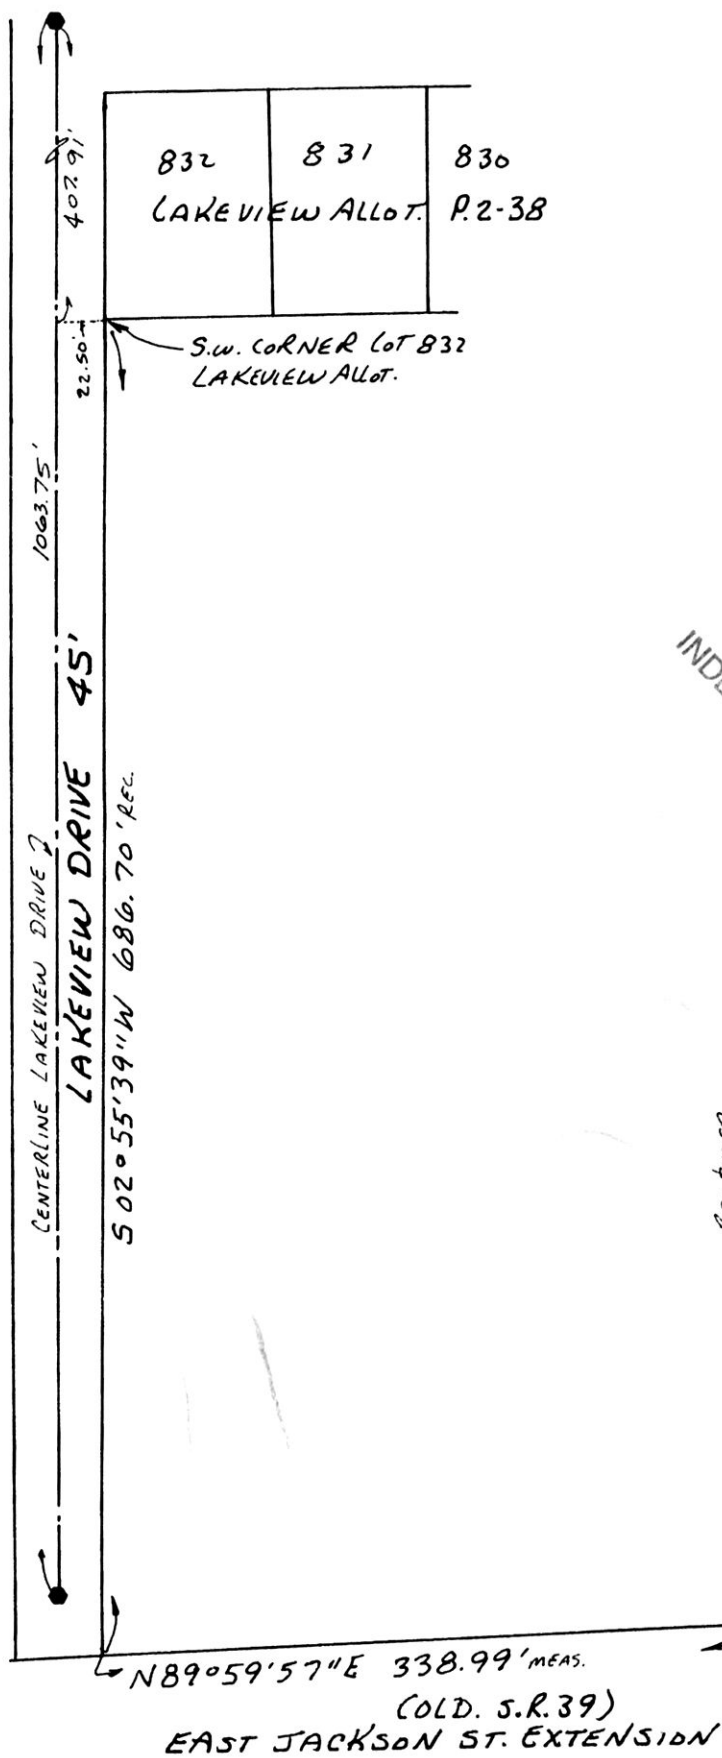

I CERTIFY THIS SURVEY TO BE CORRECT TO THE BEST OF MY KNOWLEDGE.

Donald C. Baker
 DONALD C. BAKER P.S. 6938
 138 N. CLAY ST.
 MILLERSBURG, OHIO 44654
 PH. (330) 674-4788
 DECEMBER 5, 1997

72997 - M.L. DAVIS
 F.C.C. - J.D. DARR
 D.C. BAKER



9700010467
 MIDLAND TITLE
 2416 LEXINGTON AVE
 LEXINGTON AVE
 MANSFIELD, OH 44907

PLAT APPROVED

12/11/1997