


VILLAGE OF WALNUT CREEK  
OUT LOTS 9 & 10

WALNUT CREEK TOWNSHIP  
S.W. QTR. SECTION 20  
T-9N; R-5W  
HOLMES COUNTY, OHIO

(SURVEYED FOR: ALAN & MONIKA C. ZINCK)

9800000440  
Filed for Record in  
HOLMES COUNTY, OH  
SALLY MILLER  
On 01-29-1998 At 03:04 pm.  
SMALL PLAT 20.00  
Book OR Vol. 16 Pg. 645 - 645  
OR 2 Pg. 525

INDEXED

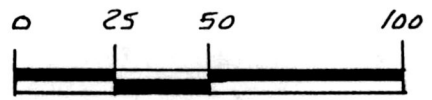


SCALE: 1" = 50'


- ▲ R.R. SPIKE FOUND
- IRON PIN FOUND
- △ R.R. SPIKE SET
- 5/8" REBAR WITH I.D. CAP SET  
I.D. CAP MARKED "BAKER 6938"

REFERENCES:

- DEED Vol. 253 PAGE 304
- " " 268 " 1005
- " " 273 " 972
- " " 256 " 652
- " " 258 " 419
- PLAT Vol. 12 PAGE 954
- " " 13 " 130
- " " 14 " 127

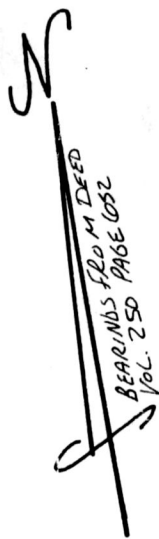

VOL. 16 PAGE 645

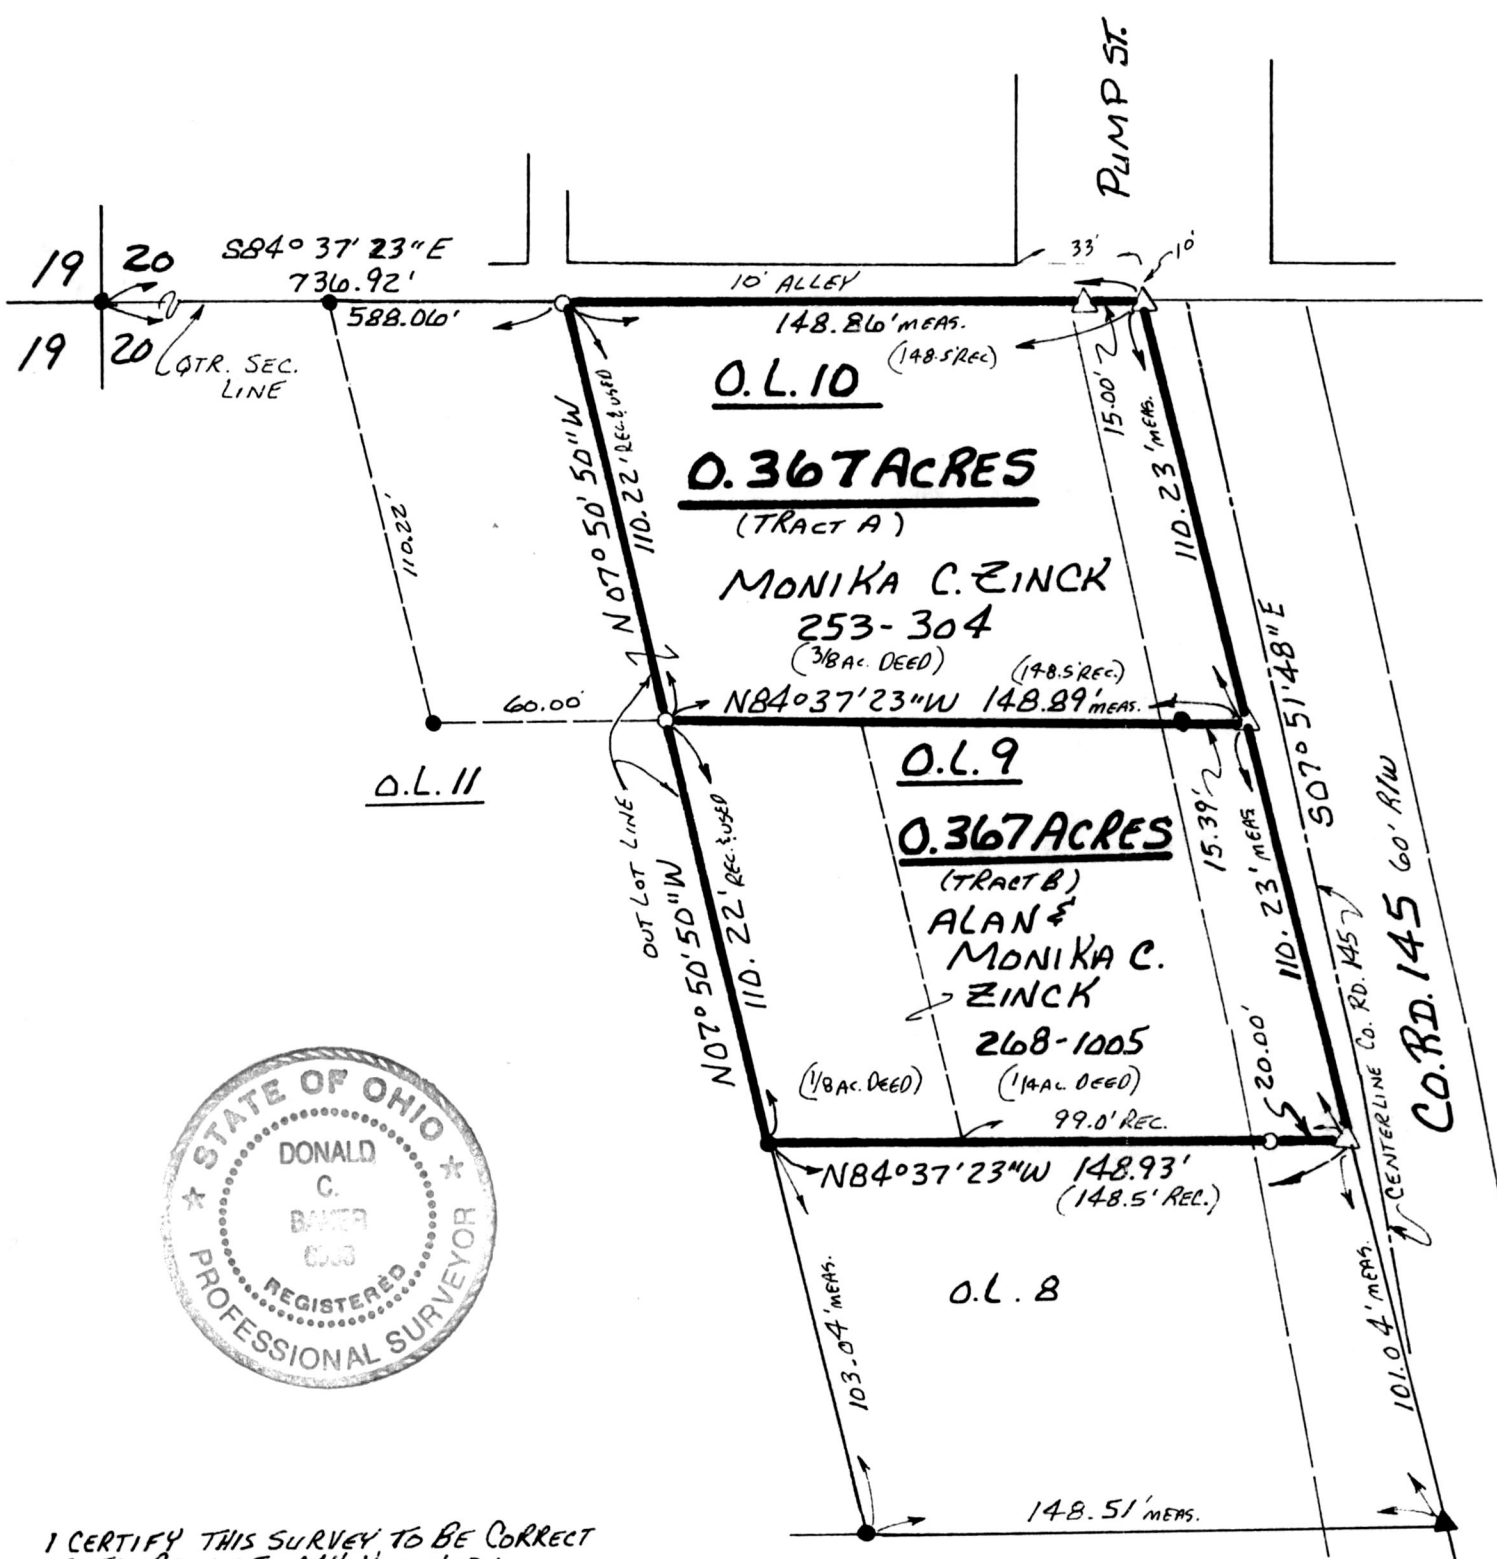

I CERTIFY THIS SURVEY TO BE CORRECT TO THE BEST OF MY KNOWLEDGE.

Donald C. Baker  
DONALD C. BAKER P.S. 6938  
138 N. CLAY ST.  
MILLERSBURG, OHIO 44654  
PH. (330) 674-4788  
JANUARY 19, 1998  
#898 - M.L. DAVIS  
F.C.C. - F.D. BAKER

9800000440  
DIANE STROMME MAST ATTY  
MILLERSBURG,

PLAT APPROVED  
1/29/98