

- ▲ R.R. SPIKE FOUND
- IRON PIN FOUND
- 5/8" RE BAR WITH I.D. CAPSET  
I.D. CAP MARKED "BAKER 6938"

REFERENCES:


DEED VOL. 235 PAGE 355  
 DEED VOL. 232 PAGE 242  
 DEED VOL. 181 PAGE 674  
 PLAT VOL. 10 PAGE 602

BEARINGS FROM PLAT VOL. 10 PAGE 871

PRAIRIE TOWNSHIP  
 S.W. QTR. SECTION 34  
 T-14N; R-13W  
 HOLMES COUNTY, OHIO


9800000527  
 Filed for Record in  
 HOLMES COUNTY, OH  
 SALLY MILLER  
 On 02-05-1998 At 03:40 pm.  
 SMALL PLAT 20.00  
 Book OR Vol. 16 Pg. 648 - 648  
 or vol 2 pg 854

INDEXED

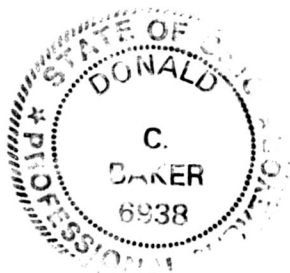

ROY A. & BARBARA MILLER  
 233-139 & 143

THE FLUOROCARBON COMPANY  
 235-355

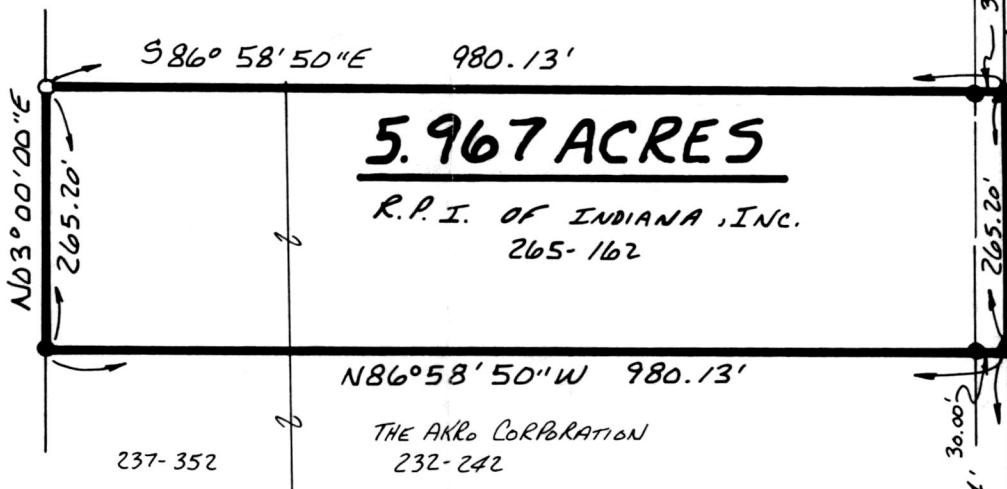

**5.967 ACRES**

R.P.I. OF INDIANA, INC.  
 265-162

N86°58'50"W 980.13'

THE AKKO CORPORATION  
 232-242

237-352

I CERTIFY THIS SURVEY TO BE CORRECT  
 TO THE BEST OF MY KNOWLEDGE.

Donald C. Baker  
 DONALD C. BAKER P.S. 6938  
 5958 T.R. 322  
 MILLERSBURG, OHIO 44654  
 PH. (216) 674-4788

9800000527  
 DANIEL MATHIE ATTY  
 MILLERSBURG,

SEPTEMBER 9, 1994

50994-MLS

PLAT APPROVED

2/5/98 B

34  
 3

34  
 3