

REFERENCES:

DEED Vol. 257 PAGE 338

" " 273 " 407

PLAT Vol. 8 PAGE 553

RIPLEY TOWNSHIP

N.E. QTR. SECTION 6

T-17N; R-14W

HOLMES COUNTY, OHIO

(SURVEYED FOR: ADEN HERSHBERGER)




SCALE: 1" = 200'

- IRON PIN FOUND
- 5/8" RE BAR WITH I.D. CAP SET  
I.D. CAP MARKED "BAKER 6938"

N  
INDEXED  
S

9800000637  
 Filed for Record in  
 HOLMES COUNTY, OH  
 SALLY MILLER  
 On 02-12-1998 At 10:42 am.  
 SMALL PLAT 20.00  
 Book OR Vol. 16 Pg. 652 - 653  
 or vol 3 pg 223

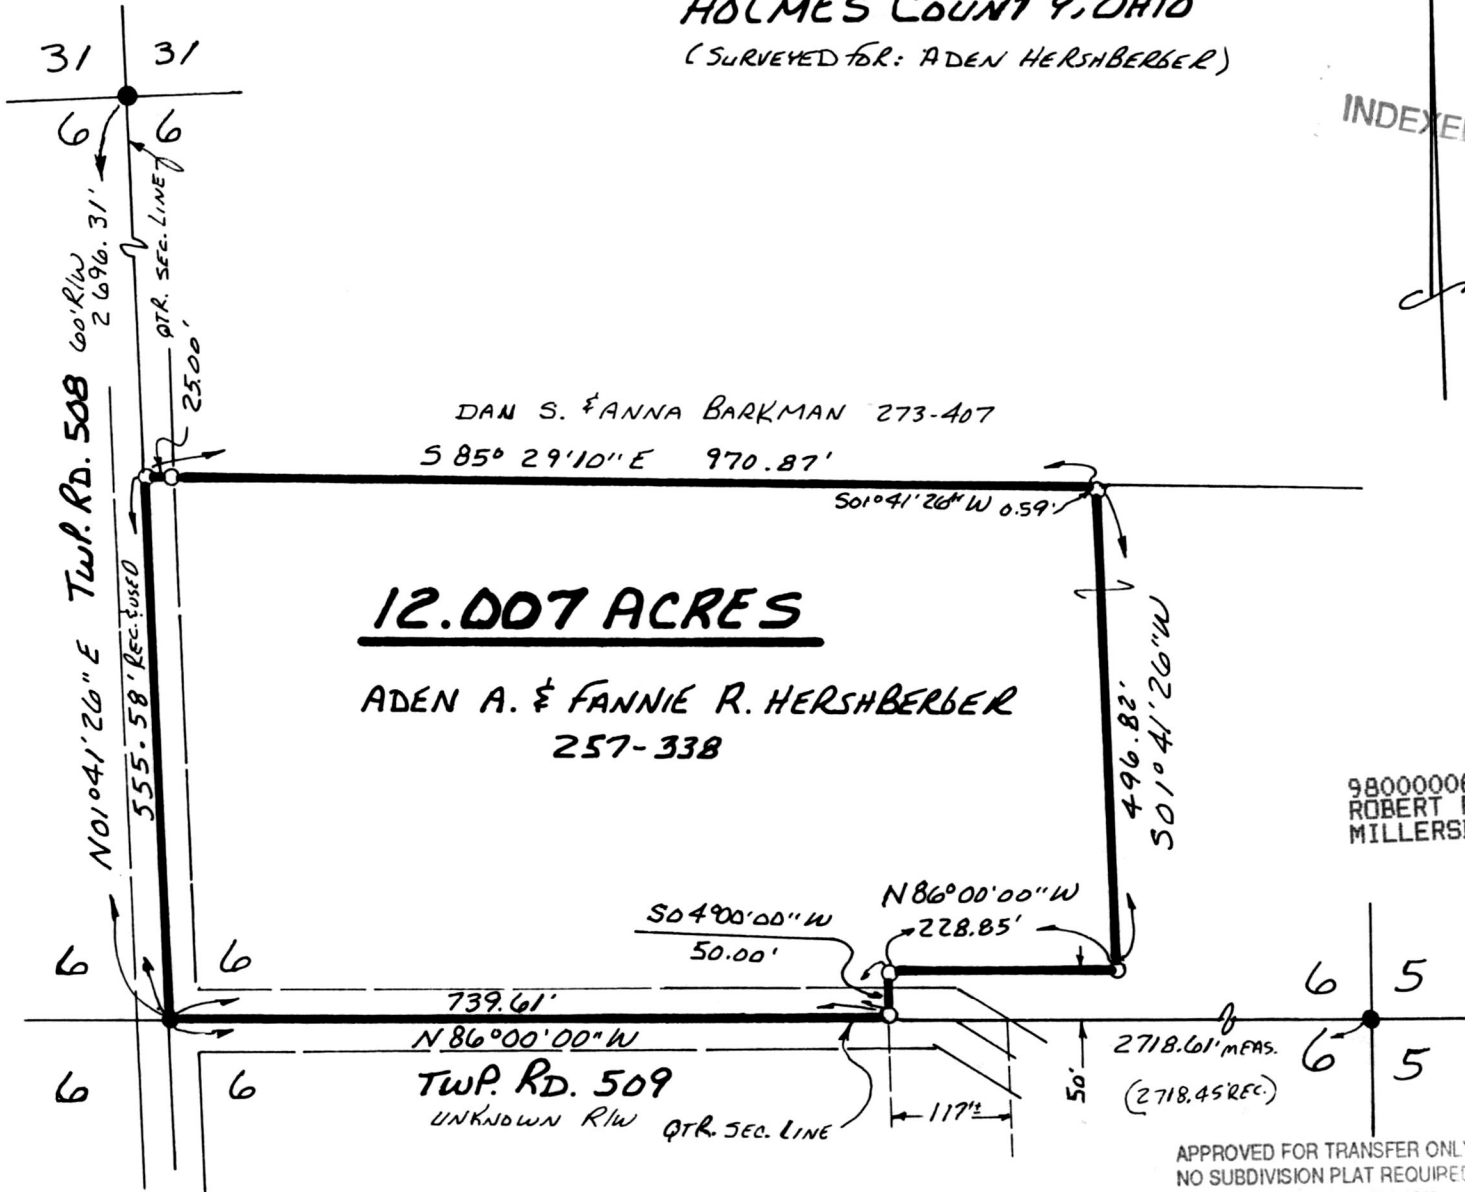

**12.007 ACRES**

ADEN A. & FANNIE R. HERSHBERGER  
257-338

DAN S. & ANNA BARKMAN 273-407

S 85° 29' 10" E 970.87'

S 01° 41' 26" W 0.59'

496.82'  
S 01° 41' 26" W

N 86° 00' 00" W  
228.85'

S 04° 00' 00" W  
50.00'

739.61'  
N 86° 00' 00" W

TWP. RD. 509  
UNKNOWN RLW

QTR. SEC. LINE

2718.61' MEAS.  
(2718.45' REC.)

PLAT APPROVED

2/10/98

APPROVED FOR TRANSFER ONLY  
 NO SUBDIVISION PLAT REQUIRED  
 (O.R.C. 711.001 & 711.131)  
 Lot(s) not for building unless  
 approved by Board of Health,  
 HOLMES CO. PLANNING COMM.

By Adj Date 2-10-98  
 980023



9800000637  
 ROBERT RINFRET ATTY  
 MILLERSBURG,

I CERTIFY THIS SURVEY TO BE  
 CORRECT TO THE BEST OF MY  
 KNOWLEDGE.

Donald C. Baker  
 DONALD C. BAKER P.S. 6938  
 138 N. CLAY ST.  
 MILLERSBURG, OHIO 44654  
 PH. (336) 674-4788

FEBRUARY 21, 1998

#6998 - M.L. DAVIS  
 F.C.C. - F.D. BAKER

VOL 16 PAGE 652