



RESURVEY OF A 0.5 AC. PARCEL DESCRIBED
IN DEED VOL. 242 PAGE 67

RICHLAND TOWNSHIP
N.E. QTR. SECTION 21
T-8N; R-9W
HOLMES COUNTY, OHIO

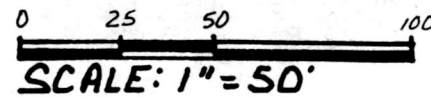

■ STONE FOUND
△ R.R. SPIKE SET
○ 5/8" REBAR WITH I.D. CAP SET
I.D. CAP MARKED "BAKER 6938"

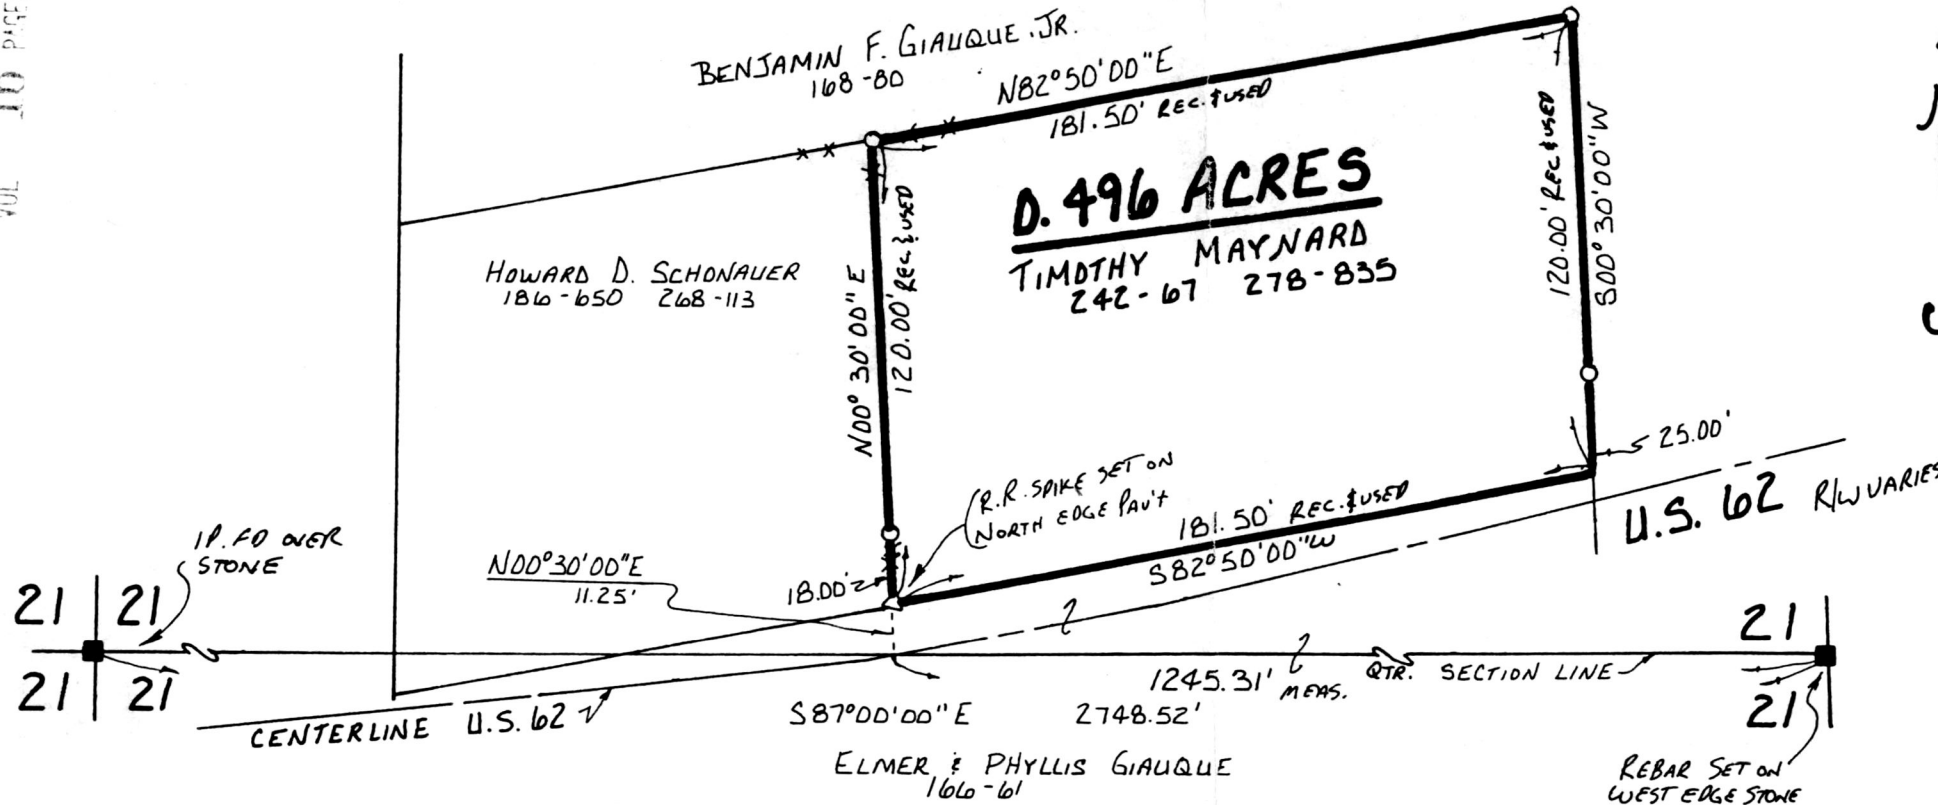

REFERENCES:

DEED VOL. 168	PAGE 80
" " 186	" 650
" " 242	" 67
" " 278	" 835
" " 166	" 61

9800001261
Filed for Record in
HOLMES COUNTY, OH
SALLY MILLER
On 03-23-1998 At 03:39 PM.
SMALL PLAT 20.00
Book OR Vol. 16 Pg. 674 - 674
OR vol 5 pg 511

INDEXED

SURVEYED FOR RICHARD KRANZ

9800001261
JEFFREY MULLEN ATTY
MILLERSBURG,

PLAT APPROVED

2/19/98-B

I CERTIFY THIS SURVEY TO BE CORRECT TO THE
BEST OF MY KNOWLEDGE.

Donald C Baker
DONALD C. BAKER P.S. 6938
138 N. CLAY ST.
MILLERSBURG, OHIO 44654
PH: (330) 674-4788
AUGUST 5, 1997

45997 FJM
F.C.C. - D.C. BAKER