
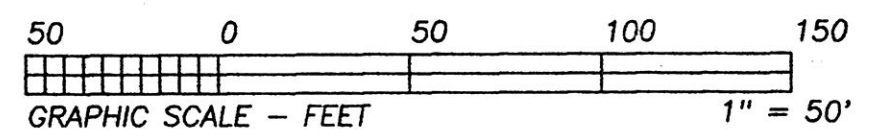


VOL 16 pg 819

0.074  
ACRE

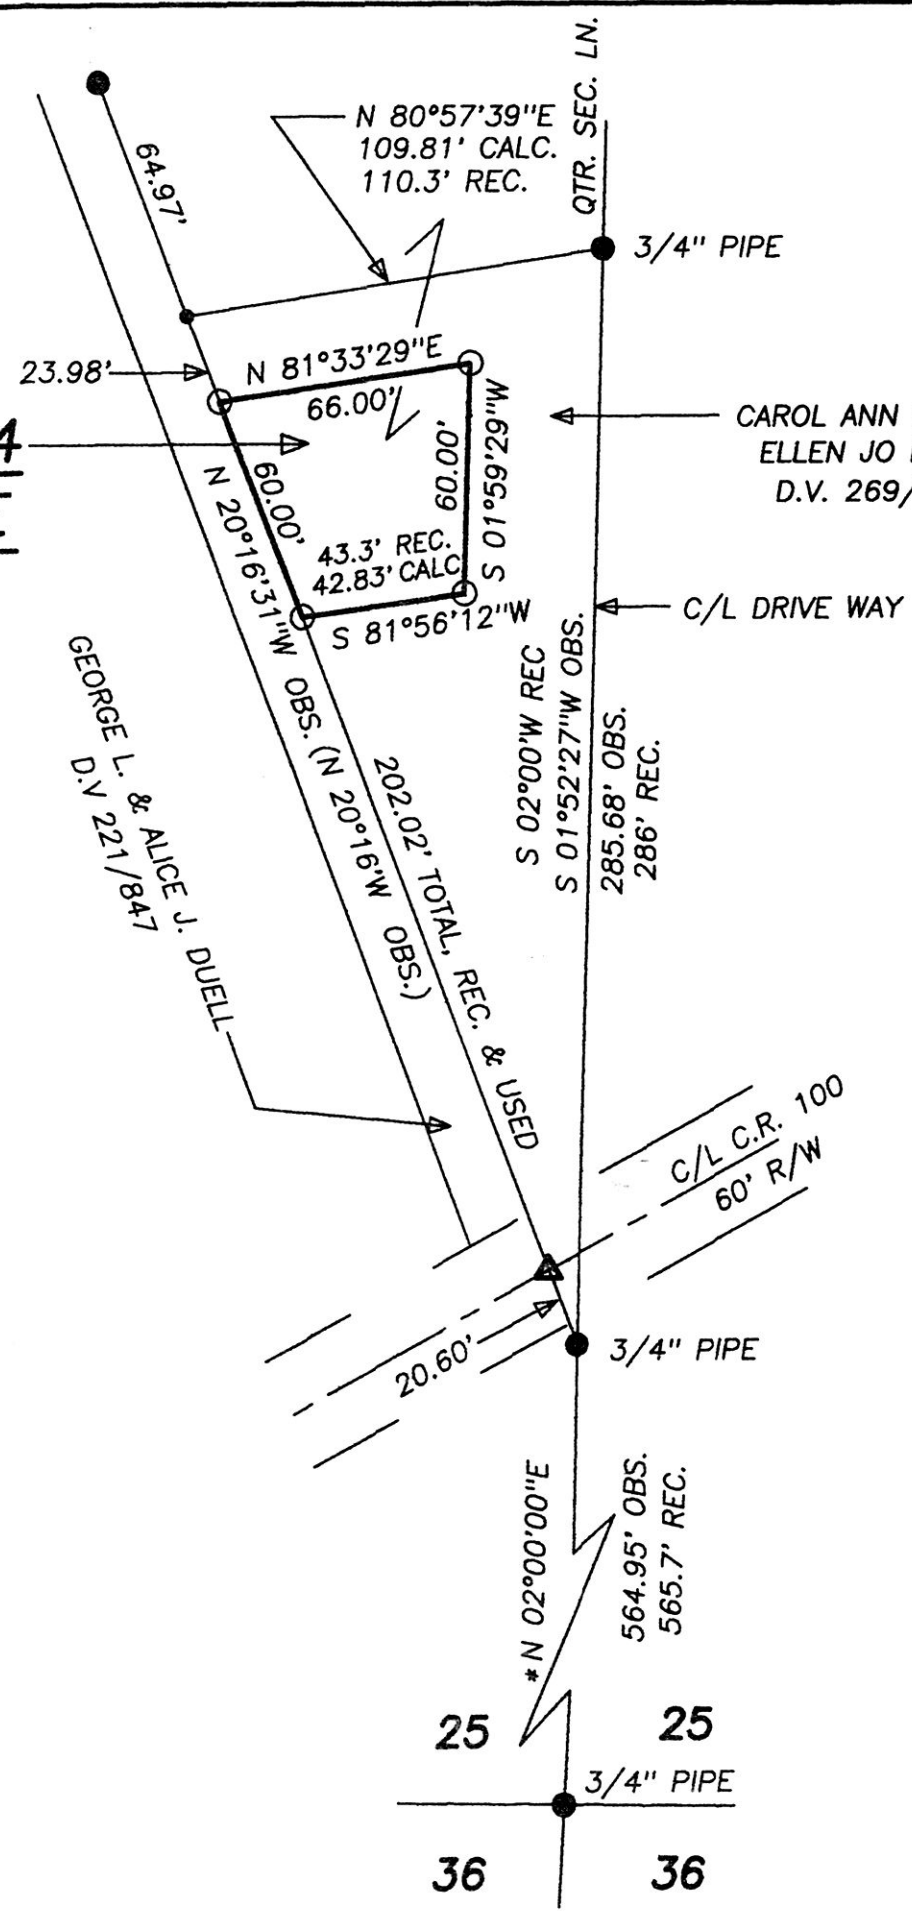

\* BEARINGS EST. FROM D.V.  
269/922 AND ARE TO DENOTE  
ANGULAR MEAS. ONLY.

9800003686  
Filed for Record in  
HOLMES COUNTY, OH  
SALLY MILLER  
On 08-06-1998 At 01:45 pm.  
SMALL PLAT 20.00  
Book OR Vol. 16 Pg. 819 - 819  
OR vol. 14 pg 47

- LEGEND:
- = STONE FD.
  - = 5/8" RE-BAR FD. UNLESS NOTED
  - = POINT-OF-DEPARTURE
  - = 5/8" X 30" RE-BAR  
W/PLASTIC I.D. CAP SET
  - ⊗ = R/R SPIKE SET
  - △ = R/R SPIKE FD.

INDEXED

REFERENCE DOCUMENTS:  
TAX MAPS  
DEEDS AS SHOWN  
SURVEY PLATS: 5/36

PLAT APPROVED  
8/5/98

I CERTIFY THIS PLAT & SURVEY TO BE CORRECT TO THE BEST  
OF MY KNOWLEDGE:

9800003686  
JOHN BARRINGTON ATTY  
WOOSTER, OH

*J. Shamp*

JULY 30, 1998

JIM SHAMP, REG. SUR. NO. S-6088 DATE



## HEARTLAND SURVEYING, INC

Jim Shamp  
5210 T.R. 257 MILLERSBURG, OH 44654  
PH: 330-674-4698

SURVEY CAROL ANN DAWSON & ELLEN JO DUDLEY		STATE OHIO	
COUNTY HOLMES	TWP. WASHINGTON	RNG. 15 W	TWP. 20 N
S.W. QUARTER OF SECTION 25		6/98 980731	