

**REFERENCES:**

DEED VOL. 260 PAGE 409  
 " " 264 " 636  
 " " 269 " 240  
 " " 275 " 855  
 " " 244 " 160


PLAT VOL. 14 PAGE 841  
 " " 10 " 260  
 " " 14 " 710  
 " " 14 " 765  
 " " 16 " 60  
 " " 14 " 241  
 " " 14 " 522

**MECHANIC TOWNSHIP  
 N.E. QTR. FRACTIONAL SEC. 8  
 2ND. QTR. PART OF LOTS 4, 5 & 6  
 T-8N; R-16W  
 HOLMES COUNTY, OHIO**

0 100 200 400  
**SCALE: 1" = 200'**

● IRON PIN FOUND  
 ○ 5/8" REBAR WITH I.D. CAP SET  
 I.D. CAP MARKED "BAKER 6938"

9800003909  
 Filed for Record in  
 HOLMES COUNTY, OH  
 SALLY MILLER  
 On 08-18-1998 At 03:24 PM.  
 SMALL PLAT 20.00  
 Book OR Vol. 16 Pg. 828 - 828  
 OR Vol. 14 pgs 897-904

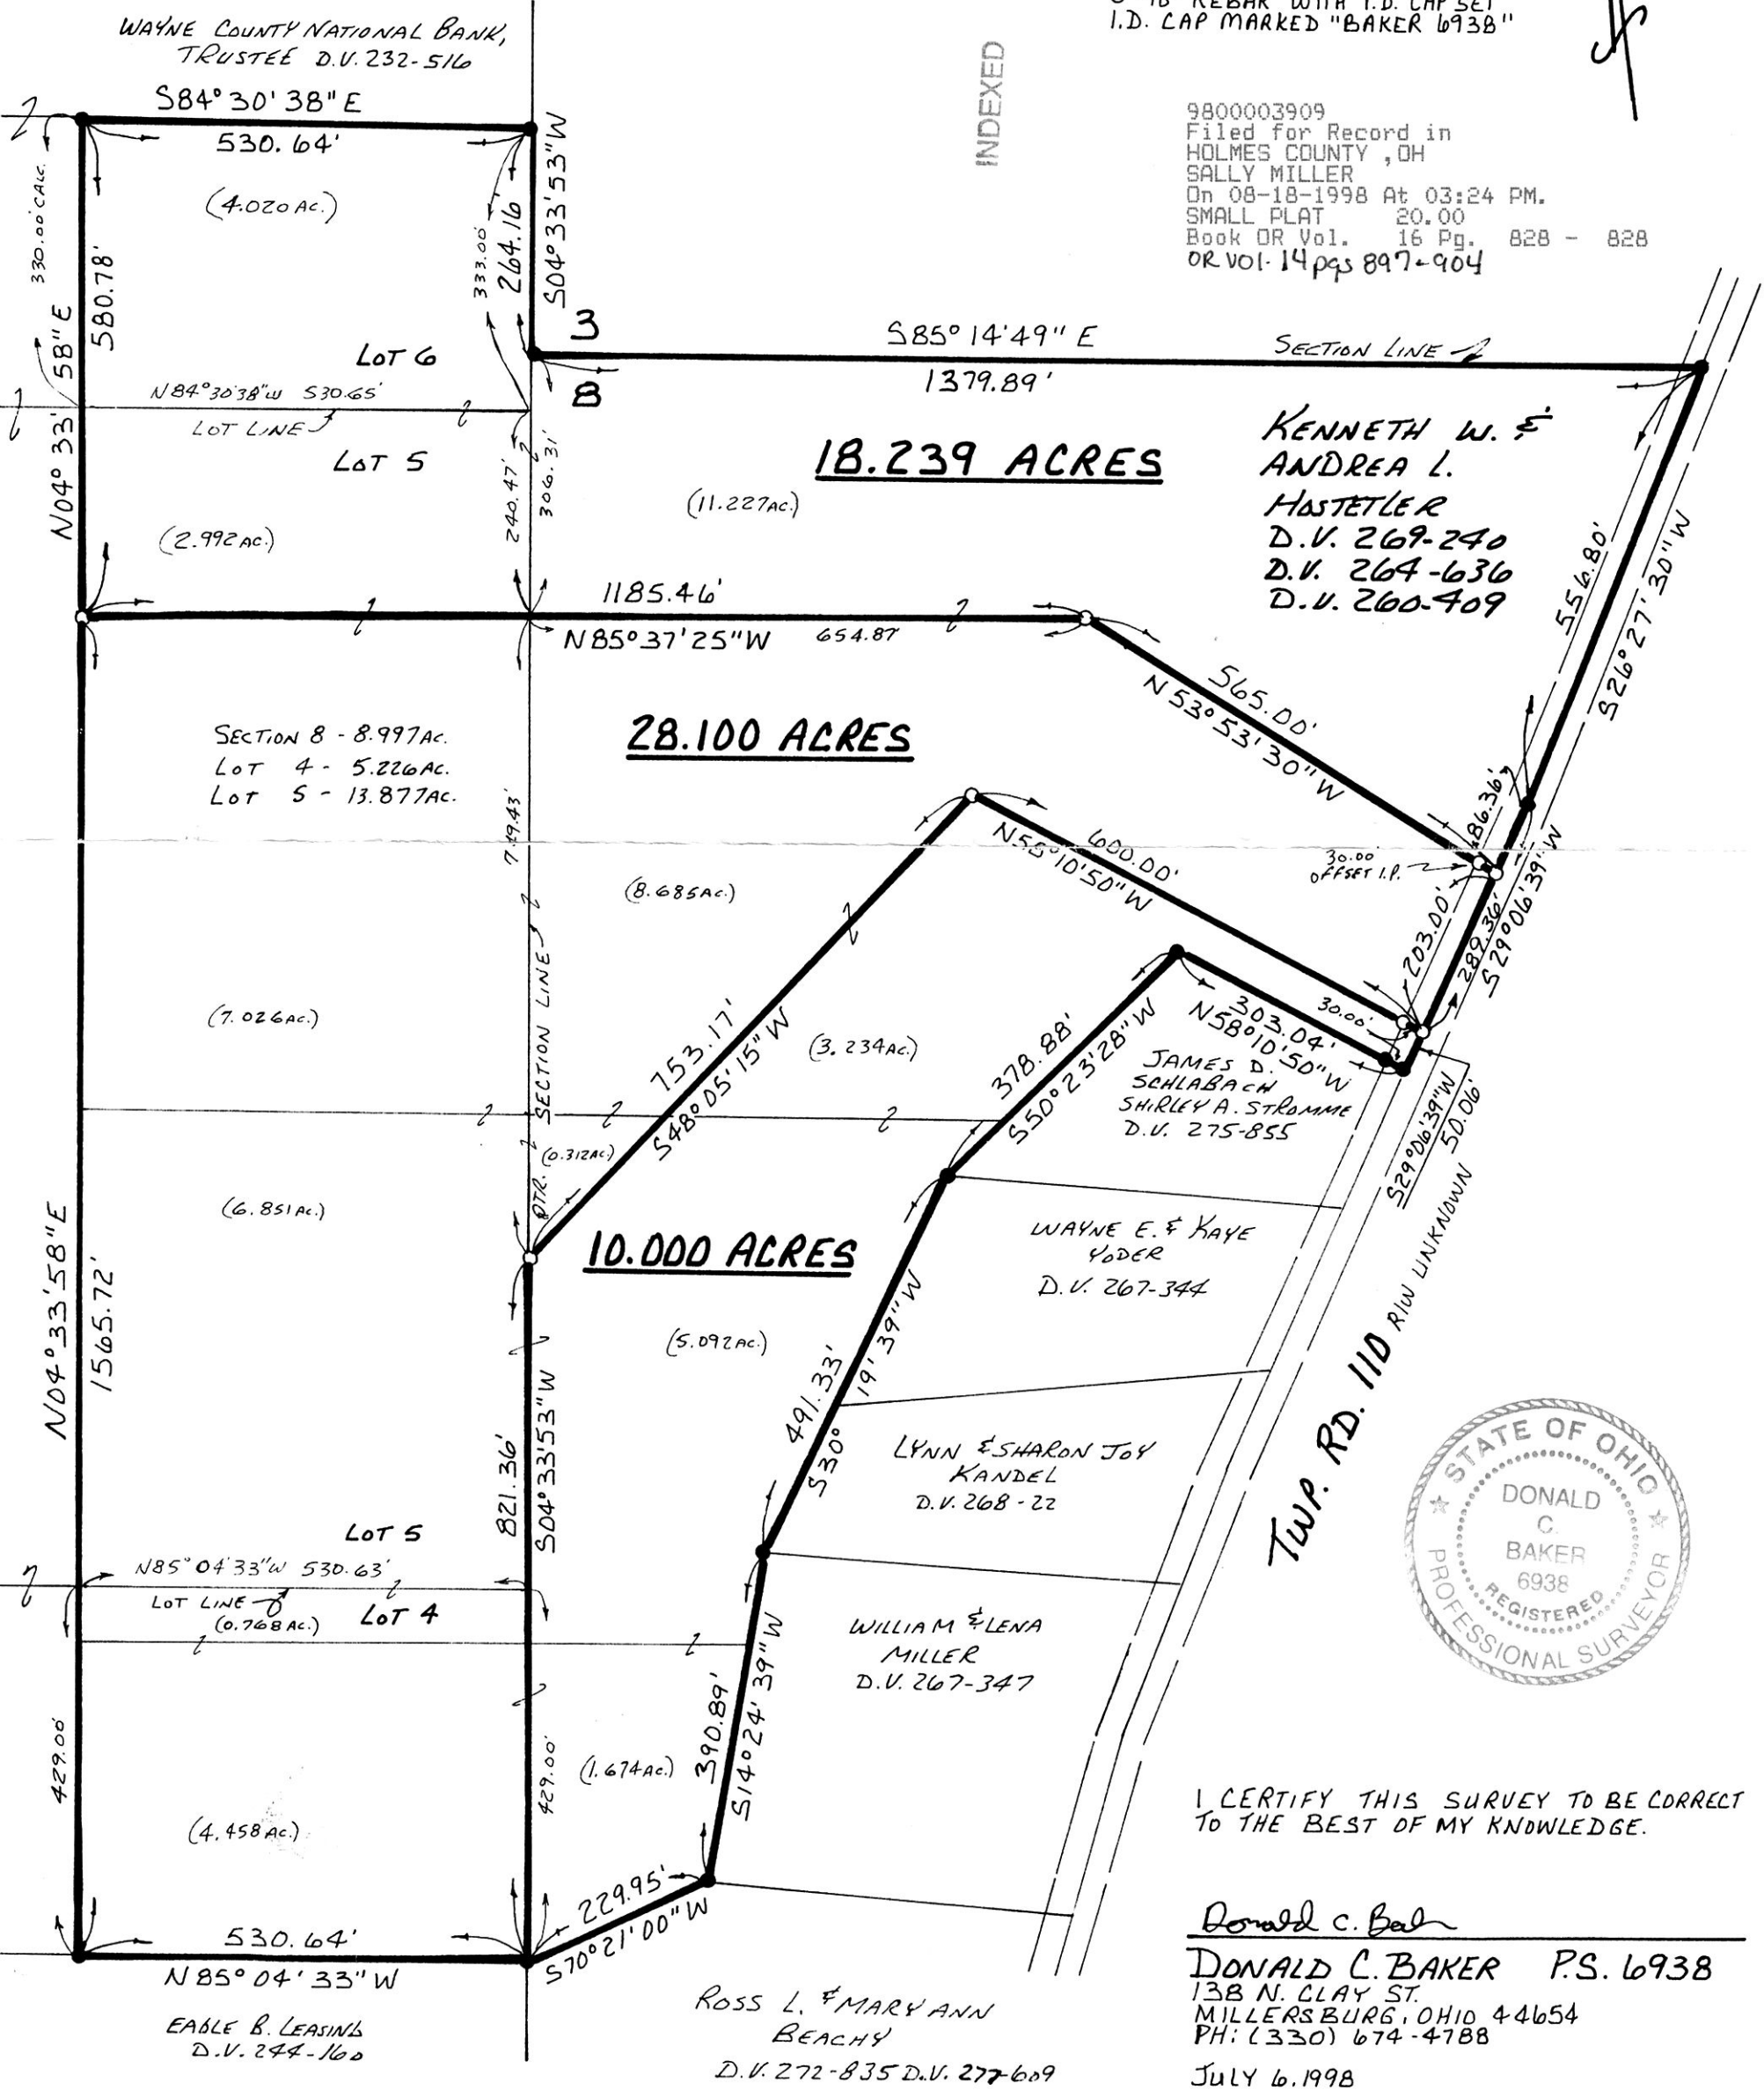

INDEXED

**KENNETH W. &  
 ANDREA L.  
 HASTETLER**  
 D.V. 269-240  
 D.V. 264-636  
 D.V. 260-409

**JAMES D. SCHLABAUGH  
 SHIRLEY A. STRAMME**  
 D.V. 275-855

**WAYNE E. & KAYE  
 YODER**  
 D.V. 267-344

**LYNN & SHARON JOY  
 KANDEL**  
 D.V. 268-22

**WILLIAM & LENA  
 MILLER**  
 D.V. 267-347

**ROSS L. & MARYANN  
 BEACHY**  
 D.V. 272-835 D.V. 277-609



I CERTIFY THIS SURVEY TO BE CORRECT TO THE BEST OF MY KNOWLEDGE.

*Donald C. Baker*  
**DONALD C. BAKER P.S. 6938**  
 138 N. CLAY ST.  
 MILLERSBURG, OHIO 44654  
 PH: (330) 674-4788  
 JULY 6, 1998

PLAT APPROVED

*8/14/98*

# 49998 - FJM  
 F.C.C. - F.D. BAKER

9800003909  
 LAUREL SCHMID ATTY  
 MILLERSBURG,