VILLAGE OF BERLIN
PART OF OUTLOT 11
T-9N ; R-5W
HOLMES COUNTY. OHIO

0 50 100 200

SCALE: 1" = 100'

BERLIN TOWNSHIP
N.E. QTR. SECTION 15

■ STONE FOUND
▲ R.R. SPIKE FOUND
● IRON PIN FOUND
○ 5/8" REBAR WITH I.D. CAP SET
I.D. CAP MARKED "BAKER 6938"

SURVEYED FOR THE MENNONITE FOUNDATION. INC.

REFERENCES:

OFFICIAL RECORD VOL. 14 PAGE 424
" " " 16 " 74
" " " 54 " 338
" " " 58 " 168

DEED VOL. 258 PAGE 355
" " 203 " 654
" " 273 " 199
" " 252 " 133

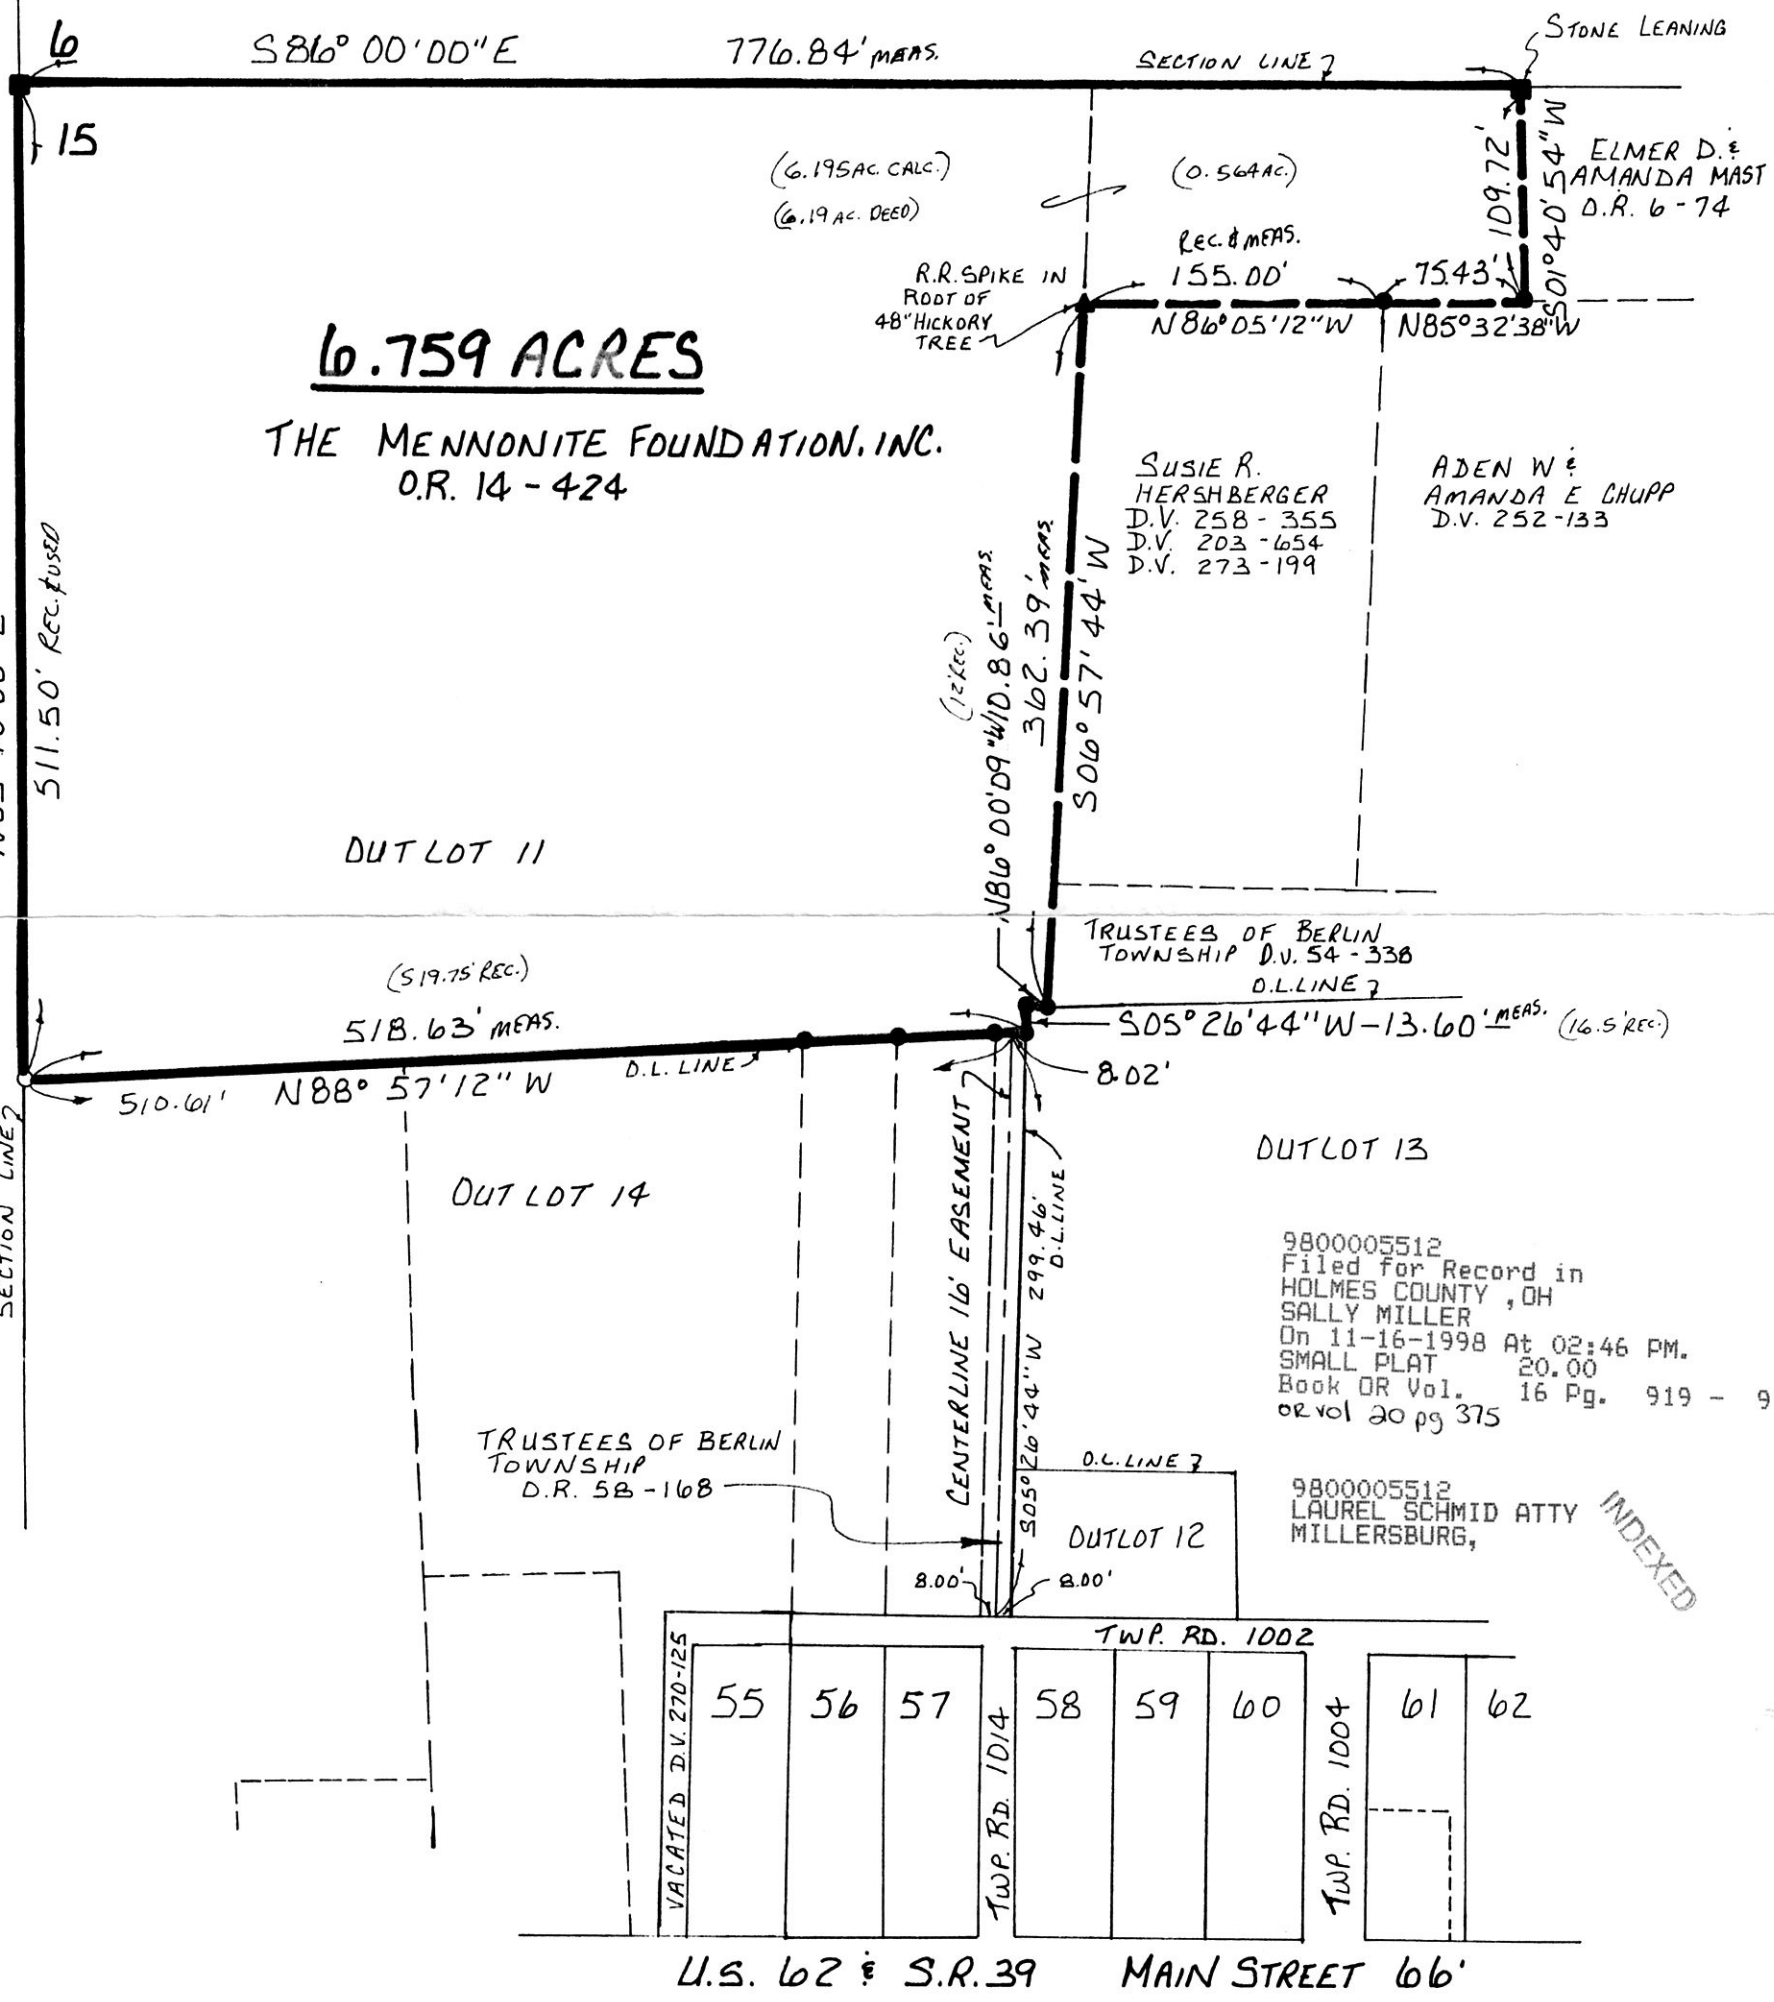

9800005512
Filed for Record in
HOLMES COUNTY, OH
SALLY MILLER
On 11-16-1998 At 02:46 PM.
SMALL PLAT 20.00
Book OR Vol. 16 Pg. 919 - 919
OR VOL 20 PG 375

9800005512
LAUREL SCHMID ATTY
MILLERSBURG,

INDEXED

STATE OF OHIO
DONALD C. BAKER
6938
REGISTERED
PROFESSIONAL SURVEYOR

I CERTIFY THIS SURVEY TO BE CORRECT TO THE BEST OF MY KNOWLEDGE.

Donald C. Baker

DONALD C. BAKER P.S. 6938
138 N. CLAY ST.
MILLERSBURG, OHIO 44654
PH: (330) 674-4788

#65598-FJM
F.C.C-F.D. BAKER

PLAT APPROVED
11/12/98