

PLAT APPROVED

12/16/98-b

INDEXED

980292

APPROVED FOR TRANSFER ONLY
NO SUBDIVISION PLAT REQUIRED
(O.R.C. 711.001 & 711.131)
Lot(s) not for building unless
approved by Board of Health
HOLMES CO. PLANNING COMM.

By ASO Date 12/15/98

9800006136
Filed for Record in
HOLMES COUNTY, OH
SALLY MILLER
On 12-17-1998 At 03:34 pm.
SMALL PLAT 20.00
Book OR Vol. 16 Pg. 958 - 958
OR vol. 22 pg 660

9800006136
DANIEL MATHIE ATTY
MILLERSBURG,

Carodene Co.
(ORV 5, pg.194)



Marion R. & Mary Ellen Beachy
Deed (vol.282, pg.65)

Delon V. & Elizabeth Troyer
Deed (vol.266, pg.595)

Susan Yoder
Deed (vol.244, pg.443)

Daniel C. Yoder
(ORV 17, pg.28)

Daniel C. & Mary Yoder
Deed (vol.225, pg.976)

0.468 Ac. Total

(NW Qtr. = 0.044 Ac.)

(NE Qtr. = 0.424 Ac.)


RESEARCH REFERENCES

- ORV 1, pg.485
- Deed Vol.225, pg.976
- ORV 5, pg.194
- Deed Vol.202, pg.234
- Deed Vol.280, pg.99
- Deed Vol.244, pg.443
- Deed Vol.266, pg.595
- Deed Vol.282, pg.65
- ORV 17, pg.28

CERTIFICATION


This is to certify that this plat is based upon an in-the-field survey conducted under my supervision.

G. W. Stewart R.S. 6357

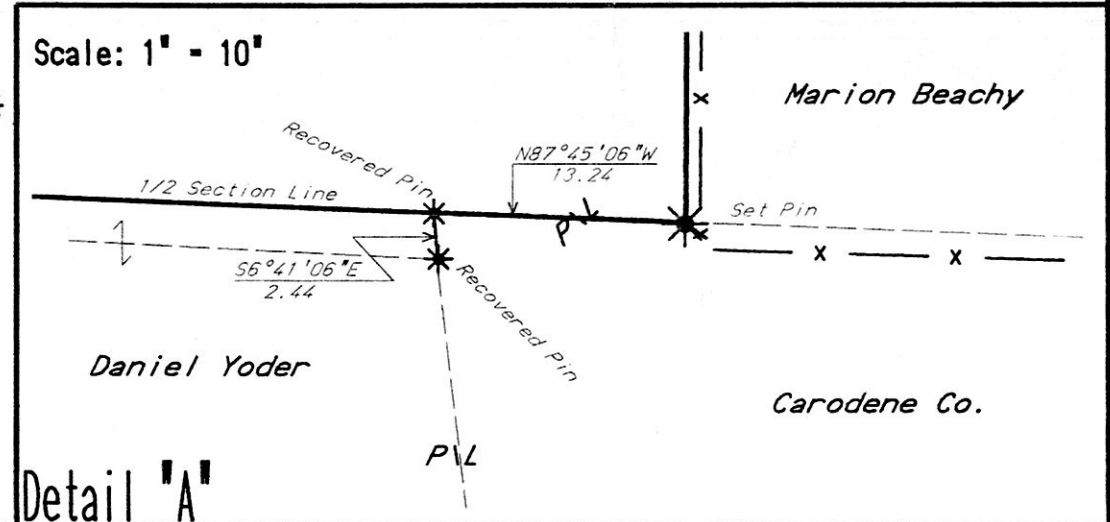

MARION R. BEACHY Deed (vol.282, pg.65)
SEC. 14, T-8N, R-4W
CLARK TOWNSHIP
HOLMES COUNTY, OHIO

RAVENTECK, LTD
20769 CR-6, Coshocton, OH 43812
Phone: (740) 622-8922

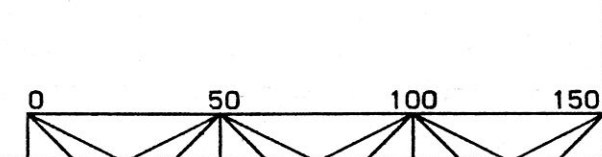

Scale: 1" = 50'
Date: July 22, 1998

Based upon a Deed, (vol.225, pg.976)