


**BERLINTOWNSHIP**  
**N.W. QTR. SECTION 4**  
**T-9N; R-5W**  
**HOLMES COUNTY, OHIO**  
 (SURVEYED FOR:

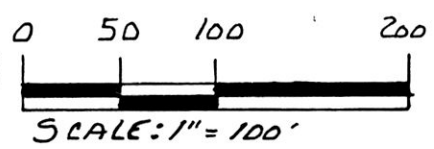

- ▲ R.R. SPIKE FOUND
- IRON PIN FOUND
- 5/8" RE BAR WITH I.D. CAP SET
- I.D. CAP MARKED "BAKER 6938"

9800006215  
 Filed for Record in  
 HOLMES COUNTY, OH  
 SALLY MILLER  
 On 12-22-1998 At 03:14 PM.  
 SMALL PLAT 20.00  
 Book OR Vol. 16 Pg. 964 - 964

INDEXED

REFERENCES:


- DEED VOL. 182 PAGE 307
- " " 158 " 377
- " " 249 " 495

O.R. Vol. 3 PAGE 910

980288

APPROVED FOR TRANSFER ONLY  
 NO SUBDIVISION PLAT REQUIRED  
 (O.R.C. 711.001 & 711.131)  
 Lot(s) not for building unless  
 approved by Board of Health,  
 HOLMES CO. PLANNING COMM.

By AB Date 12/14/98

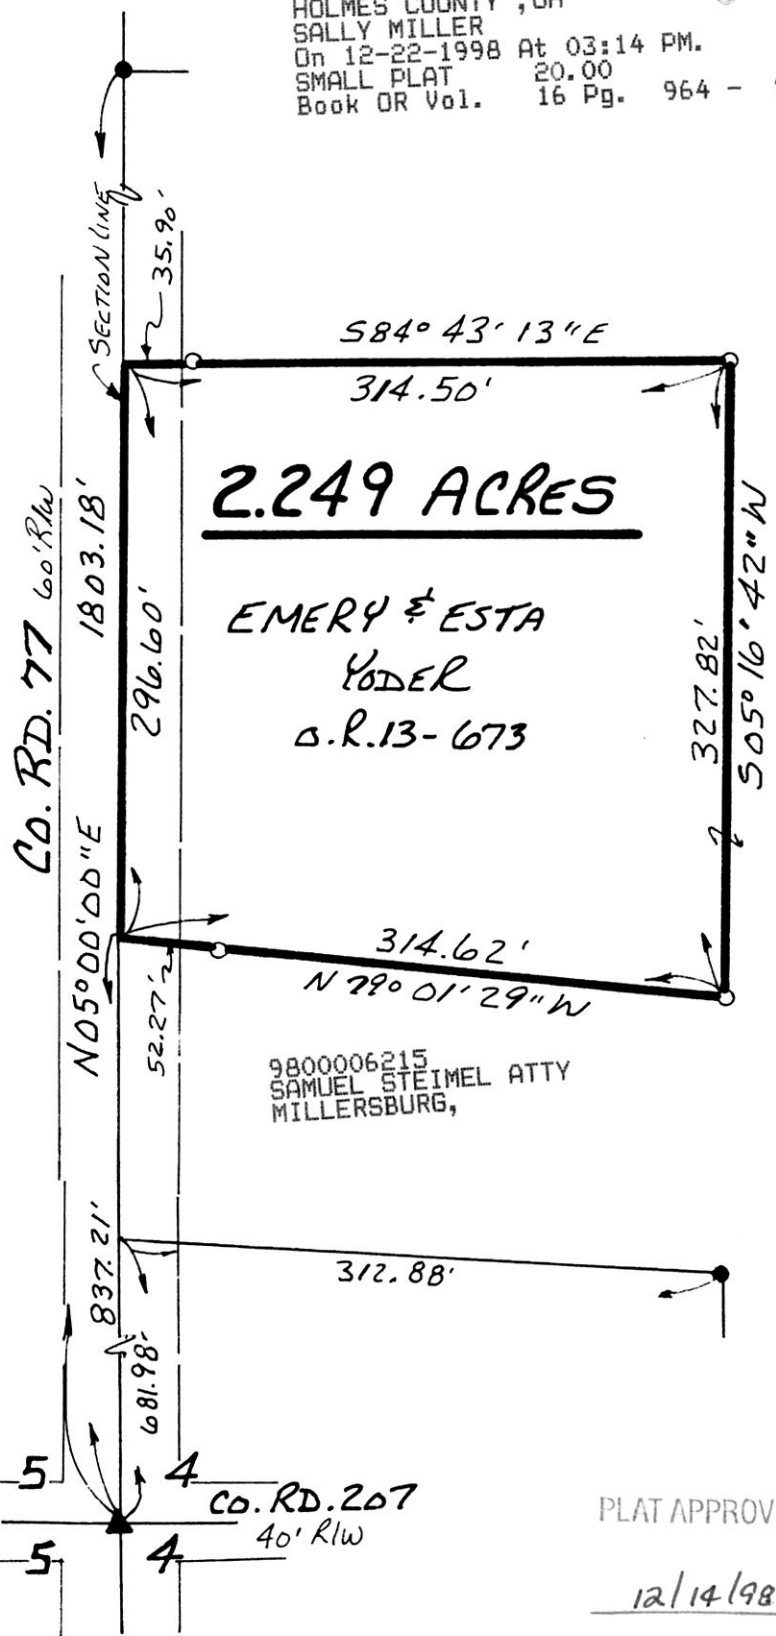

9800006215  
 SAMUEL STEIMEL ATTY  
 MILLERSBURG,

I CERTIFY THIS SURVEY TO BE CORRECT  
 TO THE BEST OF MY KNOWLEDGE.

Donald C. Baker

DONALD C. BAKER P.S. 6938  
 138 N. CLAY ST.  
 MILLERSBURG, OHIO 44654  
 PH. (330) 674-4788

OCTOBER 12, 1998

PLAT APPROVED

# 71998-M.L. DAUS  
 F.C.C.-F.D. BAKER

12/14/98