


WAYNE TOWNSHIP
 3RD. QTR. LOT 2
 T-10N; R-4W VOL 17 PAGE 39
 TUSCARAWAS Co., OHIO
 (SURVEYED FOR DALE L. & ESTHER O. BEACHY)

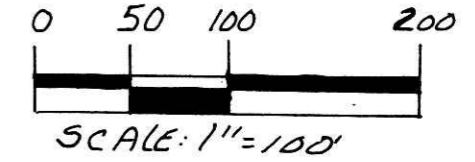

- STONE FOUND
- IRON PIN FOUND
- P. K. NAIL SET
- 5/8" RE BAR WITH I.D. CAP SET
- I.D. CAP MARKED "BAKER 6938"


REFERENCES: (TUSC. Co.)
 DEED VOL. 627 PAGE 672
 DEED VOL. 639 PAGE 775
 DEED VOL. 594 PAGE 47

REFERENCES: (HOLMES Co.)
 DEED VOL. 242 PAGE 442 & 448
 DEED VOL. 190 PAGE 522
 DEED VOL. 247 PAGE 842
 O.R. VOL. 16 PAGE 111
 O.R. VOL. 16 PAGE 114
 O.R. VOL. 16 PAGE 117

BEARINGS FROM O.R. VOL. 16 PAGE 117
 OF THE HOLMES Co. DEED RECORDS.

9900001417
 Filed for Record in
 HOLMES COUNTY, OH
 SALLY MILLER
 On 03-24-1999 At 02:46 PM.
 PLAT MED 21.60
 Book OR Vol. 17 Pg. 39 - 39
 ORY 28 Pg 323

INDEXED

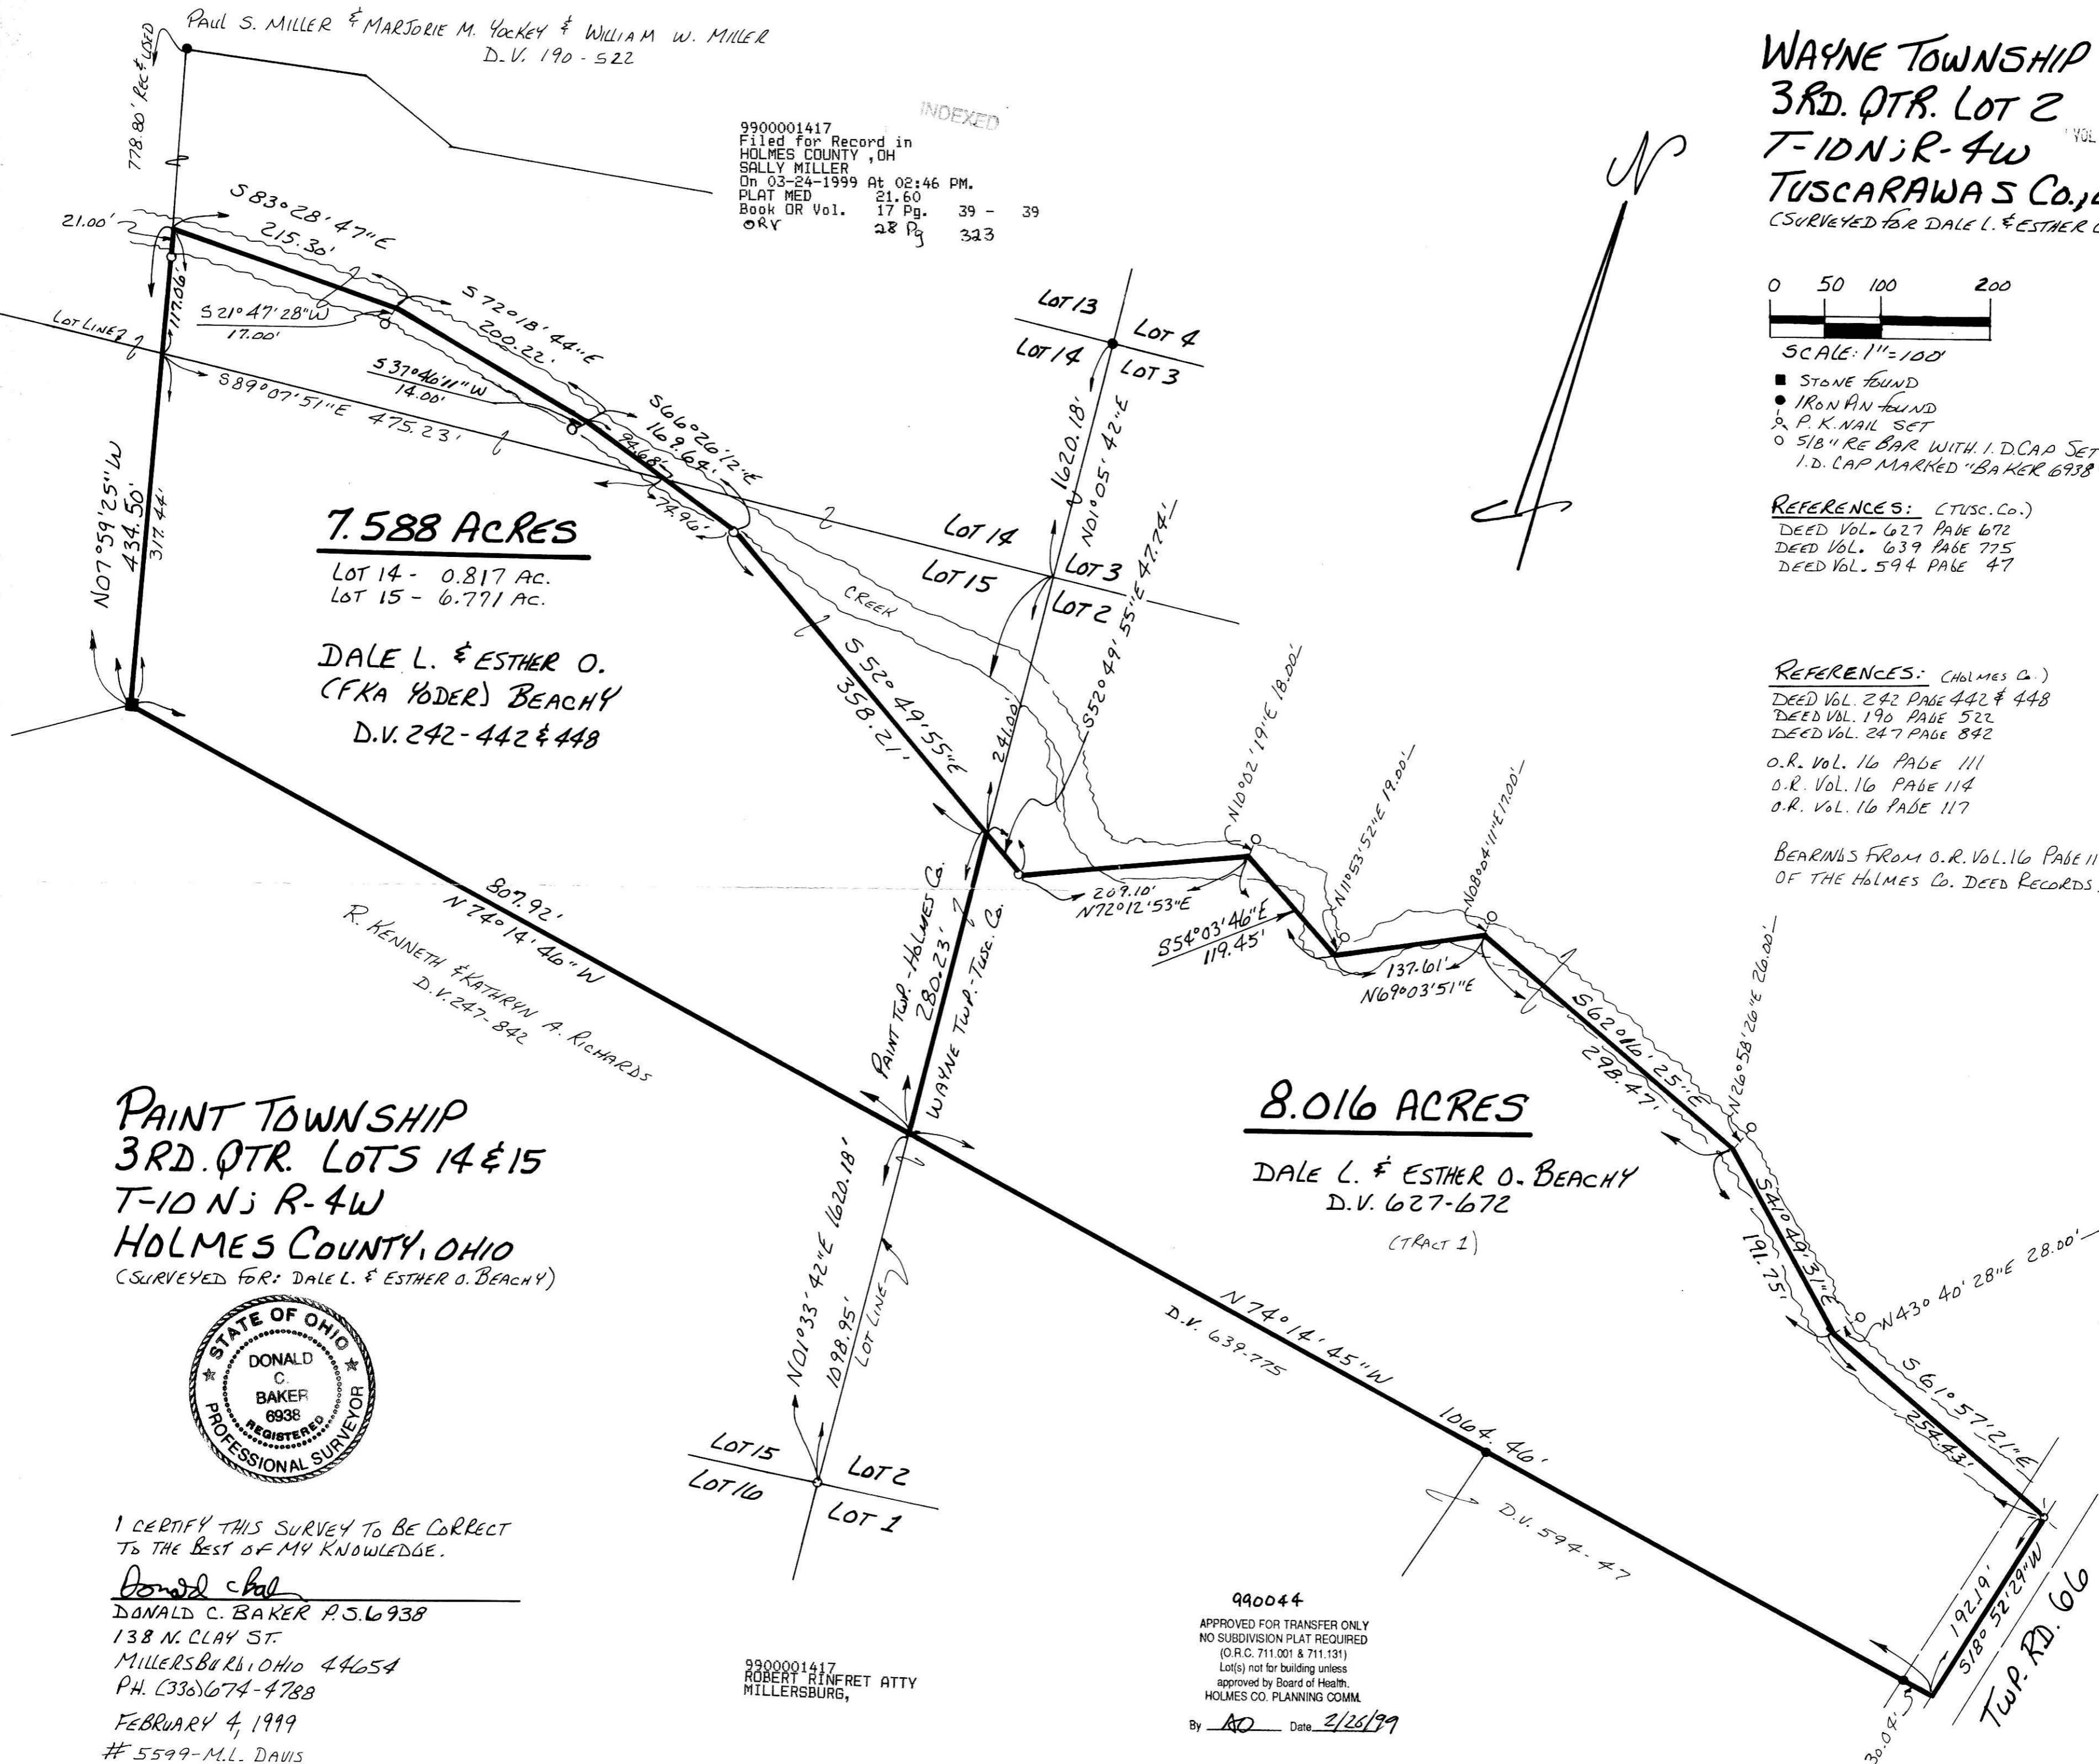

7.588 ACRES

LOT 14 - 0.817 AC.
 LOT 15 - 6.771 AC.

DALE L. & ESTHER O.
 (FKA YODER) BEACHY
 D.V. 242-442 & 448

8.016 ACRES

DALE L. & ESTHER O. BEACHY
 D.V. 627-672

(TRACT 1)

PAINT TOWNSHIP
 3RD. QTR. LOTS 14 & 15
 T-10N; R-4W
 HOLMES COUNTY, OHIO
 (SURVEYED FOR: DALE L. & ESTHER O. BEACHY)



I CERTIFY THIS SURVEY TO BE CORRECT
 TO THE BEST OF MY KNOWLEDGE.

Donald C. Baker
 DONALD C. BAKER P.S. 6938
 138 N. CLAY ST.
 MILLERSBURG, OHIO 44654
 PH. (330) 674-4788
 FEBRUARY 4, 1999
 # 5599-M.L. DAVIS
 F. C. C. - J. D. DARR

9900001417
 ROBERT RINFRET ATTY
 MILLERSBURG,

990044
 APPROVED FOR TRANSFER ONLY
 NO SUBDIVISION PLAT REQUIRED
 (O.R.C. 711.001 & 711.131)
 Lot(s) not for building unless
 approved by Board of Health,
 HOLMES CO. PLANNING COMM.
 By AD Date 2/26/99

PLAT APPROVED

3/1/99-b