



PAIN T TOWNSHIP
4 TH. QTR. LOTS 10 & 11
T-10N ; R-5W
HOLMES COUNTY, OHIO
 (SURVEYED FOR ORIN & MARTHA YODER)

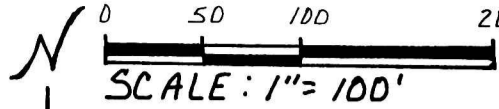

- ▲ R.R. SPIKE FOUND
- P.K. NAIL FOUND
- IRON PIN FOUND
- P.K. NAIL SET
- 5/8" REBAR WITH I.D. CAP SET
- I.D. CAP MARKED "BAKER 6938"

INDEXED
 9900001810
 Filed for Record in
 HOLMES COUNTY, OH
 SALLY MILLER
 On 04-14-1999 At 01:35 pm
 SMALL PLAT 20.00
 Book OR Vol. 17 Pg. 65 - 65
 or vol. 29 pg 5el

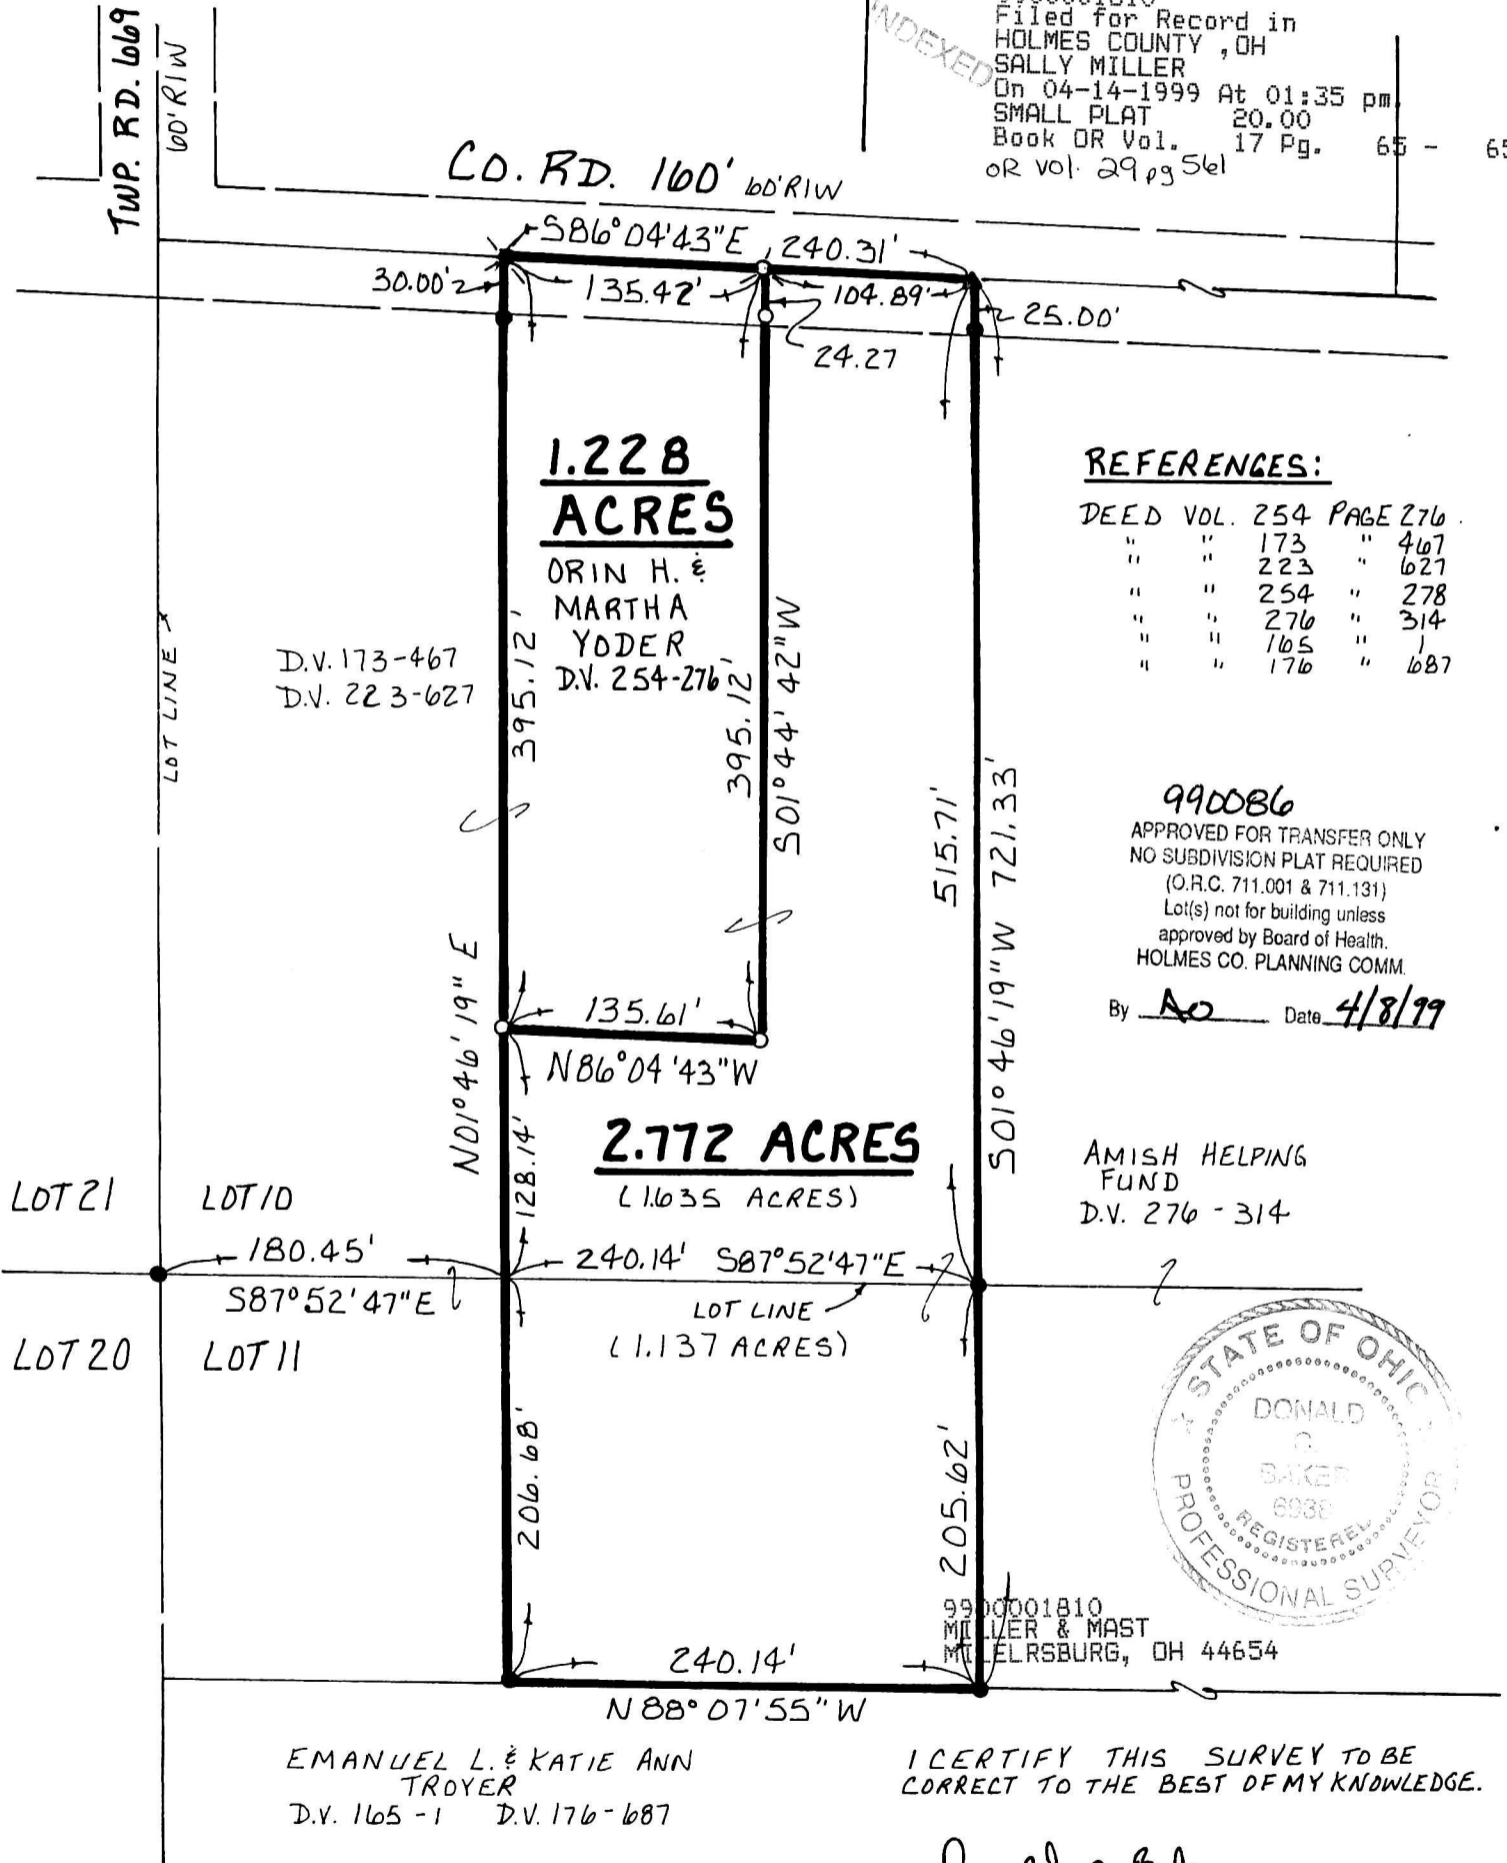

REFERENCES:

"	"	173	467
"	"	223	627
"	"	254	278
"	"	276	314
"	"	165	1
"	"	176	687

990086
 APPROVED FOR TRANSFER ONLY
 NO SUBDIVISION PLAT REQUIRED
 (O.R.C. 711.001 & 711.131)
 Lot(s) not for building unless
 approved by Board of Health.
 HOLMES CO. PLANNING COMM.
 By NO Date 4/8/99

AMISH HELPING FUND
 D.V. 276 - 314



9900001810
 MILLER & MAST
 MILLERSBURG, OH 44654

I CERTIFY THIS SURVEY TO BE CORRECT TO THE BEST OF MY KNOWLEDGE.

Donald C. Baker
DONALD C. BAKER P.S. 6938
 138 N. CLAY ST.
 MILLERSBURG, OHIO 44654
 PH: (330) 674-4788
 JANUARY 18, 1999 #86798-FJM
 F.C.L. - F.D. BAKER

PLAT APPROVED
4/8/99