


PAINT TOWNSHIP 17 PAGE 71
 4TH. QTR. LOT 28
 T-10N; R-5W
 HOLMES COUNTY, OHIO
 (SURVEYED FOR: ROBERT & FANNIE COBLENTZ)

(A) FANNIE SWARTZENTRUBER D.V. 251-885

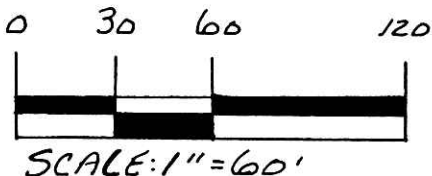

- IRON PIN FOUND
- 5/8" RE BAR WITH I.D. CAP SET
I.D. CAP MARKED "BAKER 6938"


REFERENCES:
 DEED VOL. 276 PAGE 649
 " " 249 " 469
 " " 165 " 523
 " " 251 " 885

PLAT VOL. 2 PAGE 224
 " " 15 " 114

BEARINGS FROM PLAT 12 PAGE 689

9900001932
 Filed for Record in
 HOLMES COUNTY, OH
 SALLY MILLER
 On 04-22-1999 At 09:42 am.
 SMALL PLAT 20.00
 OR Book 17 Page 71 - 71
 OR vol 30 pgs 20+22

INDEXED

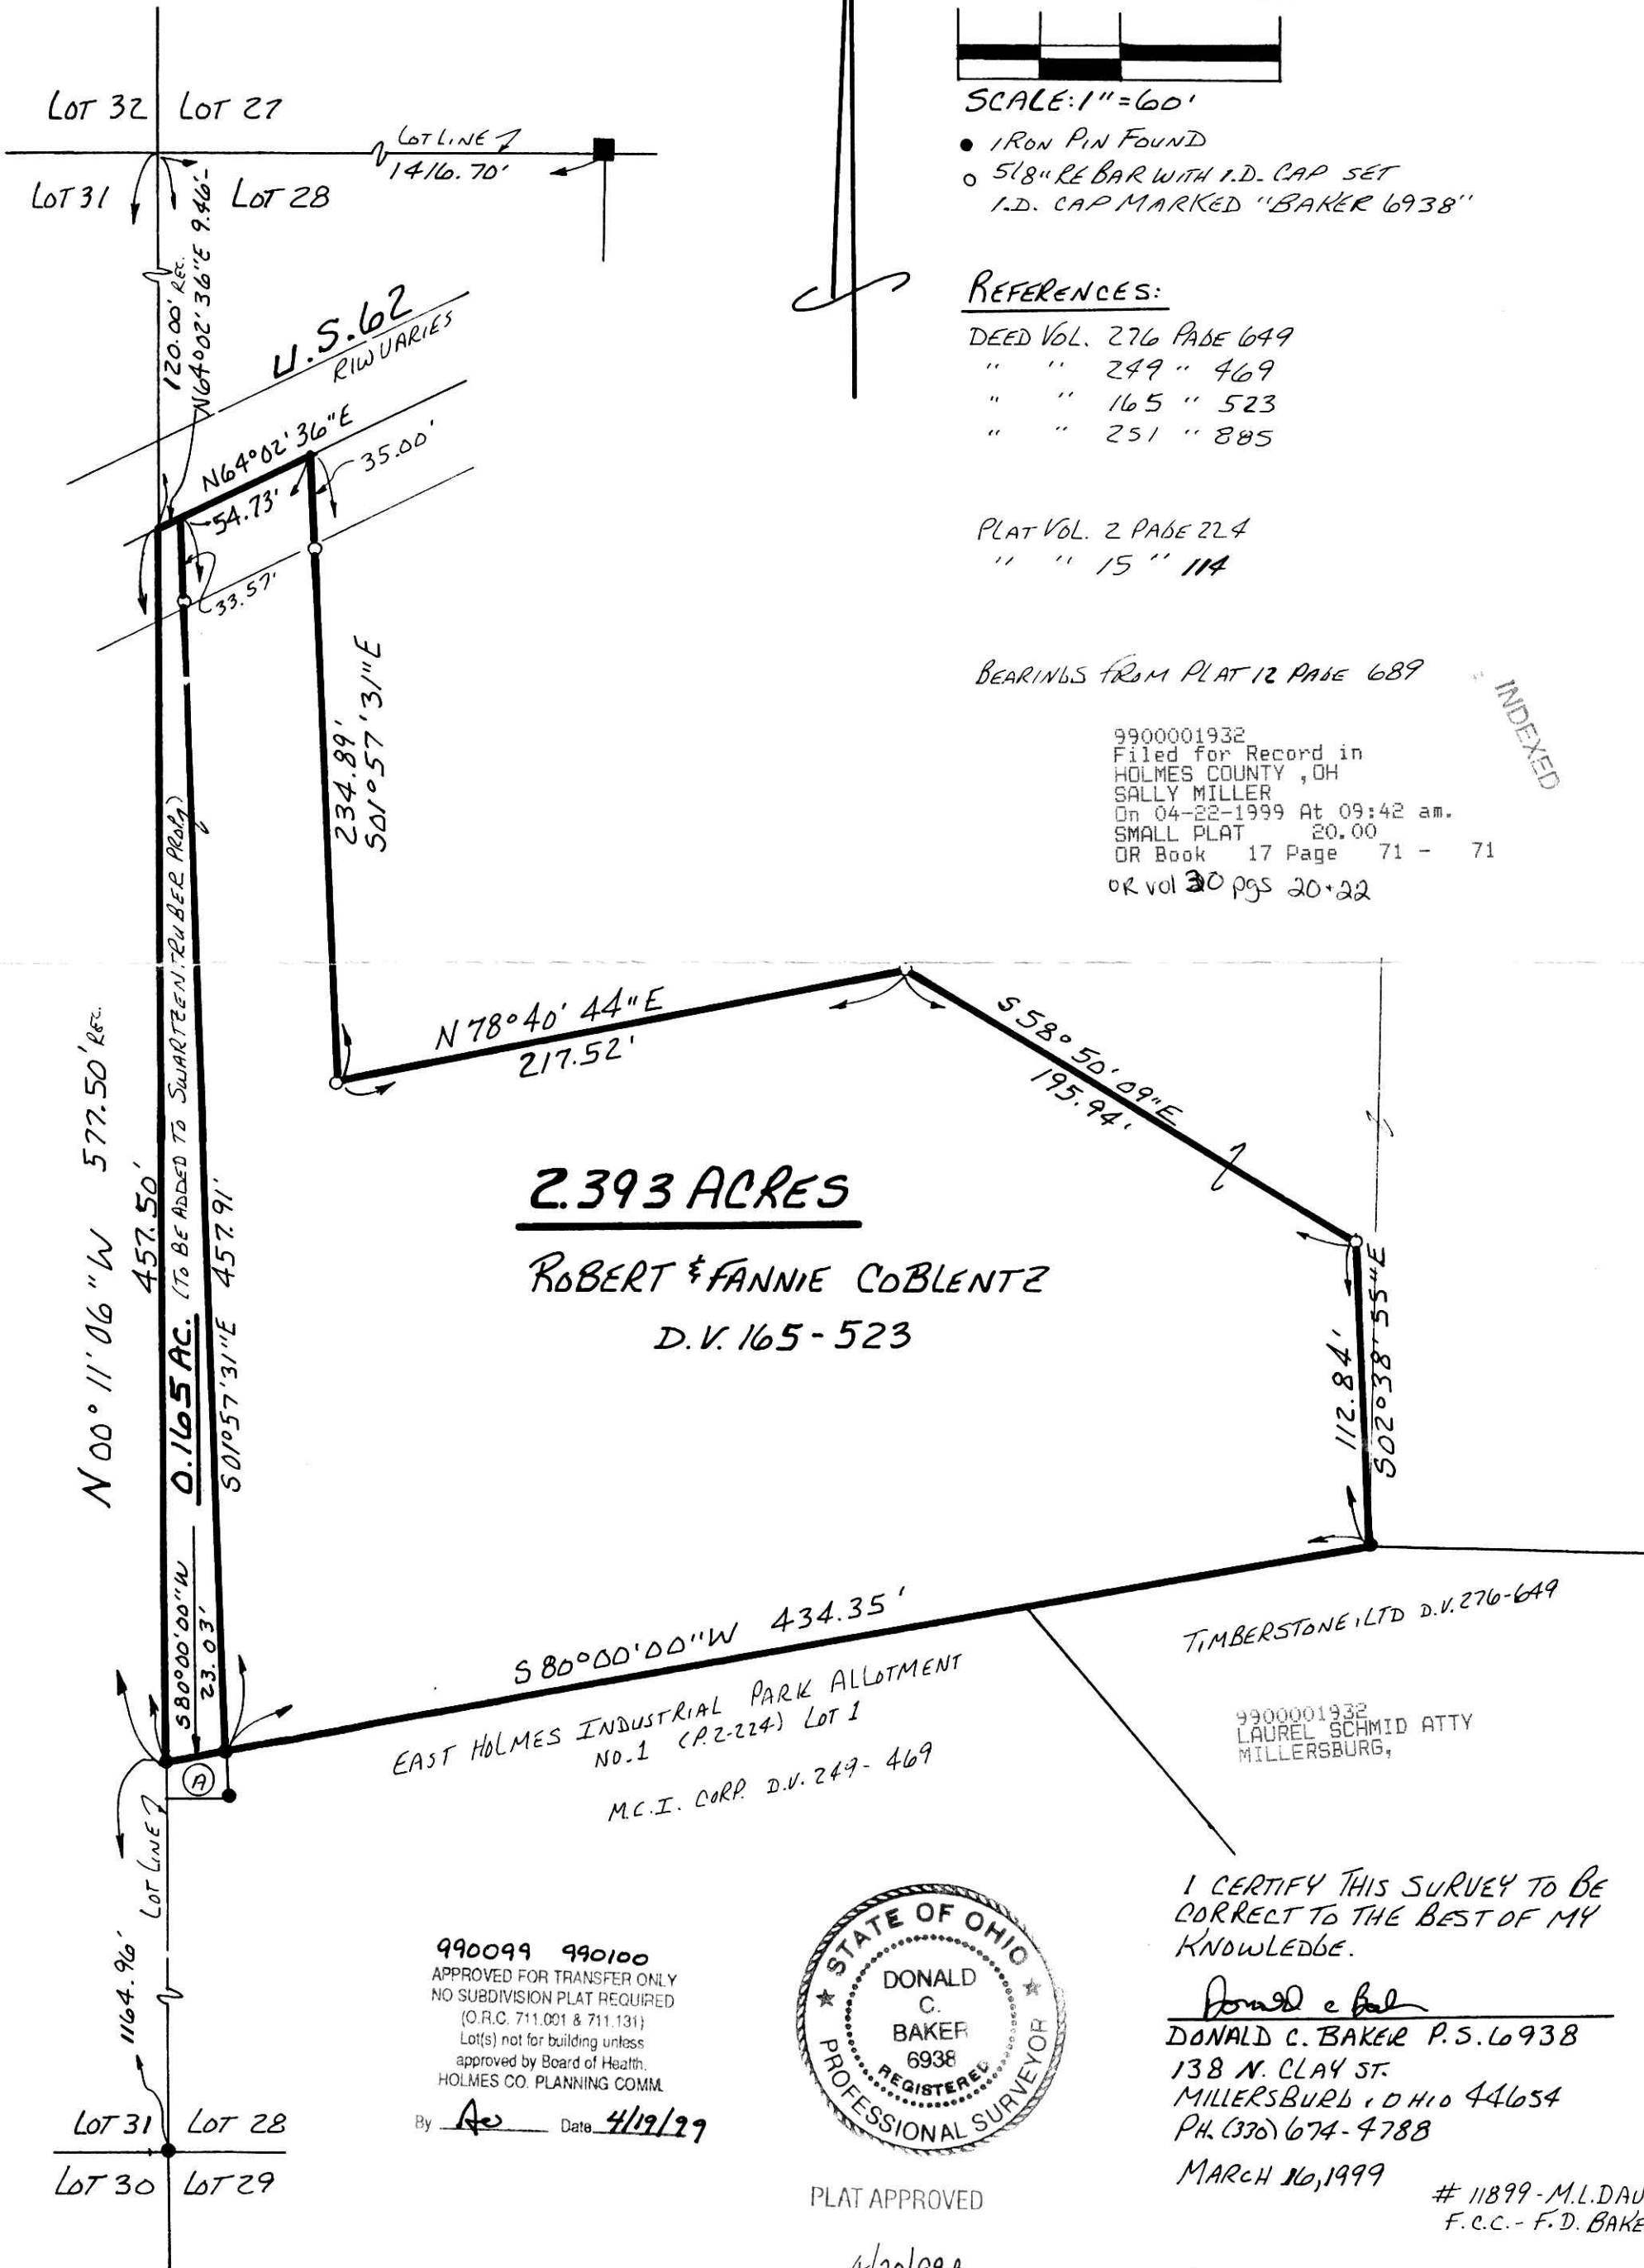

2.393 ACRES

ROBERT & FANNIE COBLENTZ
 D.V. 165-523

S 80°00'00"W 434.35'
 EAST HOLMES INDUSTRIAL PARK ALLOTMENT
 NO. 1 (P. 2-224) LOT 1
 M.C.I. CORP. D.V. 249-469

TIMBERSTONE LTD D.V. 276-649

9900001932
 LAUREL SCHMID ATTY
 MILLERSBURG,

I CERTIFY THIS SURVEY TO BE
 CORRECT TO THE BEST OF MY
 KNOWLEDGE.

Donald C. Baker
 DONALD C. BAKER P.S. 6938
 138 N. CLAY ST.
 MILLERSBURG, OHIO 44654
 PH. (330) 674-4788

MARCH 16, 1999

11899 - M.L. DAVIS
 F.C.C. - F.D. BAKER

990099 990100
 APPROVED FOR TRANSFER ONLY
 NO SUBDIVISION PLAT REQUIRED
 (O.R.C. 711.001 & 711.131)
 Lot(s) not for building unless
 approved by Board of Health,
 HOLMES CO. PLANNING COMM.

By *Ac* Date 4/19/99



PLAT APPROVED

4/20/99B