

WALNUT CREEK TOWNSHIP

1ST. QTR. LOTS 16 & 17

T-9N; R-5W

HOLMES COUNTY, OHIO

(SURVEYED FOR: FERMAN D. & FANNIE A. WENGERD)

0 100 200 400

SCALE: 1" = 200'

- Stone Found
- Iron Pin Found
- P.K. Nail Set
- 1/2" Rebar with I.D. Cap Set
- I.D. Cap Marked "BAKER 6938"

REFERENCES:

DEED VOL. 278 Page 782
 " " 207 " 312
 " " 246 " 742
 " " 267 " 292
 " " 237 " 20

PLAT VOL. 10 PAGE 112
 " " 12 " 84
 " " 12 " 402

BEARINGS FROM DEED VOL. 267 PAGE 784



I CERTIFY THIS SURVEY TO BE CORRECT TO THE BEST OF MY KNOWLEDGE.


Donald C. Baker

DONALD C. BAKER P.S. 6938

DONALD C. BAKER SURVEYING
 138 N. CLAY STREET
 MILLERSBURG, OHIO 44654
 PH (330) 674-4788

JUNE 23, 1999

#28699-M.L. DAVIS
F.C.C.-F.D. BAKER

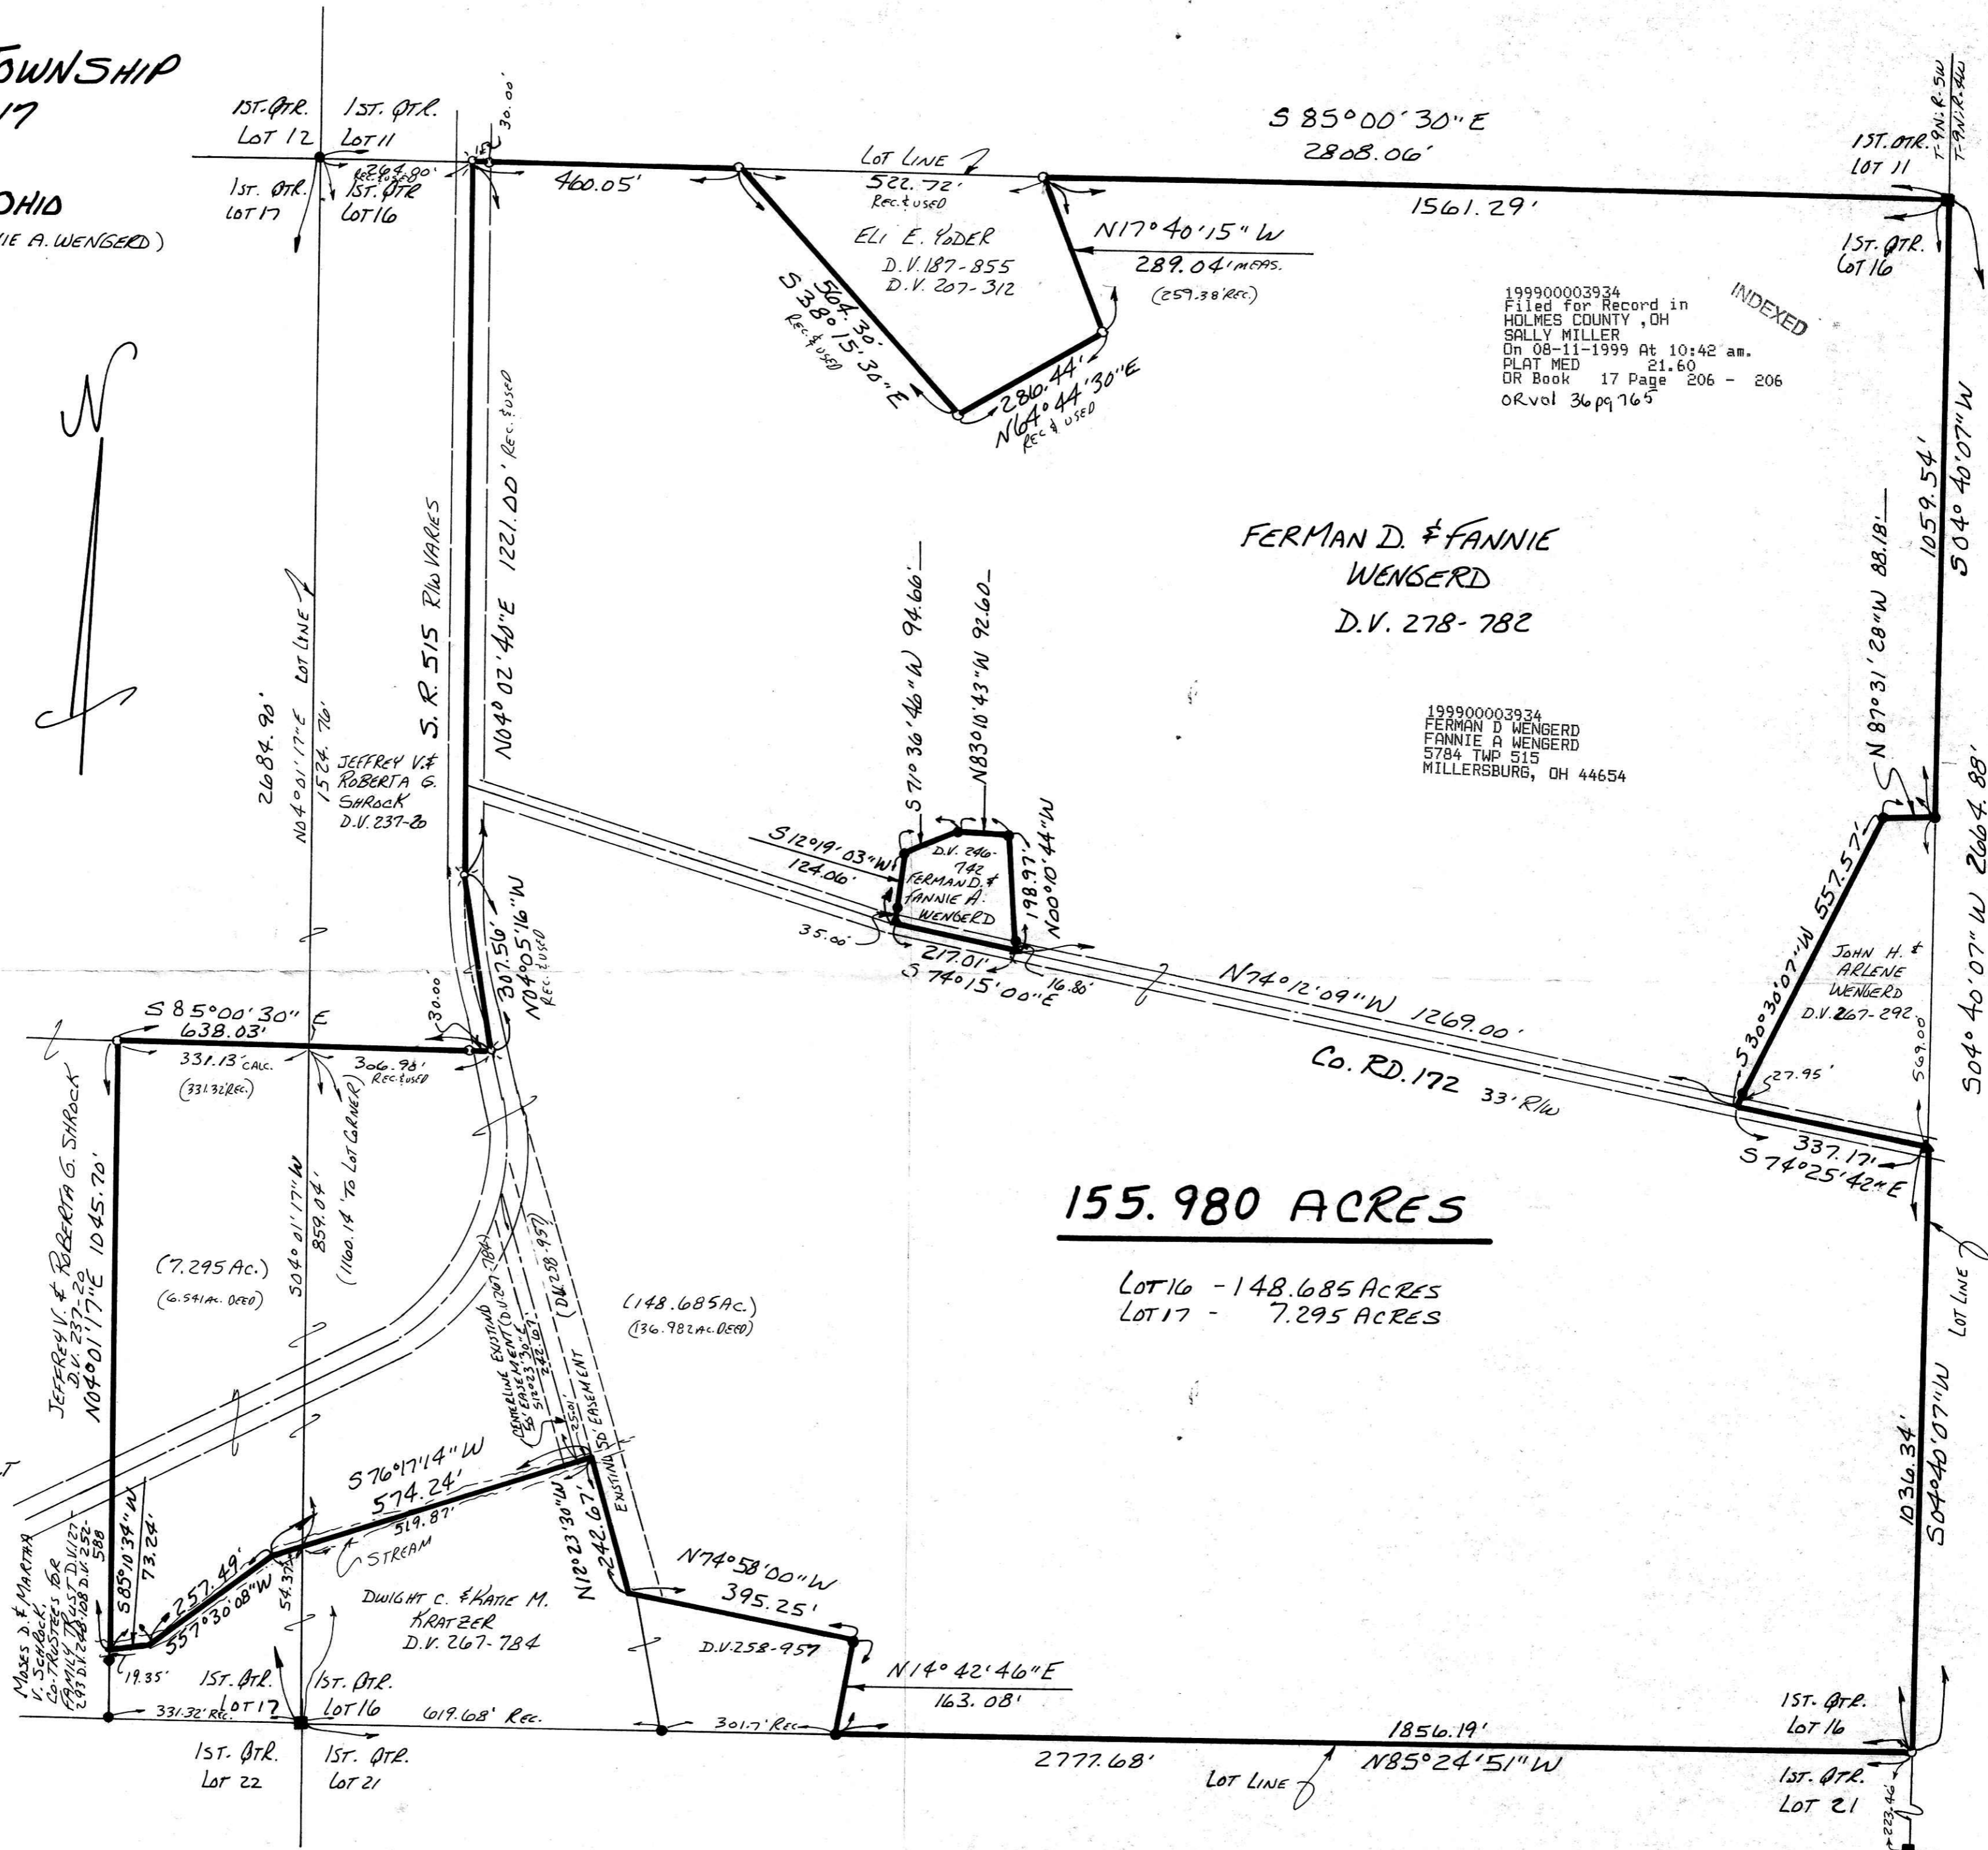

FERMAN D. & FANNIE
 WENGERD
 D.V. 278-782

199900003934
 FERMAN D. WENGERD
 FANNIE A. WENGERD
 5784 TWP 515
 MILLERSBURG, OH 44654

155.980 ACRES

LOT 16 - 148.685 ACRES
 LOT 17 - 7.295 ACRES