

- IRON PIN FOUND
- ▲ R.R. SPIKE FOUND
- 5/8" REBAR WITH I.D. CAPSET I.D. CAP MARKED "BAKER 6938"


PRAIRIE TOWNSHIP
 S.E. QTR. SECTION 6
 T-13N; R-13W
 HOLMES COUNTY, OHIO
 (SURVEYED FOR: MICHAEL YODER)



199900004365
 Filed for Record in
 HOLMES COUNTY, OH
 SALLY MILLER
 On 09-03-1999 At 12:11 pm.
 SMALL PLAT 20.00
 OR Book 17 Page 230 - 230
 or vol 38 pg 206, 213

INDEXED

JONAS & AMANDA
 COBLENTZ
 D.V. 248-891

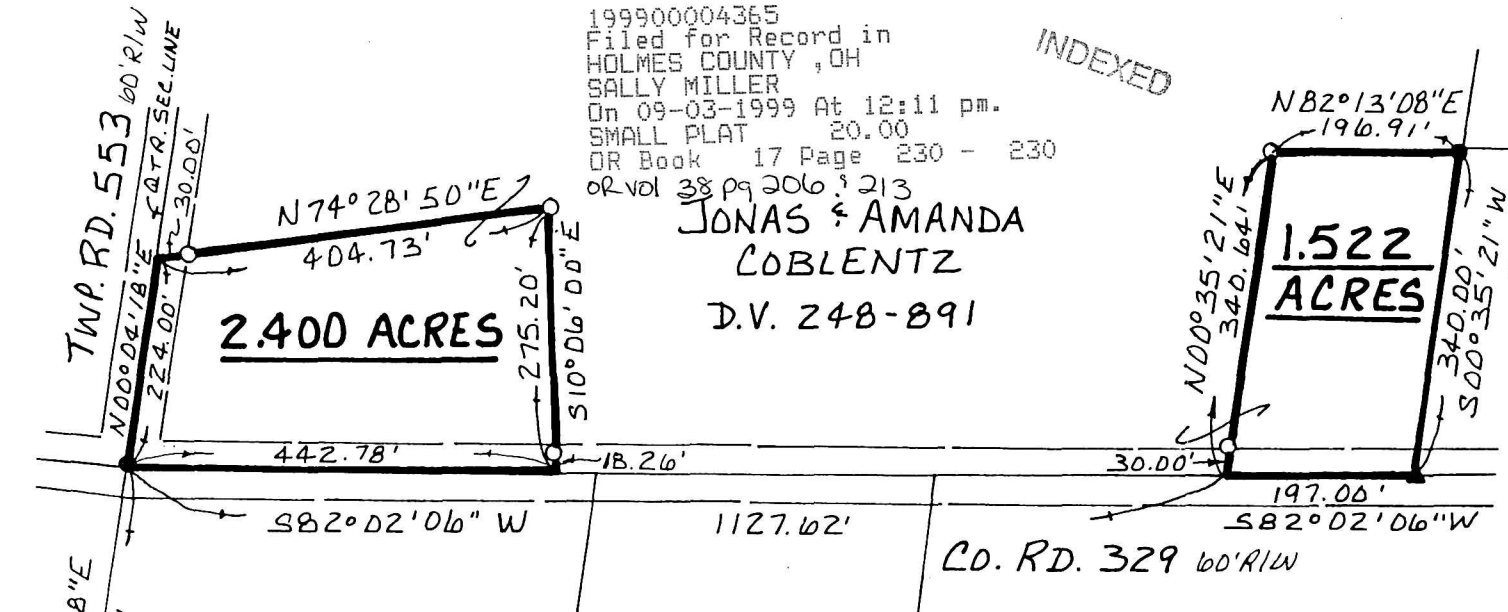

PENIEL
 FELLOWSHIP
 CHURCH
 D.V. 221-942

990235 990236
 APPROVED FOR TRANSFER ONLY
 NO SUBDIVISION PLAT REQUIRED
 (O.R.C. 711.001 & 711.131)
 Lot(s) not for building unless
 approved by Board of Health.
 HOLMES CO. PLANNING COMM.

By AO Date 8/24/99

REFERENCES:

DEED VOL.	248	PAGE	891
" "	221	"	942
" "	260	"	776
" "	260	"	774
" "	249	"	572
PLAT VOL.	11	PAGE	71
" "	10	"	695
" "	12	"	568
" "	14	"	258

BEARINGS FROM PLAT VOL. 12 Pg. 568

199900004365
 LAUREL SCHMID ATTY
 MILLERSBURG,



I CERTIFY THIS SURVEY TO BE CORRECT
 TO THE BEST OF MY KNOWLEDGE.

Donald C. Baker
 DONALD C. BAKER P.S. 6938
 DONALD C. BAKER SURVEYING
 138 N. CLAY ST.
 MILLERSBURG, OHIO 44654
 PH: (330) 674-4788

JUNE-21, 1999

33199-FJM
 F.C.C. - D.C. BAKER

PLAT APPROVED

8/25/99