

BERLIN TOWNSHIP
N.W. QTR. SECTION 7
T-9N; R-5W
HOLMES COUNTY, OHIO
 (SURVEYED FOR: PETER H.C. & NANCY DAUWALDER)


- REFERENCES:**
 DEED VOL. 216 PAGE 478
 " " 276 " 303
 " " 241 " 163
 " " 150 " 313
 " " 211 " 459
 " " 263 " 434
 " " 252 " 231
 " " 240 " 434
 O.R. VOL. 25 PAGE 642

BEARINGS FROM DEED VOL. 216 PAGE 278



- SCALE: 1" = 100'
 ■ STONE FOUND
 ● IRON PIN FOUND
 ○ 5/8" RE BAR WITH I.D. CAP SET
 I.D. CAP MARKED "BAKER 6738"

199900004457
 Filed for Record in
 HOLMES COUNTY, OH
 SALLY MILLER
 On 09-09-1999 At 02:52 pm.
 SMALL PLAT 20.00
 OR Book 17 Page 237 - 237
 OR vol 38 pg 588-592-596
 199900004457
 MILLER & MAST ATTYS
 MILLERSBURG,

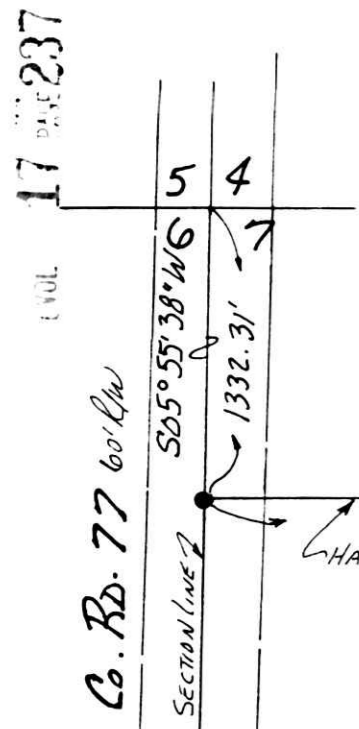

ANDY JR. & BETTY HERSHBERGER
 D.V. 241-163
 S85°15'00"E


SYLVANUS E. & SARA J. SCHLABACH
 D.V. 276-303

DONALD D. OSWALD D.V. 215-823
 D.V. 240-430 D.V. 240-434

IVAN & MARY SCHROCK
 D.V. 150-313

FANNIE E. SCHLABACH 1/2 INT D.V. 164-565
 NELSON J. & SARA SCHLABACH 1/2 INT D.V. 211-459

990253 990254
 APPROVED FOR TRANSFER ONLY
 NO SUBDIVISION PLAT REQUIRED
 (O.R.C. 711.001 & 711.131)
 Lot(s) not for building unless
 approved by Board of Health
 HOLMES CO. PLANNING COMM
 By AD Date 9/7/99

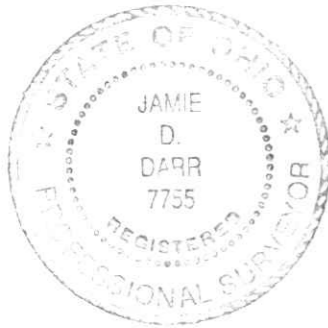


I CERTIFY THIS SURVEY TO BE CORRECT
 TO THE BEST OF MY KNOWLEDGE.

JAMIE D. DARR P.S. 7755

DONALD C. BAKER SURVEYING
 138 N. CLAY ST.
 MILLERSBURG OHIO 44654
 P.H. (330) 674-4788

JUNE 30, 1999

#25999 - M.L. DAVIS
 F.C.C. - J.D. DARR

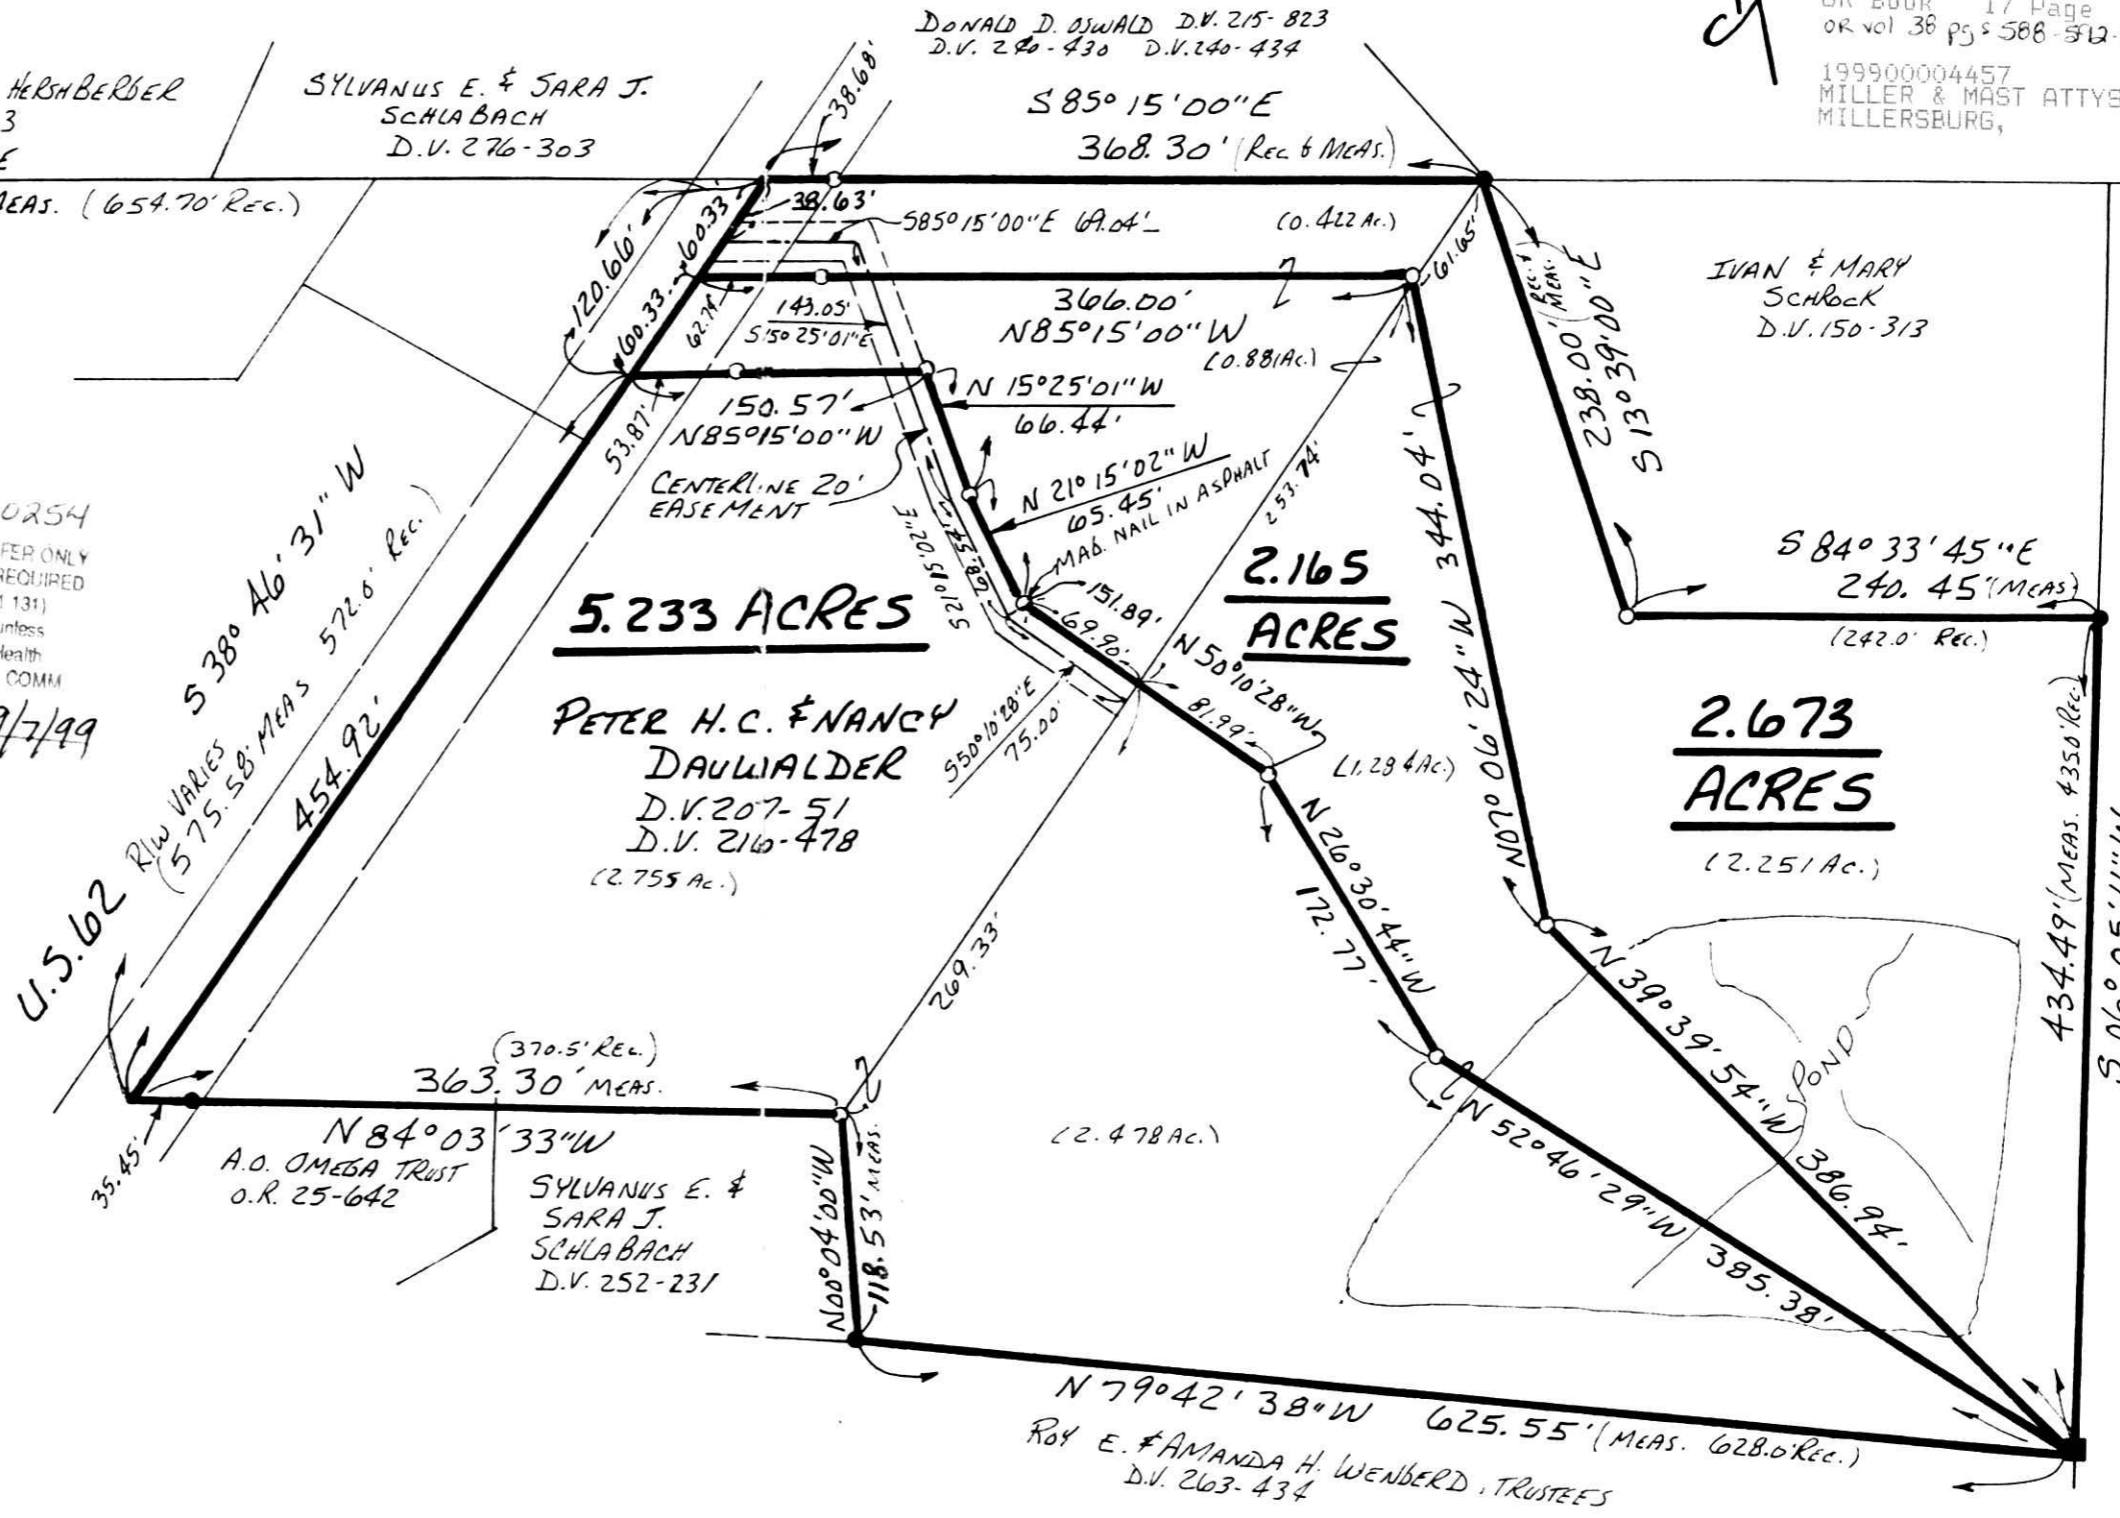

PLAT APPROVED

9/8/99