


MECHANIC TOWNSHIP
 N.E. QTR. SECTION 18
 T-8 N; R-6 W
 HOLMES COUNTY, OHIO

(SURVEYED FOR JOHN & MARY YODER)

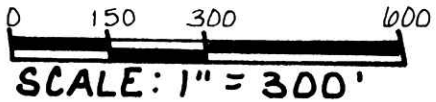


- STONE FOUND
- IRON PIN FOUND
- 5/8" REBAR WITH I.D. CAPSET
- I.D. CAP MARKED "BAKER 6938"

REFERENCES:

DEED VOL. 151 PAGE 95
 " " 204 " 665
 " " 270 " 977

BEARINGS FROM DEED VOL. 151
 PAGE 95

17 Page 297

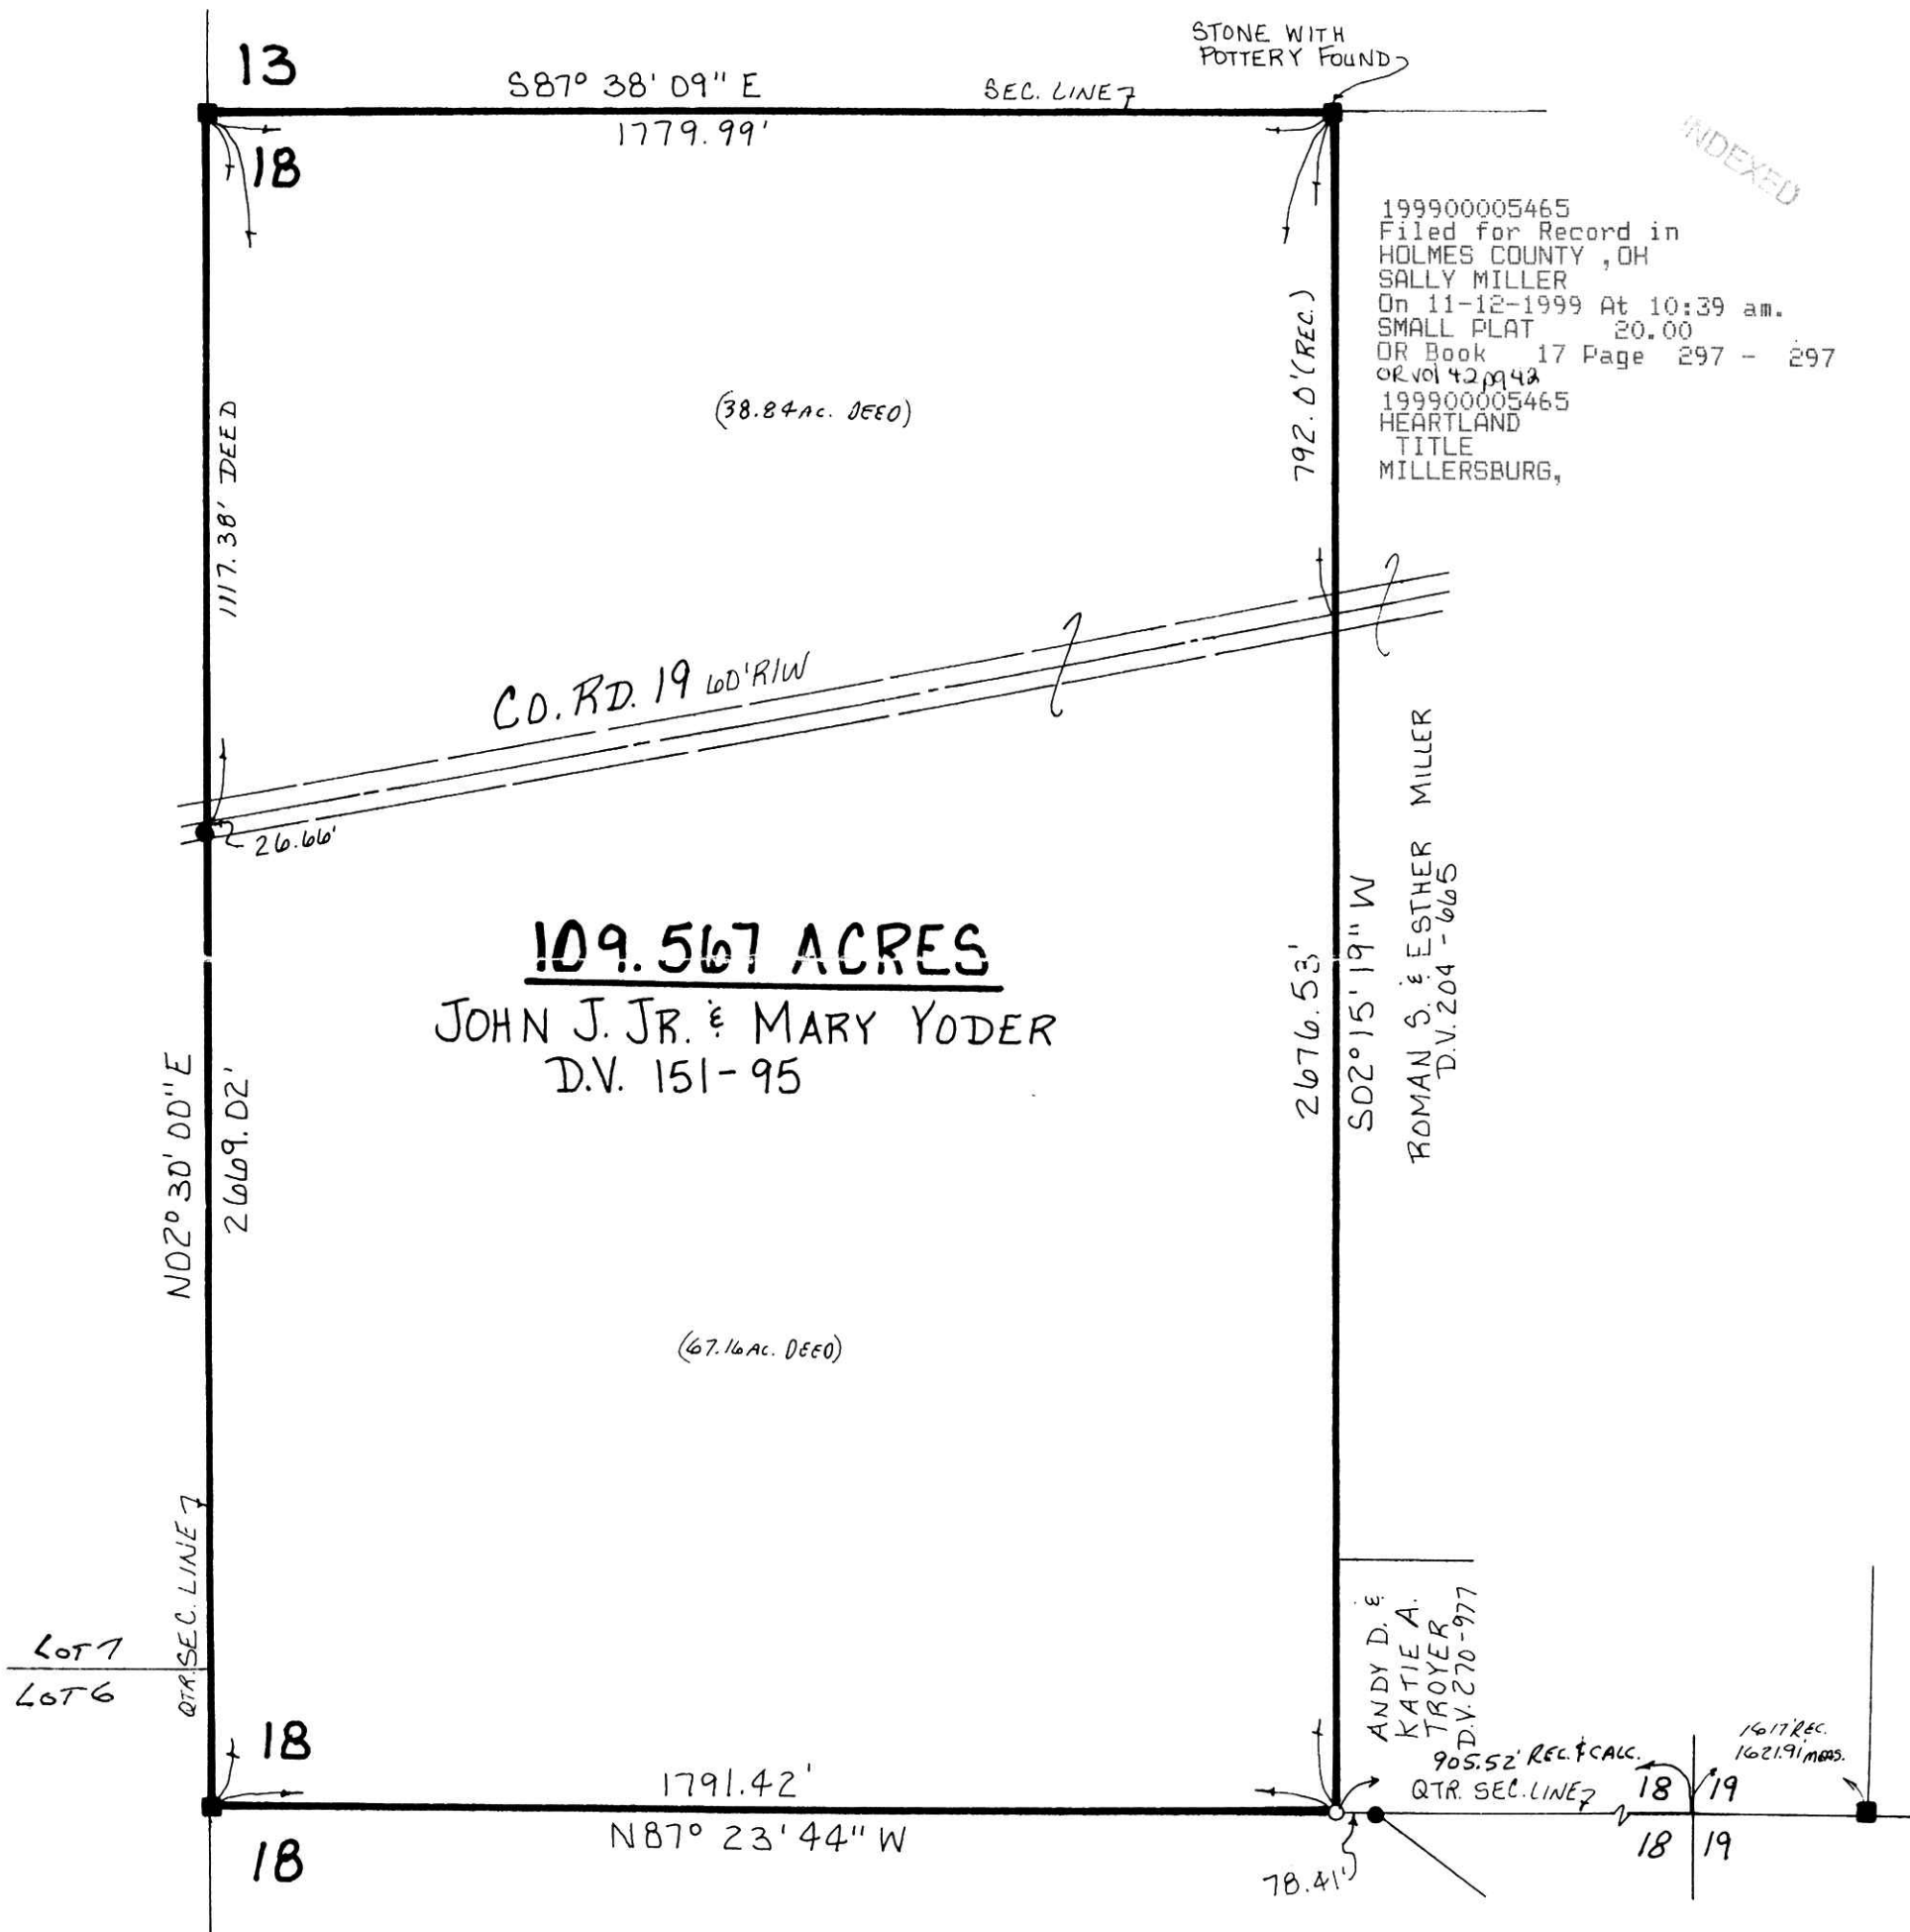

I CERTIFY THIS SURVEY TO BE CORRECT
 TO THE BEST OF MY KNOWLEDGE.



Donald C. Baker
 DONALD C. BAKER P.S. 6938
 DONALD C. BAKER SURVEYING
 138 N. CLAY ST.
 MILLERSBURG, OHIO 44654
 PH: (330) 674-4788
 OCTOBER 18, 1999

60299-FJM
 F.C.C.-F.D. BAKER PLAT APPROVED

11/12/99