

REFERENCES:

DEED VOL. 106 PAGE 571
 " " 150 " 596
 " " 230 " 777
 " " 264 " 776
 " " 274 " 190


BEARINGS FROM DEED VOL. 267
 PAGE 854.

PLAT Vol. 12 PAGE 711
 " " 7 " 12
 " " 14 " 304

RE SURVEY OF DEED VOL. 230 PAGE 777


WALNUT CREEK TOWNSHIP
 N.E. QTR. SECTION 23
 T-9N; R-5W
 HOLMES COUNTY, OHIO

(SURVEYED FOR ALTA M. KASER ESTATE)

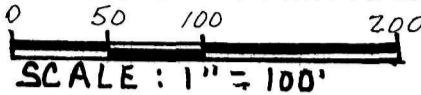

- STONE FOUND
- ▲ R.R. SPIKE FOUND
- IRON PIN FOUND
- 5/8" REBAR WITH I.D. CAP SET
- I.D. CAP MARKED "BAKER 6938"

TWP. RD. 374 30' RIW

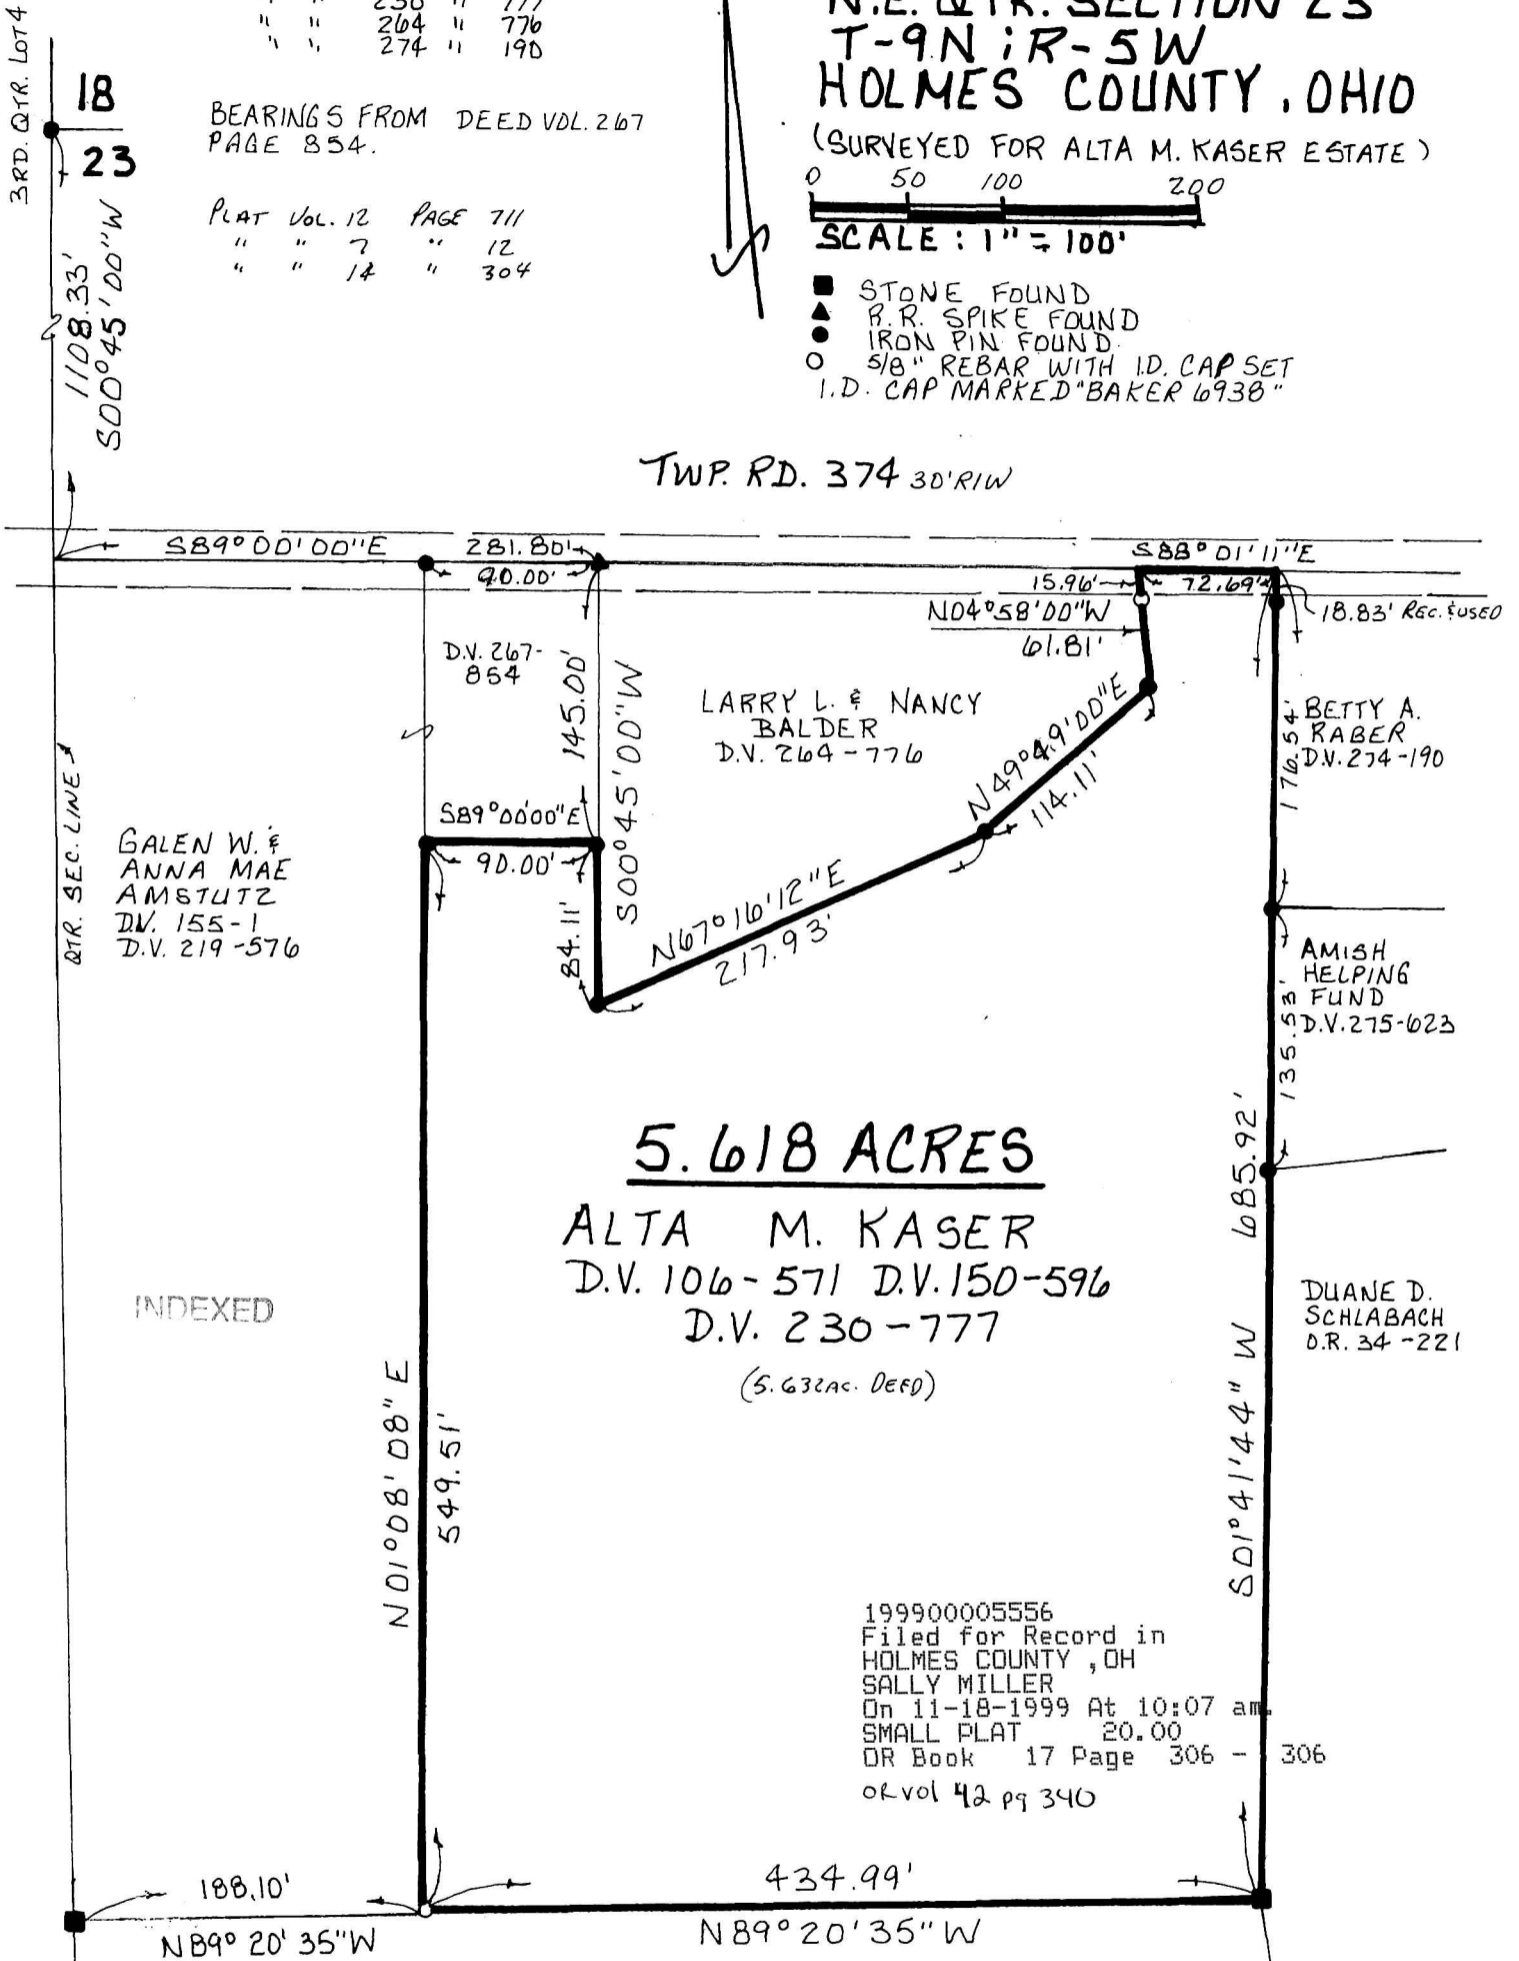

5.618 ACRES

ALTA M. KASER
 D.V. 106-571 D.V. 150-596
 D.V. 230-777

(5.632ac. DEED)

199900005556
 Filed for Record in
 HOLMES COUNTY, OH
 SALLY MILLER
 On 11-18-1999 At 10:07 am
 SMALL PLAT 20.00
 OR Book 17 Page 306 - 306
 or vol 42 pg 340

INDEXED

PLAT APPROVED

11/17/99-B

JONAS E. & FANNIE MAE BURKHOLDER
 D.V. 254 - 717

199900005556
 MILLER & MAST
 MILLERSBURG, OH 44654

I CERTIFY THIS SURVEY TO BE
 CORRECT TO THE BEST OF MY
 KNOWLEDGE.

Donald C. Baker

DONALD C. BAKER P.S. 6938
 DONALD C. BAKER SURVEYING
 138 N. CLAY ST.
 MILLERSBURG, OHIO 44654
 PH: (330) 674-4788



OCTOBER 4, 1999
 #45899-FJM
 F.C.C. - F.D. BAKER