


BERLIN TOWNSHIP
 1ST. QTR. LOT 21
 T-9N:R-6W
 HOLMES COUNTY, OHIO

(SURVEYED FOR JOHN H. MILLER TRUST)



SCALE: 1" = 100'

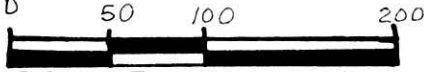


REFERENCES:

- DEED VOL. 275 PAGE 416
- " " 202 " 353
- " " 281 " 763
- " " 250 " 720
- OFFICIAL RECORD VOL. 11 PAGE 724
- BEARINGS FROM PLAT VOL. 8 PAGE 303

- IRON PIN FOUND
- P.K. NAIL SET
- 5/8" REBAR WITH I.D. CAP SET
- I.D. CAP MARKED "BAKER 6938"

▲ WILLARD MILLER
 ALLOTMENT NUMBER ONE
 (PLAT VOL. 2 PAGE 63)

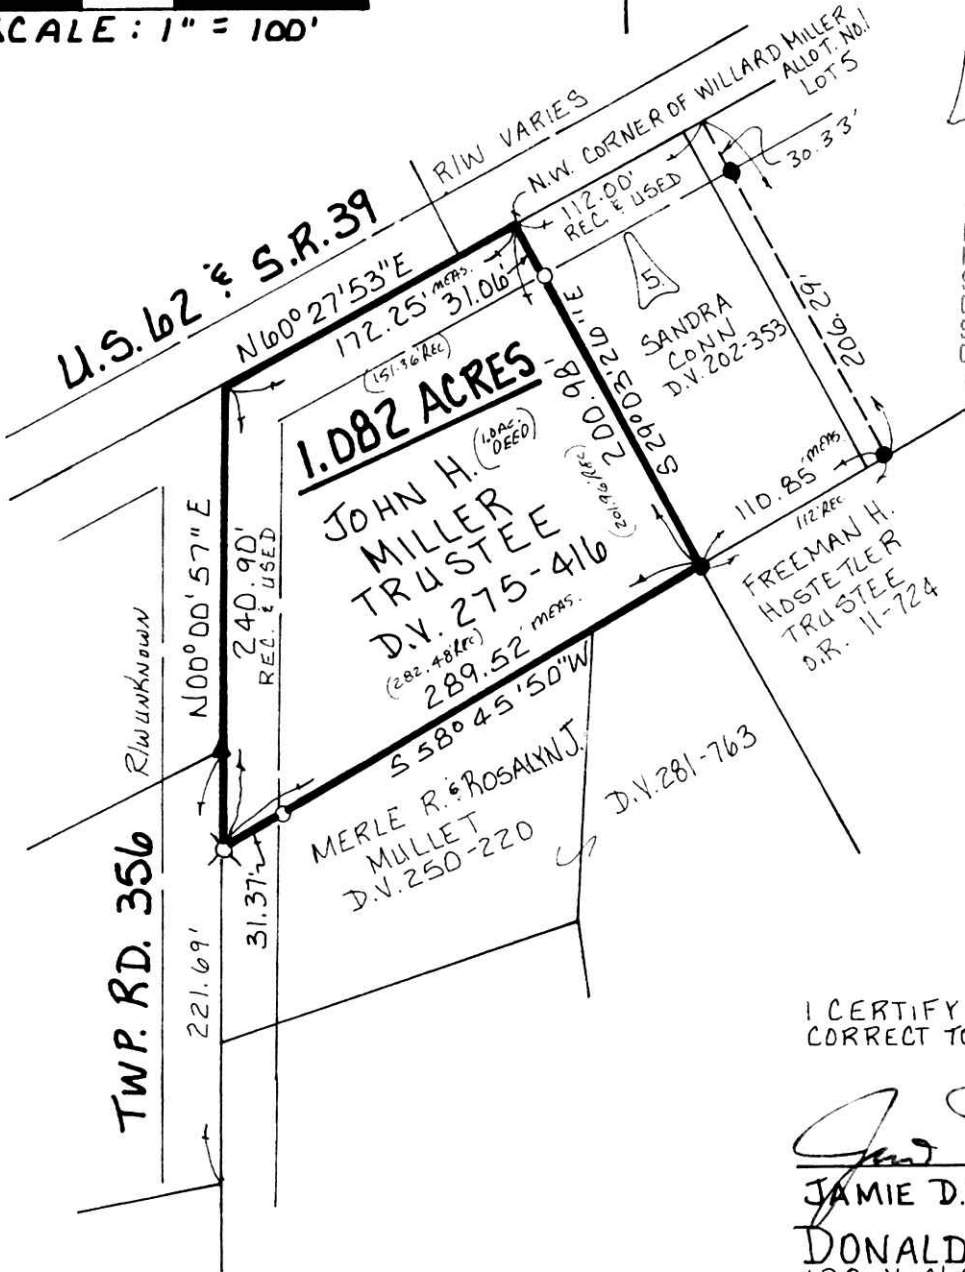

INDEXED
 199900005646
 Filed for Record in
 HOLMES COUNTY, OH
 SALLY MILLER
 On 11-23-1999 At 10:36 am.
 SMALL PLAT 20.00
 OR Book 17 Page 312 - 312
 OF Rec 42 Page 672

199900005646
 LAUREL SCHMID ATTY
 MILLERSBURG,



I CERTIFY THIS SURVEY TO BE
 CORRECT TO THE BEST OF MY KNOWLEDGE.

Jamie D. Darr

JAMIE D. DARR P.S. 7755

DONALD C. BAKER SURVEYING
 138 N. CLAY ST.
 MILLERSBURG, OHIO 44654
 PH: (330) 674-4788

OCTOBER 27, 1999 # 68299-FJM
 F.C.C.-J.D. DARR

PLAT APPROVED

11/22/99 b