


CLARK TOWNSHIP
 N.W. & S.W. QTRS. SECTION 6
 T-8N; R-4W
 HOLMES COUNTY, OHIO
 (SURVEYED FOR MERVIN & MARTHA TROYER)

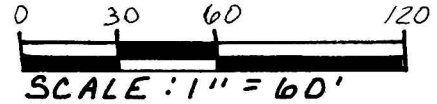

- IRON PIN FOUND
- 5/8" REBAR WITH I.D. CAP SET
- I.D. CAP MARKED "BAKER 6938"

REFERENCES:

- DEED VOL. 263 PAGE 994
- " " 174 " 74
- OFFICIAL RECORD Vol. 29 PAGE 362
- BEARINGS FROM DEED Vol. 263 PAGE 994




I CERTIFY THIS SURVEY TO BE CORRECT TO THE BEST OF MY KNOWLEDGE.

Donald C. Baker
 DONALD C. BAKER P.S. 6938
 DONALD C. BAKER SURVEYING
 338 N. CLAY ST.
 MILLERSBURG, OHIO 44654
 PH: (330) 674-4788

DECEMBER 2, 1999 #71299-FJM
 F.C.C. - F.D. BAKER

PLAT APPROVED

12/16/99

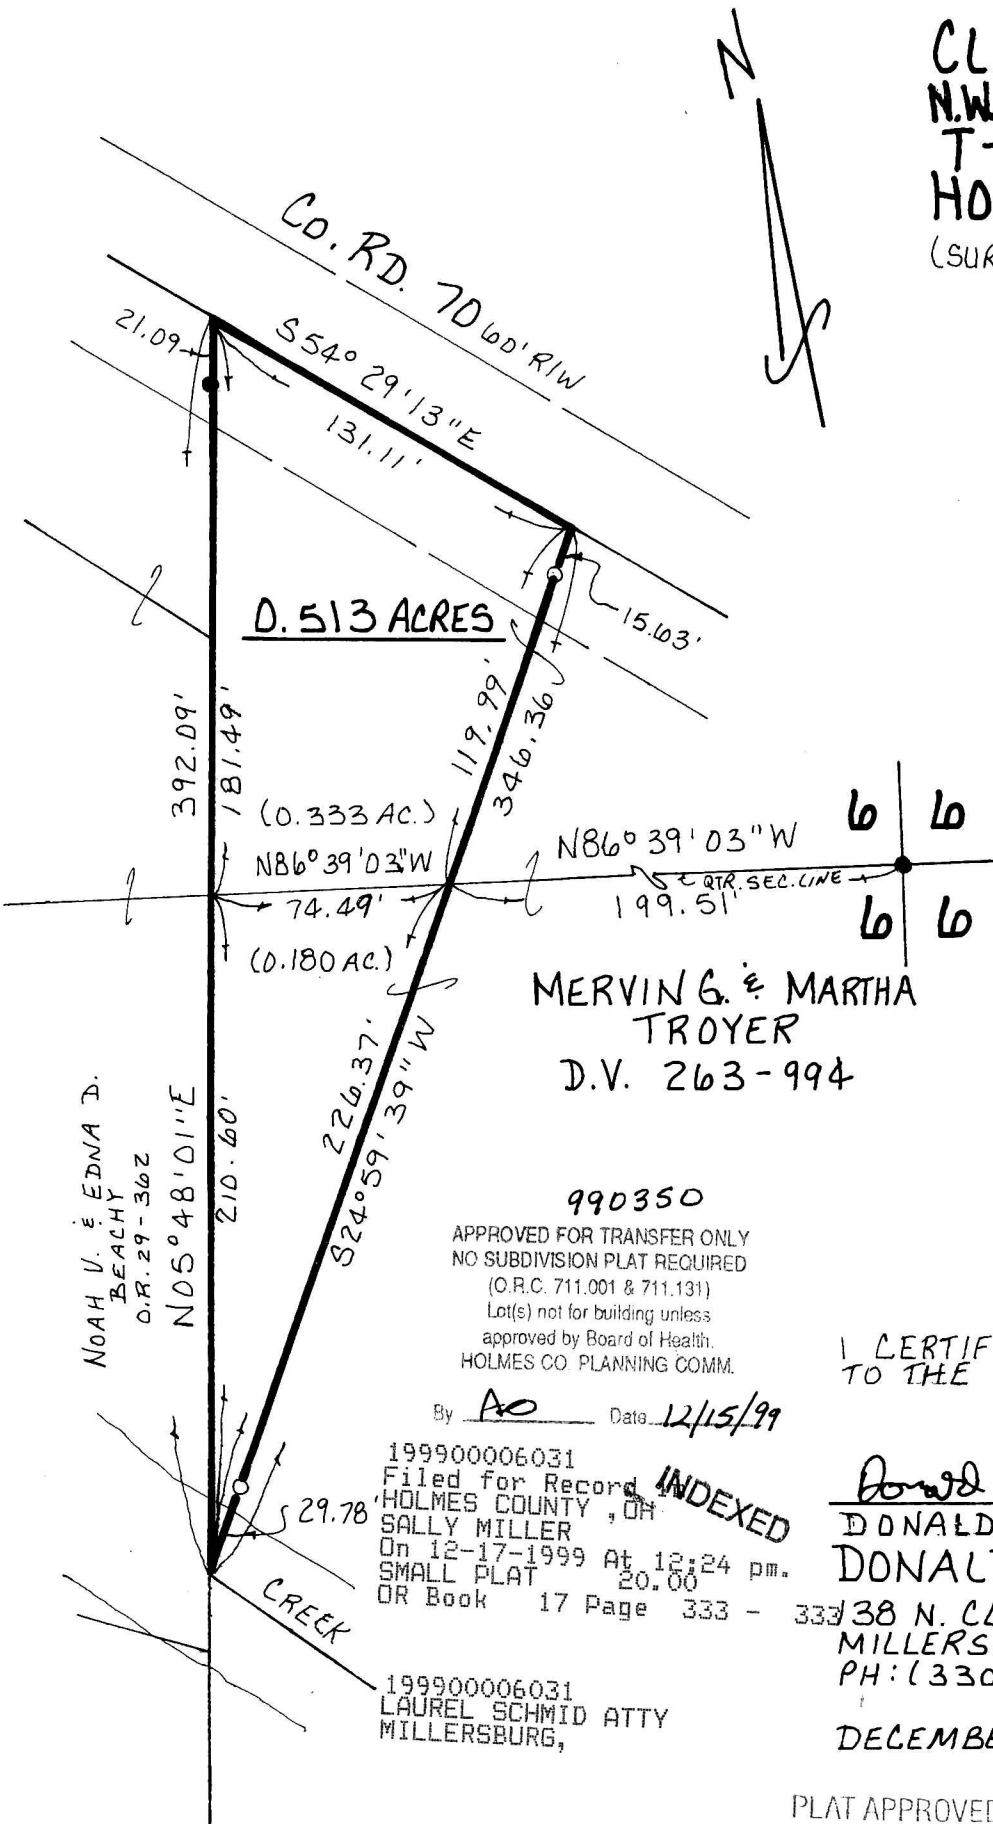

990350

APPROVED FOR TRANSFER ONLY
 NO SUBDIVISION PLAT REQUIRED
 (O.R.C. 711.001 & 711.131)
 Lot(s) not for building unless
 approved by Board of Health.
 HOLMES CO PLANNING COMM.

By *AO* Date *12/15/99*

199900006031
 Filed for Record
 HOLMES COUNTY, OH
 SALLY MILLER
 On 12-17-1999 At 12:24 pm.
 SMALL PLAT 20.00
 OR Book 17 Page 333 - 333

INDEXED

199900006031
 LAUREL SCHMID ATTY
 MILLERSBURG,

Noah V. & Edna D.
 Beachy
 O.R. 29-362
 N05° 48' 01" E