

- STONE FOUND
- ▲ R. R. SPIKE FOUND
- IRON PIN FOUND
- 5/8" RE BAR WITH I.D. CAP SET
- I.D. CAP MARKED "BAKER 6938"


MONROE TOWNSHIP
 2ND. QTR. LOT 13
 T-9N; R-8W
 HOLMES COUNTY, OHIO
 (SURVEYED FOR: ENDS A. BYLER)

REFERENCES:

DEED Vol. 253 PAGE 225
 PLAT Vol. 12 PAGE 697
 " " 10 " 497


BEARINGS ASSUMED

VOL 17 PAGE 360

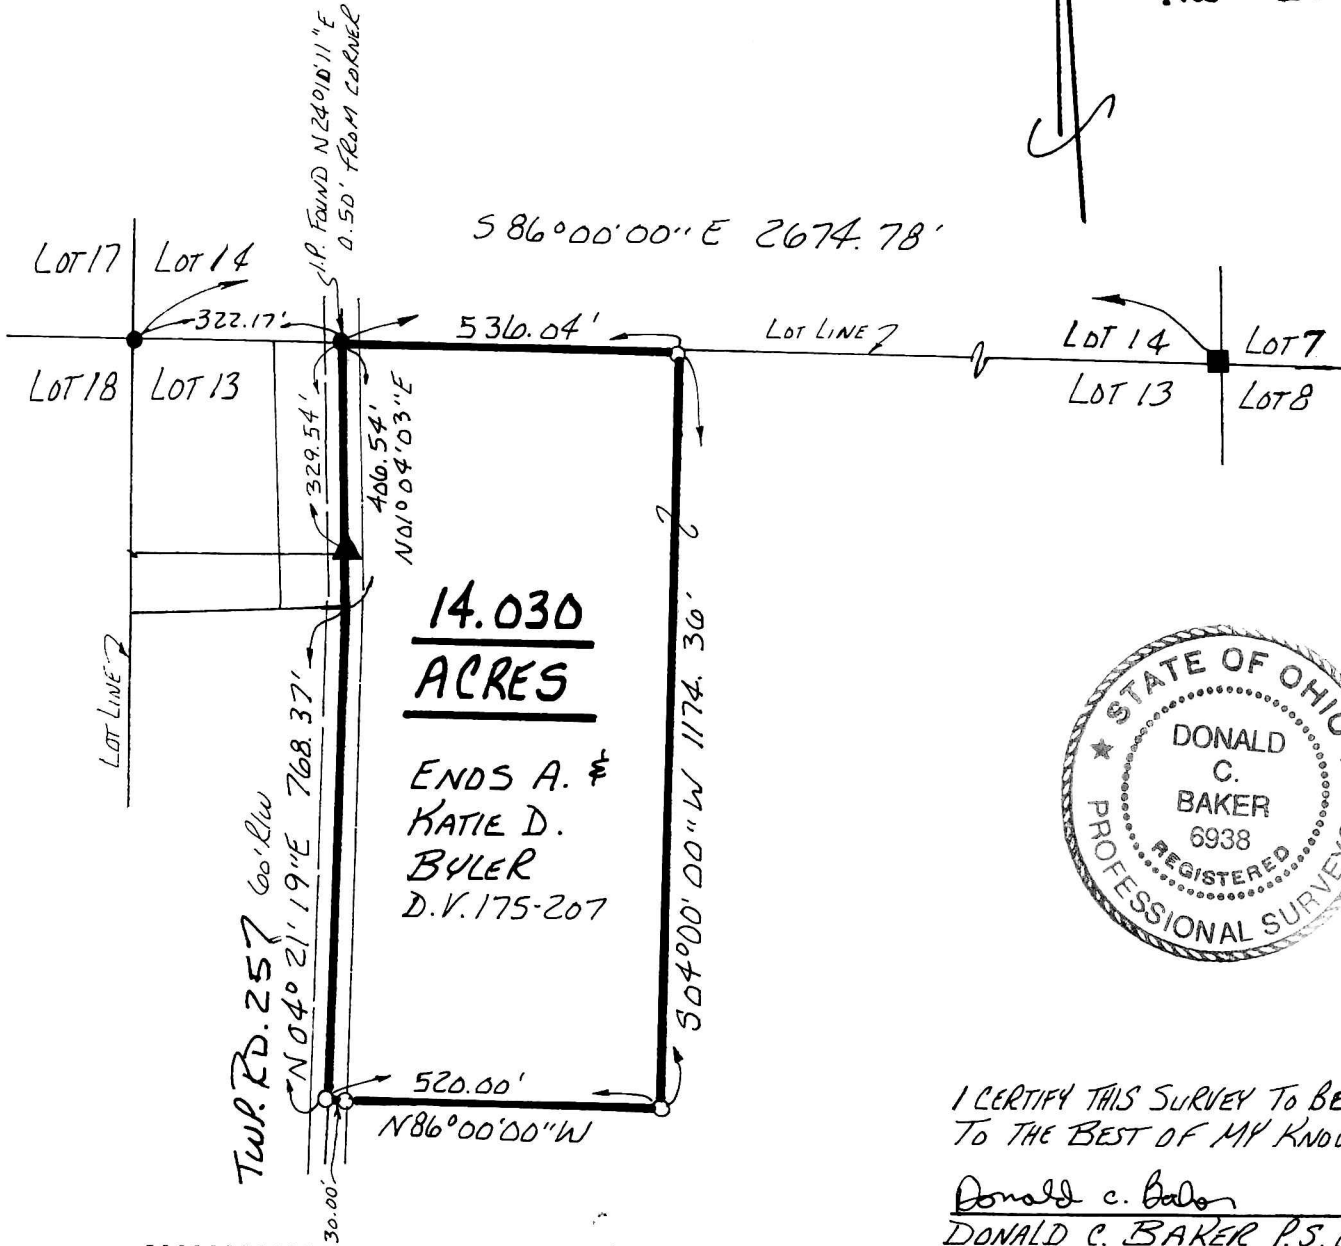

14.030
ACRES

ENDS A. &
 KATIE D.
 BYLER
 D.V. 175-207

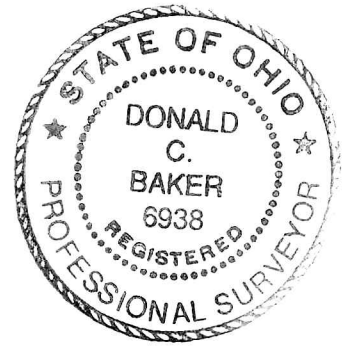

I CERTIFY THIS SURVEY TO BE CORRECT
 TO THE BEST OF MY KNOWLEDGE.

Donald C. Baker
 DONALD C. BAKER P.S. 6938
 DONALD C. BAKER SURVEYING
 138 N. CLAY ST.
 MILLERSBURG, OHIO 44654
 PH. (330) 674-4788

DECEMBER 7, 1999
 #78299-M.L. DAVIS
 F.C.C.-D.C. BAKER

PLAT APPROVED

1/14/00 RZ

200000000201
 Filed for Record in
 HOLMES COUNTY, OH
 SALLY MILLER
 On 01-14-2000 At 03:45 pm.
 SMALL PLAT 20.00
 OR Book 17 Page 360 - 360
 OR Vol 45 pg 578

200000000201
 MILLER & MAST ATTYS
 MILLERSBURG,

INDEXED