


WALNUT CREEK TOWNSHIP  
 3RD. QTR. LOT 4  
 T-9N; R-5W  
 HOLMES COUNTY, OHIO

(SURVEYED FOR HAROLD TROYER)

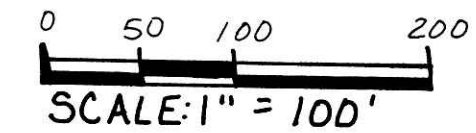

- STONE FOUND
- IRON PIN FOUND
- △ R.R. SPIKE SET
- 5/8" REBAR WITH I.D. CAP SET  
I.D. CAP MARKED "BAKER 6938"

REFERENCES:

DEED VOL. 182	PAGE 901
" "	183 " 468
" "	221 " 629
" "	263 " 171
" "	240 " 329
" "	203 " 342

BEARINGS FROM DEED VOL. 263 PAGE 171


PLAT VOL. 7	PAGE 754
" "	8 " 292
" "	14 " 551



I CERTIFY THIS SURVEY TO BE CORRECT  
 TO THE BEST OF MY KNOWLEDGE.

*Donald C. Baker*  
 DONALD C. BAKER P.S. 6938  
 DONALD C. BAKER SURVEYING  
 138 N. CLAY ST.  
 MILLERSBURG, OHIO 44654  
 PH: (330) 674-4788

NOVEMBER 22, 1999  
 # 75899-FJM  
 F.C.C. - F.D. BAKER

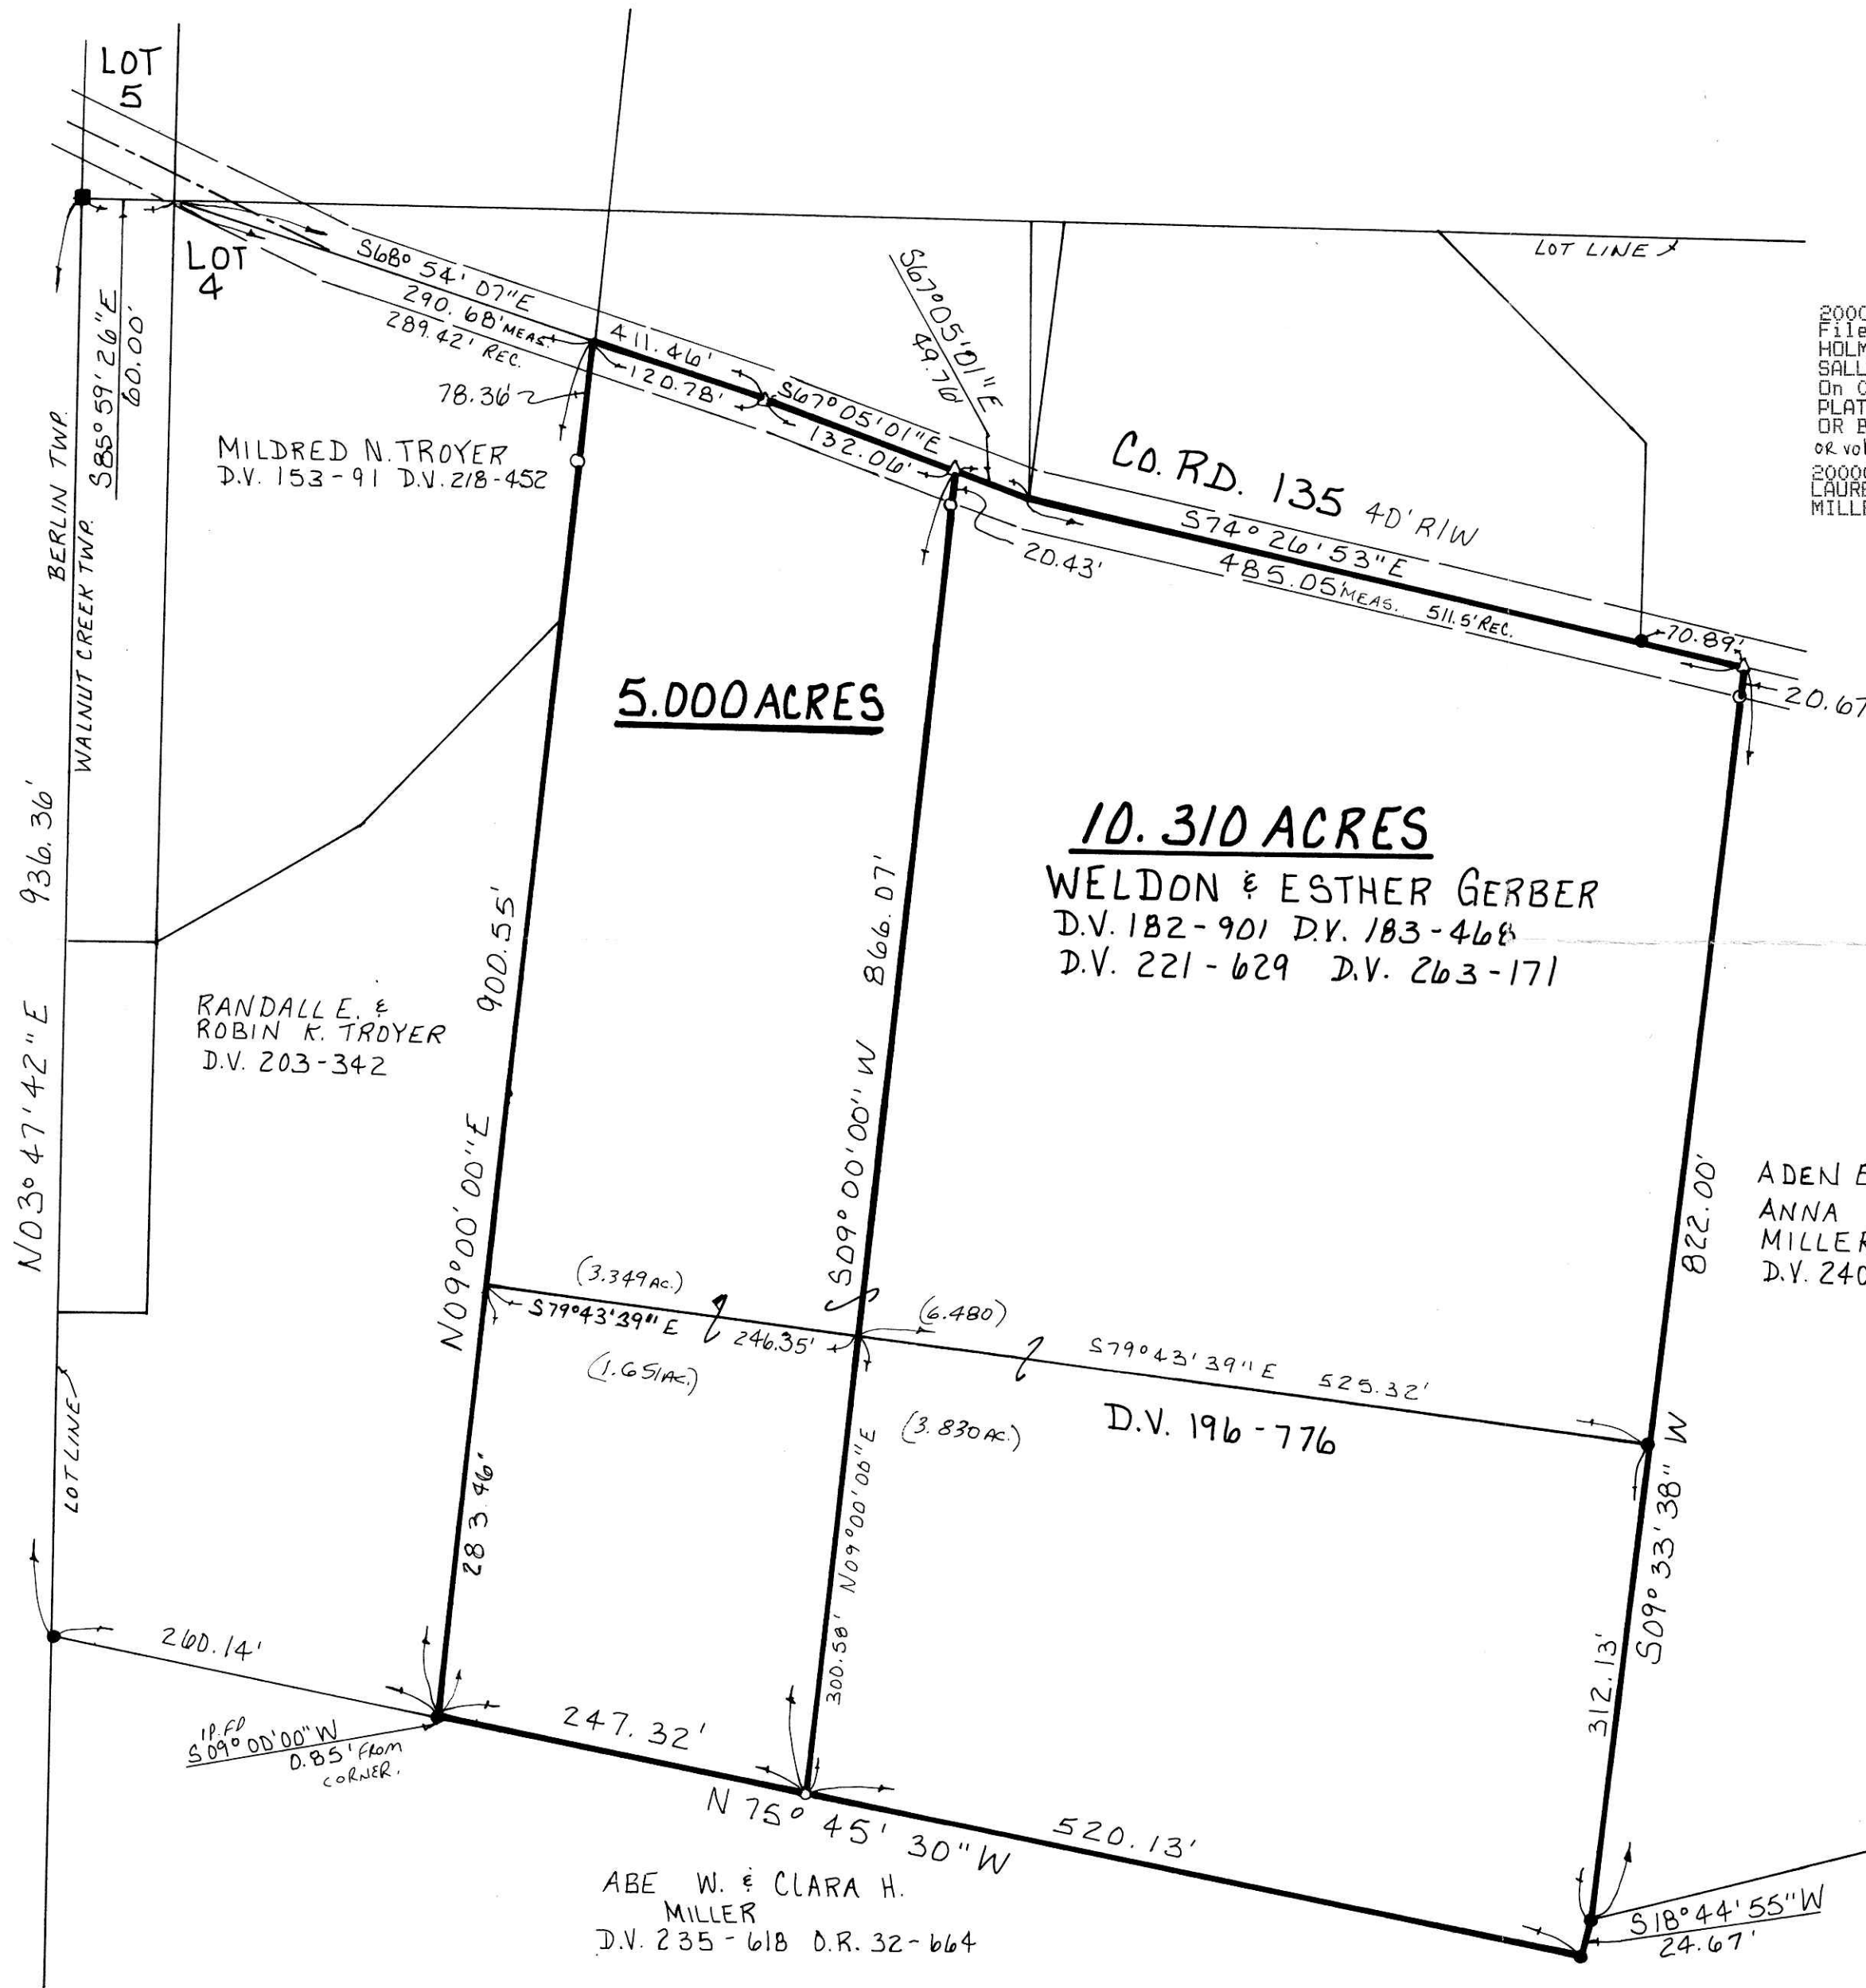

20000000673  
 Filed for Record in  
 HOLMES COUNTY, OH  
 SALLY MILLER  
 On 02-16-2000 At 12:06 pm.  
 PLAT MED 21.60  
 OR Book 17 Page 390 - 390  
 or vol 47pg 229  
 20000000673  
 LAUREL SCHMID ATTY  
 MILLERSBURG,

INDEXED

