

17 PAGE 406
KNOX TOWNSHIP
4TH. QTR. LOTS 27 & 28
T-9N; R-9W
HOLMES COUNTY, OHIO

(SURVEYED FOR: RONALD J. MILLER)



SCALE: 1" = 200'


- ▲ R.R. SPIKE FOUND
- IRON PIN FOUND
- STONE FOUND
- △ R.R. SPIKE SET



I CERTIFY THIS SURVEY TO BE CORRECT
 TO THE BEST OF MY KNOWLEDGE.

Jamie D. Darr
JAMIE D. DARR P.S. 7755
DONALD C. BAKER SURVEYING
 138 N. CLAY ST.
 MILLERSBURG, OHIO 44654
 PH. (330) 674-4788
 FEBRUARY 11, 2000
 #4800 - M.L. DAVIS
 F.C.C. - J.D. DARR

BEARINGS FROM PLAT VOL. 7 PAGE 200

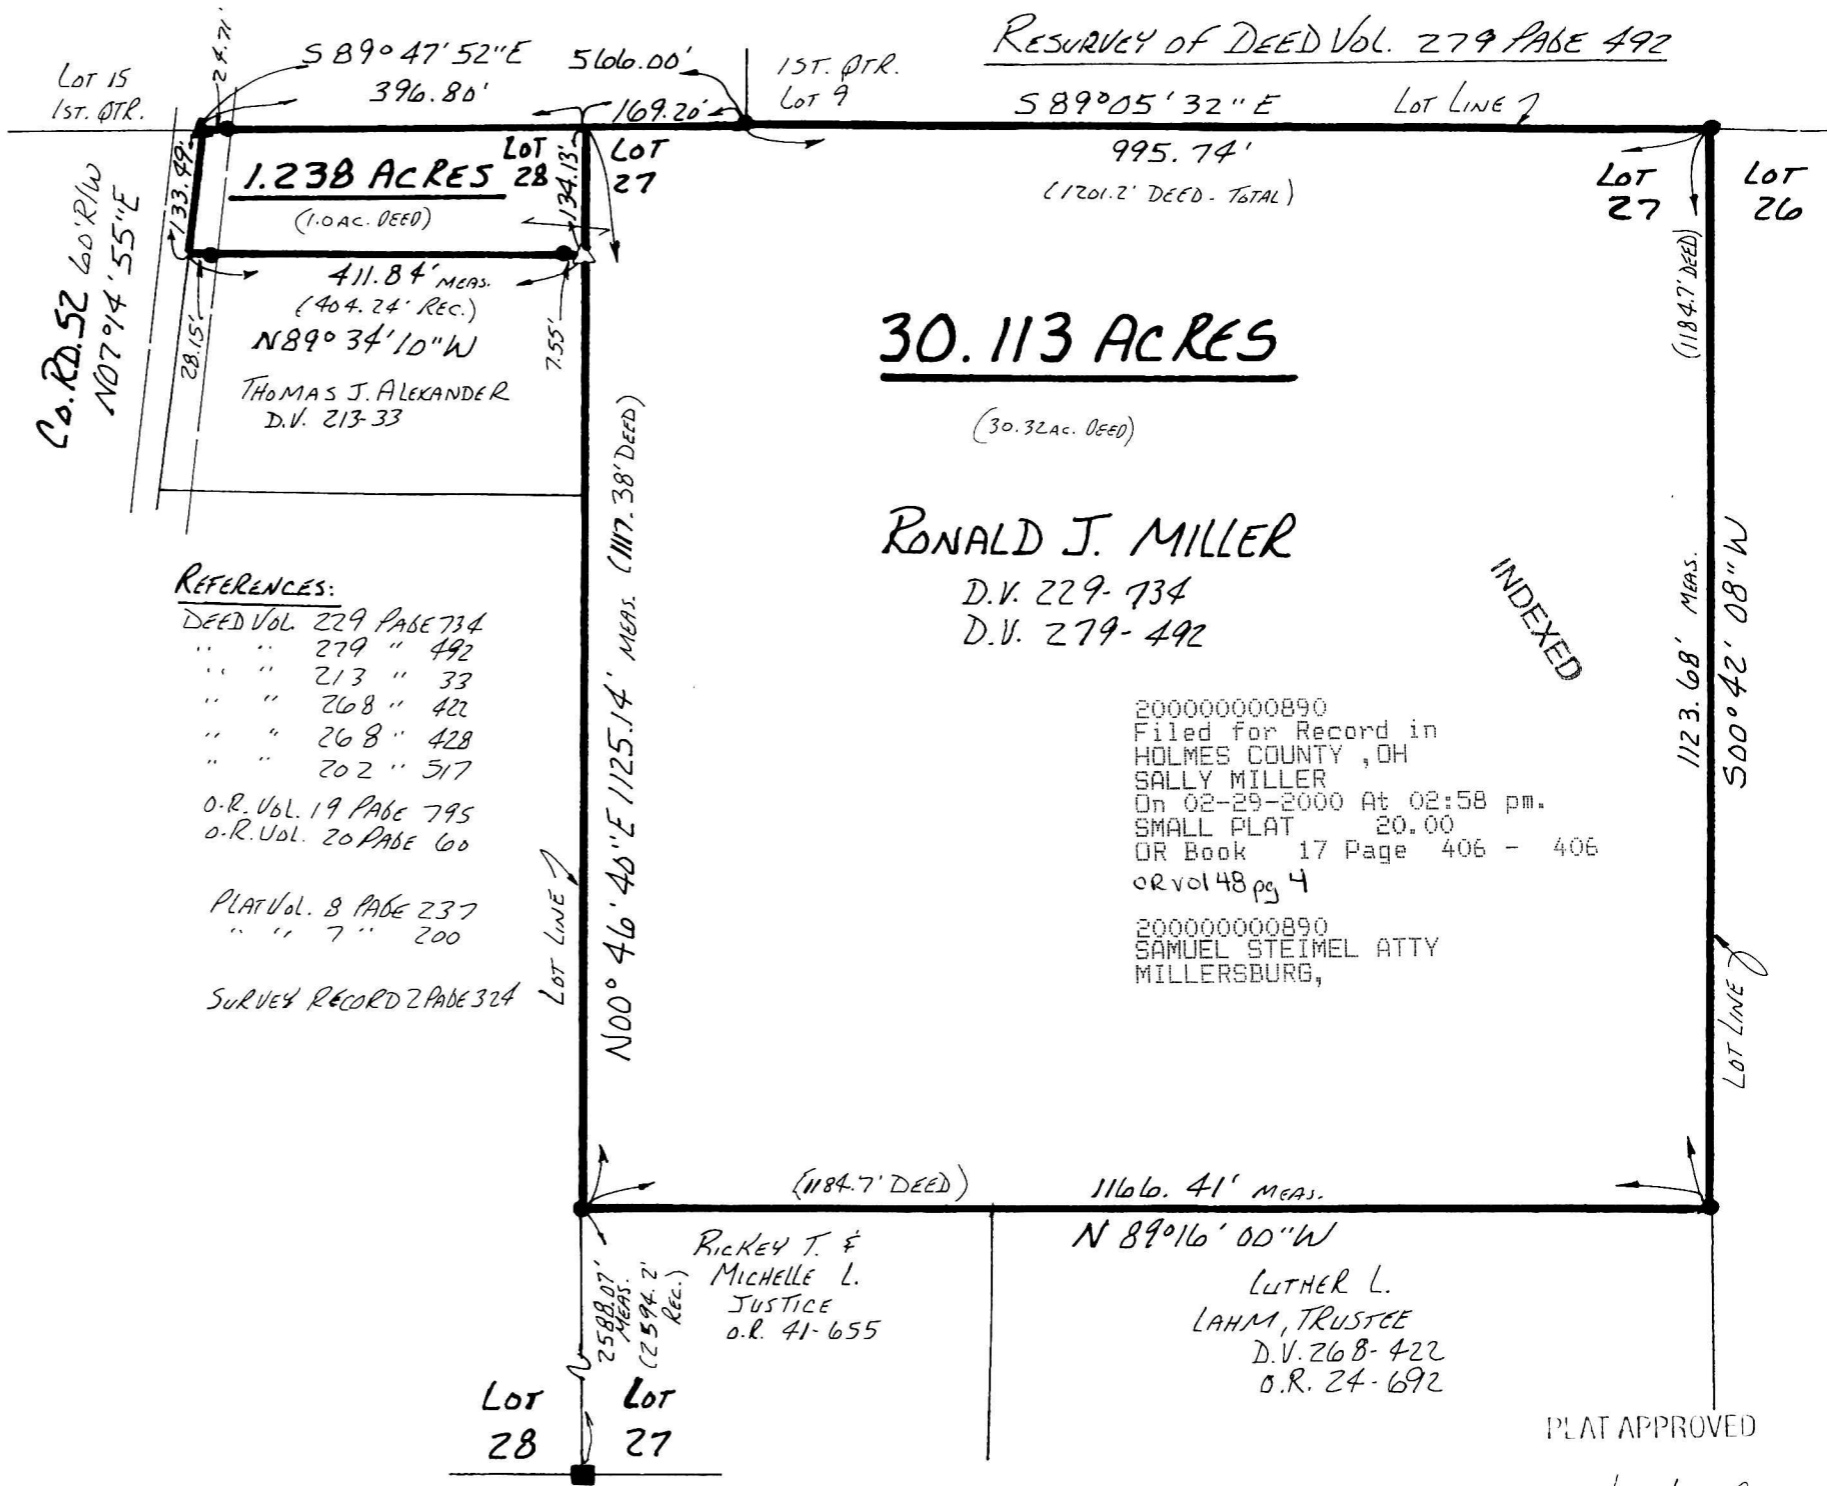

PLAT APPROVED

2/25/00 J.D.