


BERLIN TOWNSHIP N.W. QTR. SECTION 5 T-9N; R-5W HOLMES COUNTY, OHIO

(SURVEYED FOR ABE D. & VERNA WEAVER)



- ▲ R.R. SPIKE FOUND
- IRON PIN FOUND
- 5/8" REBAR WITH I.D. CAP SET I.D. CAP MARKED "BAKER 6938"

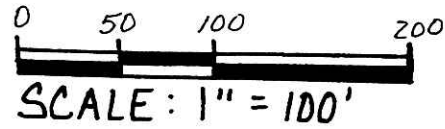

I CERTIFY THIS SURVEY TO BE CORRECT TO THE BEST OF MY KNOWLEDGE.

Donald C. Baker
 DONALD C. BAKER P.S. 6938
 DONALD C. BAKER SURVEYING
 138 N. CLAY ST.
 MILLERSBURG, OHIO 44654
 PH: (330) 674-4788

FEBRUARY 7, 2000
 #3800-FJM
 (200 Com.)
 F.C.C.: F.D. BAKER



000055
 APPROVED FOR TRANSFER ONLY
 NO SUBDIVISION PLAT REQUIRED
 (O.R.C. 711.001 & 711.131)
 Lot(s) not for building unless
 approved by Board of Health.
 HOLMES CO. PLANNING COMM.
 By AD Date 2/29/00

REFERENCES:


DEED VOL. 212 PAGE 226
 " " 235 " 171
 " " 256 " 380
 " " 256 " 378
 " " 242 " 563

OFFICIAL RECORD VOL. 41 PAGE 205
 BEARINGS FROM DEED VOL. 249
 PAGE 678.

PLAT VOL. 10 PAGE 101
 " " 4 " 158
 " " 12 " 164

200000000927
 Filed for Record in
 HOLMES COUNTY, OH
 SALLY MILLER
 On 03-02-2000 At 10:56 am.
 SMALL PLAT 20.00
 OR Book 17 Page 407 - 407
 OR vol 48 pg 101

INDEXED

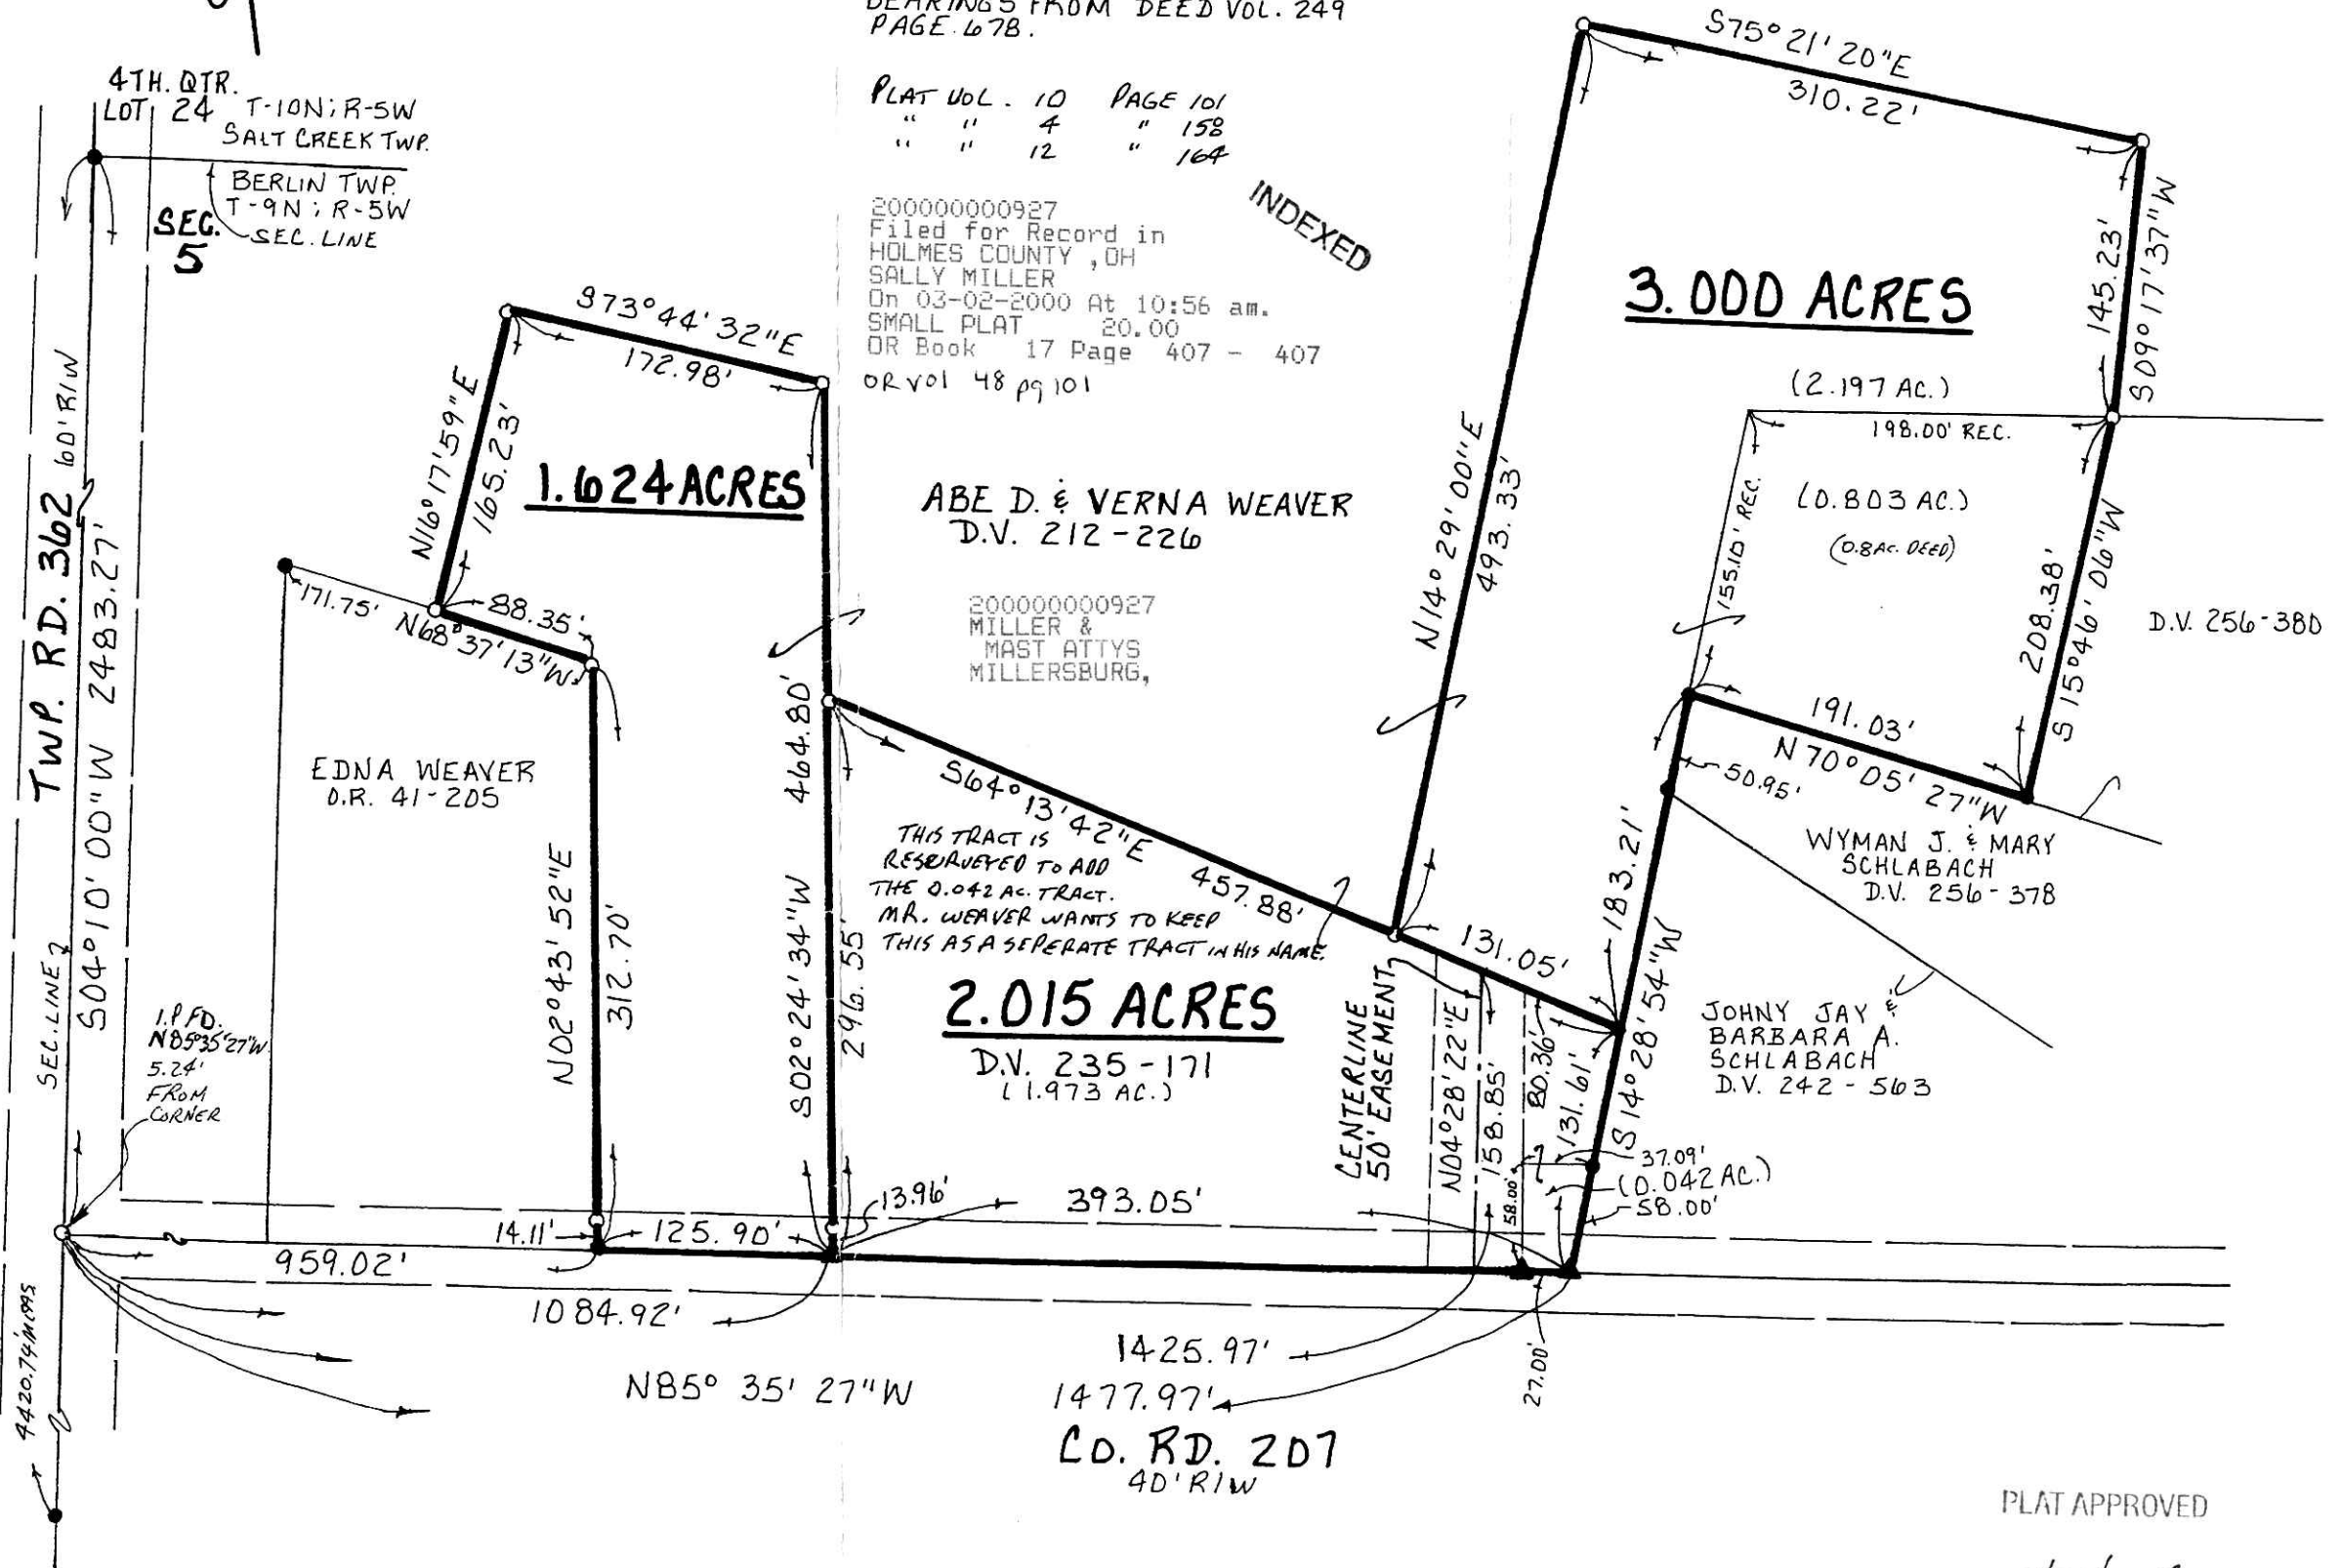

PLAT APPROVED
2/29/00