

RESURVEY OF DEED VOL. 264 PAGE 720


REFERENCES:

DEED VOL. 197 PAGE 218
" " 264 " 720


BEARINGS FROM DEED VOL. 264
PAGE 720.

BERLIN TOWNSHIP
N.E. QTR. SECTION 15
T-9N; R-5W
HOLMES COUNTY, OHIO

(SURVEYED FOR HOMER CRILOWESTATE)

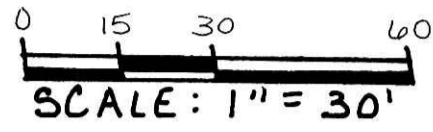


- IRON PIN FOUND
- 5/8" REBAR WITH I.D. CAP SET
- I.D. CAP MARKED "BAKER 6938"

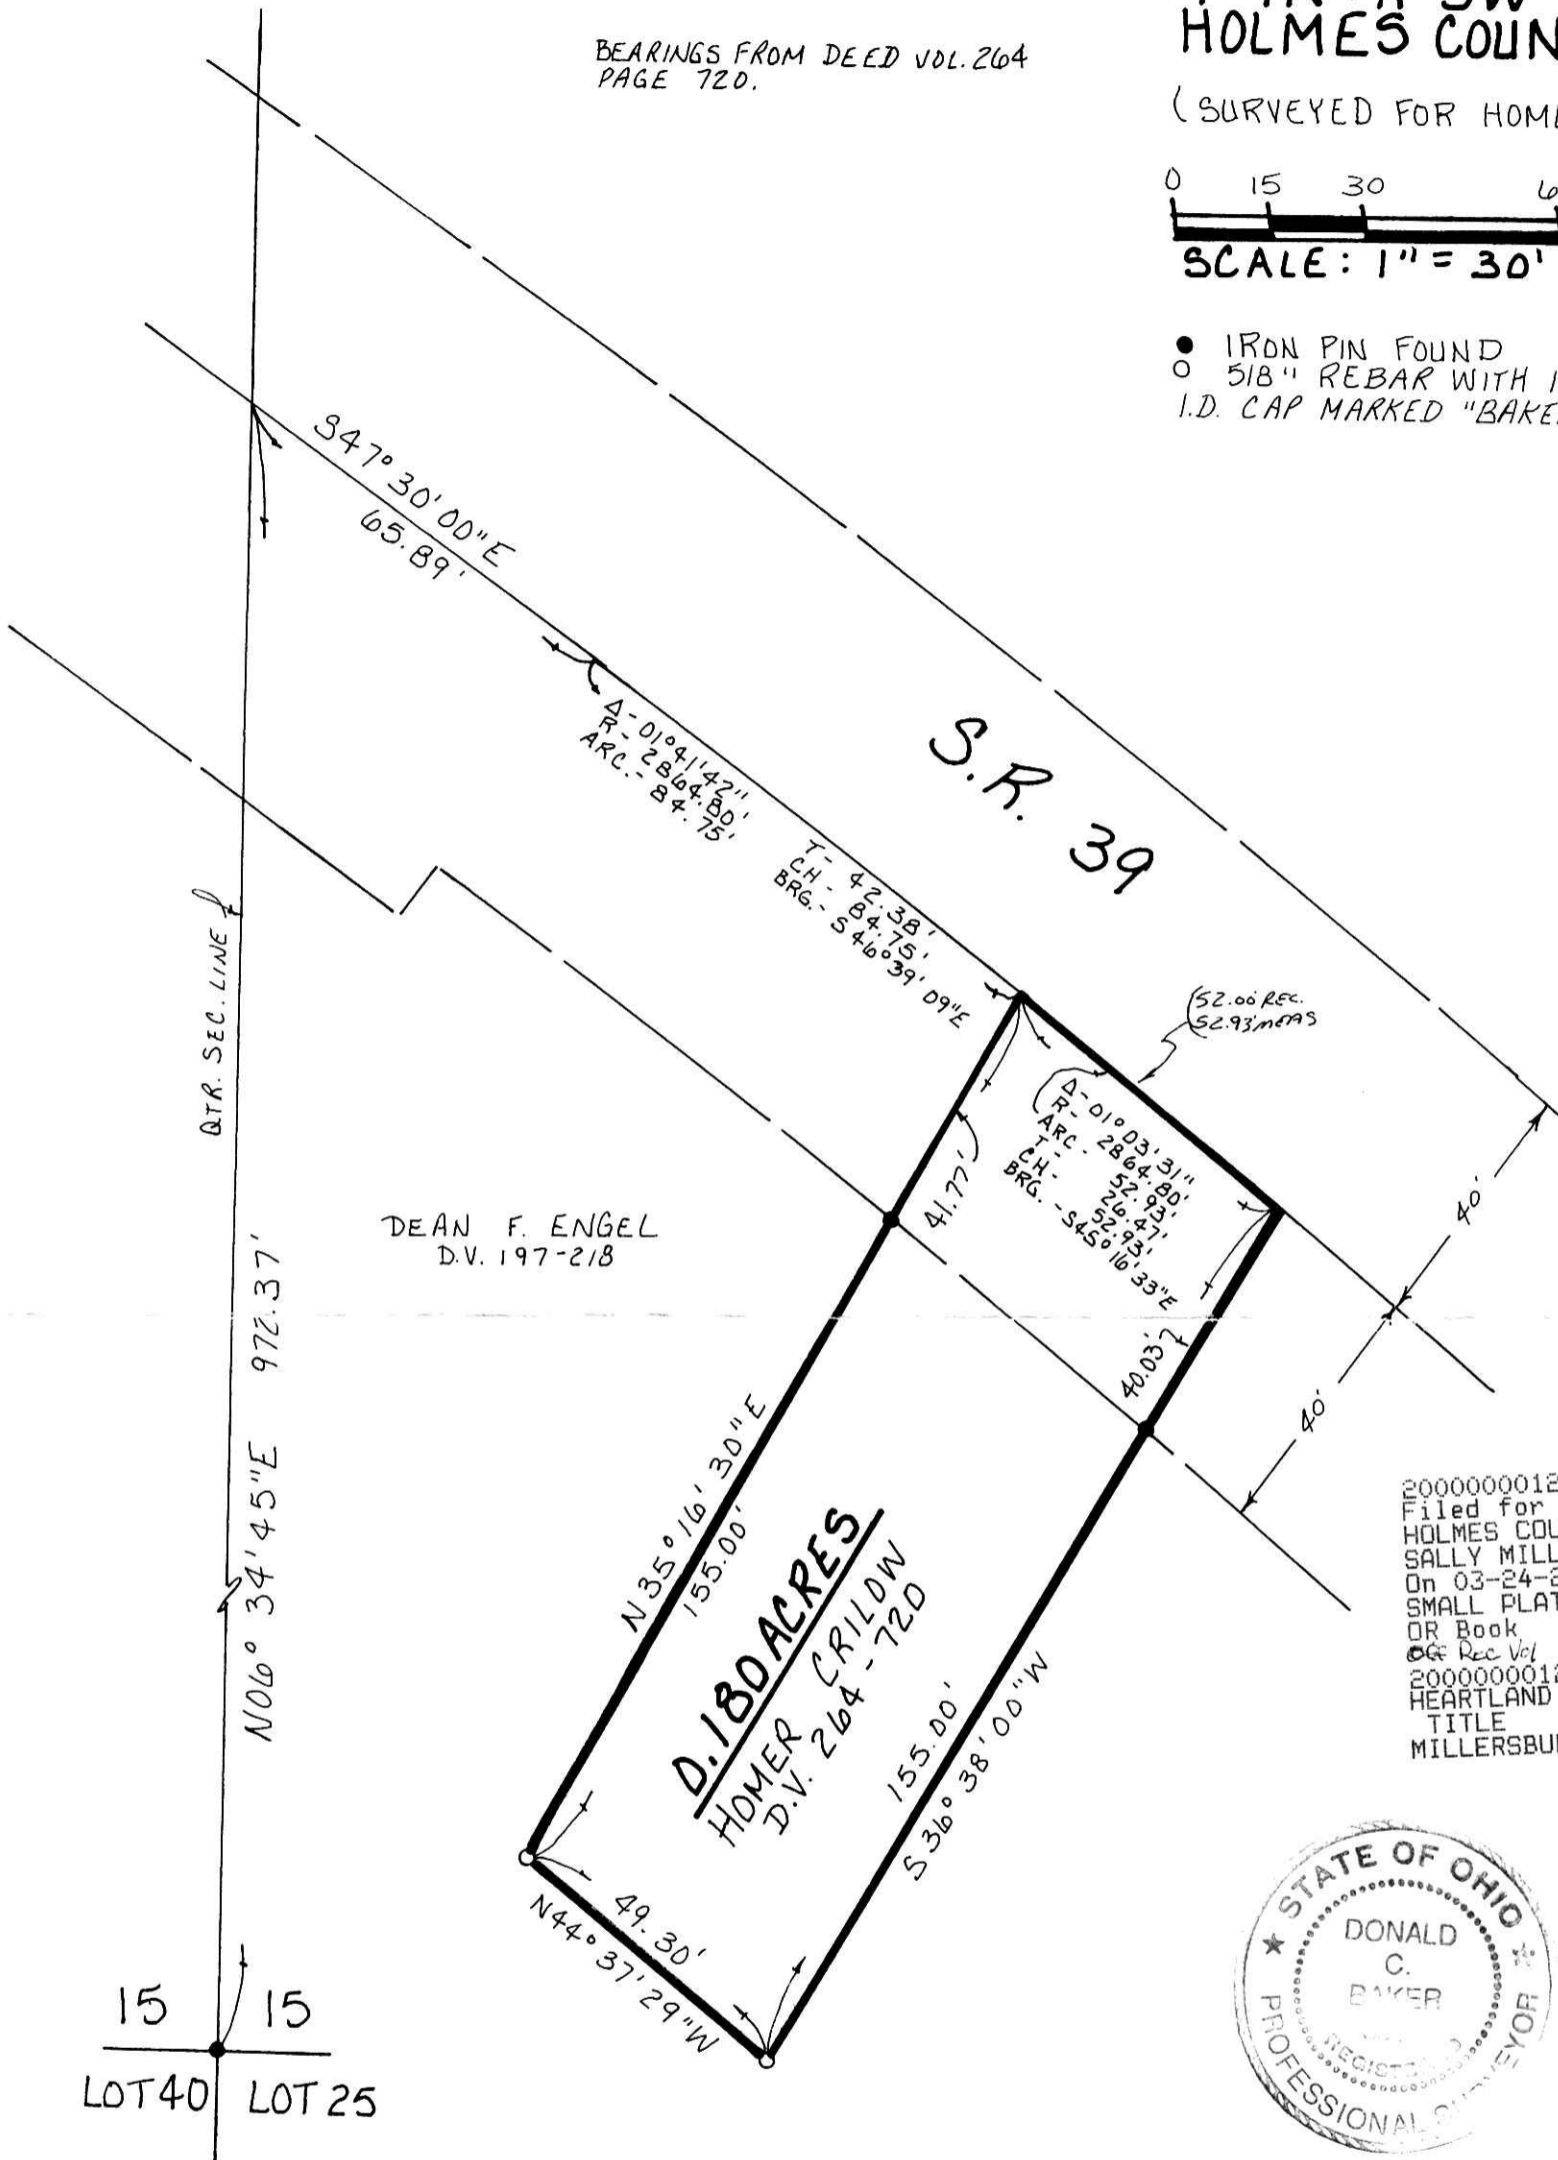

200000001293
 Filed for Record in
 HOLMES COUNTY, OH
 SALLY MILLER
 On 03-24-2000 At 02:22 pm.
 SMALL PLAT 20.00
 OR Book 17 Page 436 - 436
 OR Rec Vol 49 Page 321
 200000001293
 HEARTLAND
 TITLE
 MILLERSBURG,

INDEXED

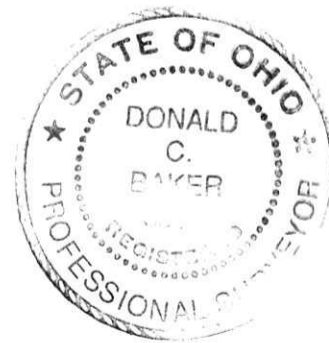

I CERTIFY THIS SURVEY TO BE CORRECT
TO THE BEST OF MY KNOWLEDGE.

Donald C. Baker
 DONALD C. BAKER P.S. 6938
 DONALD C. BAKER SURVEYING
 138 N. CLAY ST.
 MILLERSBURG, OHIO 44654
 PH: (330) 674-4788

FEBRUARY 25, 2000

1070D-FJM
F.C.C. - F.D. BAKER

PLAT APPROVED

3/13/00 *BJ*