


KNOX TOWNSHIP
4TH. QTR. LOT 24
T-9N; R-9W
HOLMES COUNTY, OHIO

(SURVEYED FOR JAMES & MAE MUMAW)

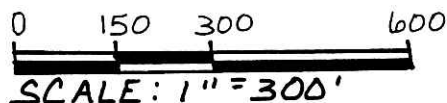

- STONE FOUND
- ▲ R.R. SPIKE FOUND
- IRON PIN FOUND

REFERENCES:

DEED VOL. 169	PAGE 173
" " 267	" 768
" " 259	" 726
" " 269	" 622
" " 245	" 770
" " 197	" 614

OFFICIAL RECORD VOL. 29 PAGE 905

BEARINGS FROM PLAT VOL. 8 PAGE 70B



I CERTIFY THIS SURVEY TO BE CORRECT TO THE BEST OF MY KNOWLEDGE.


J. D. Darr
JAMIE D. DARR P.S. 7755
DONALD C. BAKER SURVEYING
 138 N. CLAY ST.
 MILLERSBURG, OHIO 44654
 PH: (330) 674-4788

JULY 22, 1999

46699-FJM
 F.C.C.-J.D. DARR

Ⓐ DAVID W. & KIMBERLY A. HANNA
 D.V. 235-121

Ⓑ HOLMES COUNTY HABITAT FOR
 HUMANITY, INC. O.R. 29-905

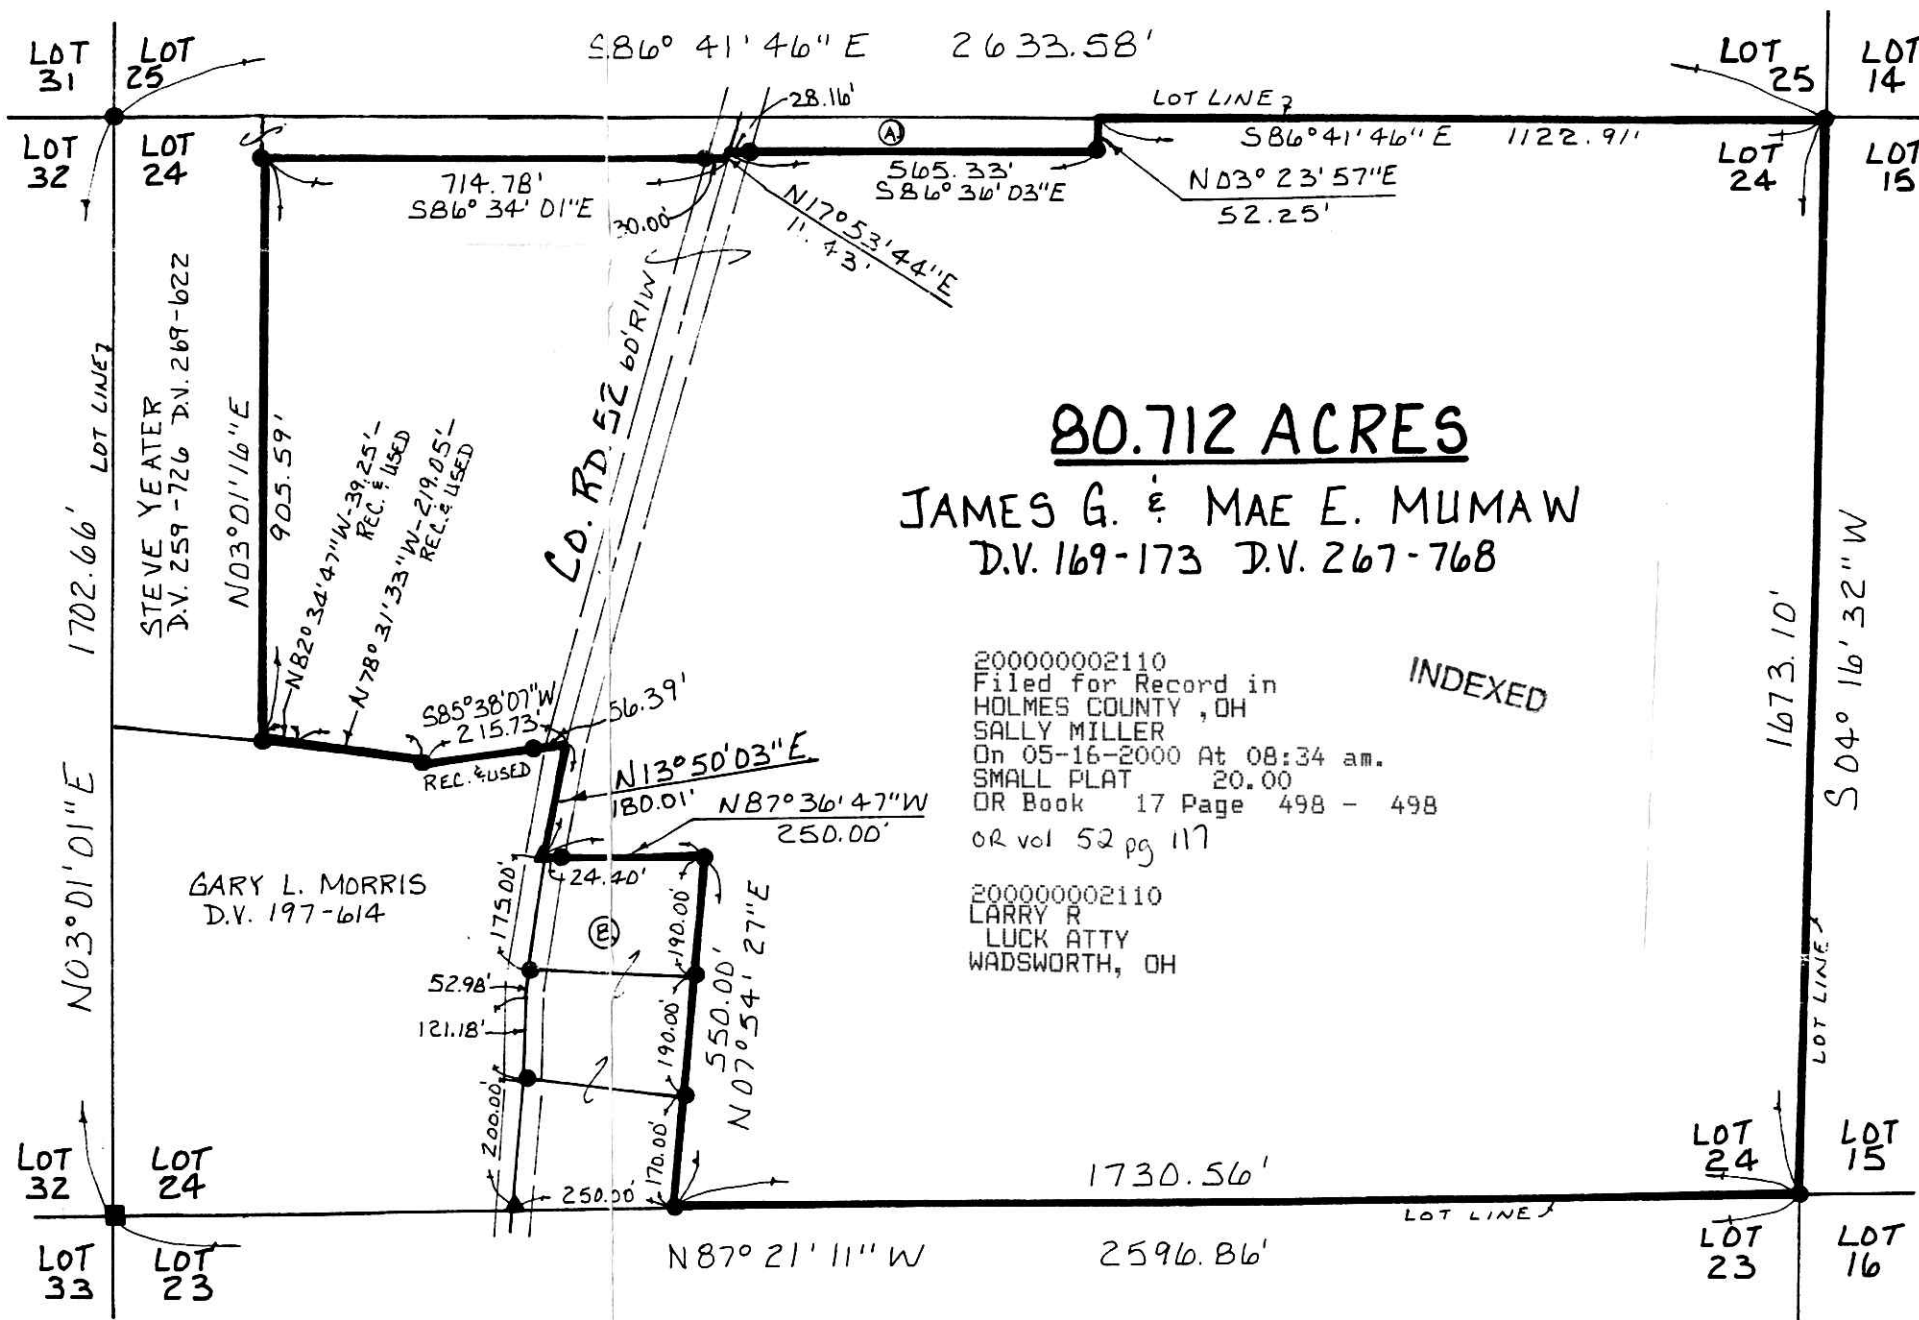

200000002110
 Filed for Record in
 HOLMES COUNTY, OH
 SALLY MILLER
 On 05-16-2000 At 08:34 am.
 SMALL PLAT 20.00
 OR Book 17 Page 498 - 498
 or vol 52 pg 117

INDEXED

200000002110
 LARRY R
 LUCK ATTY
 WADSWORTH, OH

PLAT APPROVED

4/28/00-B