


WALNUT CREEK TOWNSHIP  
3RD. QTR. LOT 6  
T-9N; R-5W  
HOLMES COUNTY, OHIO  
(SURVEYED FOR DALEN MAST & BENJAMIN JR. MAST)

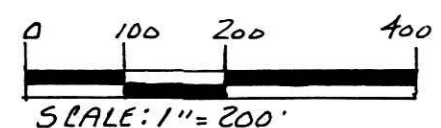

- SCALE: 1" = 200'
- STONE FOUND
  - IRON PIN FOUND
  - 5/8" REBAR WITH I.D. CAP SET  
I.D. CAP MARKED "BAKER 6938"

REFERENCES:  
DEED Vol. 262 PAGE 623  
" " 231 " 439  
" " 253 " 591

BEARINGS FROM PLAT Vol. 4 PAGE 149

200000003224  
Filed for Record in  
HOLMES COUNTY, OH  
SALLY MILLER  
On 07-25-2000 At 01:30 pm.  
SMALL PLAT 20.00  
OR Book 17 Page 576 - 576  
OR Vol 55 pg 851  
200000003224  
HEARTLAND TITLE  
MILLERSBURG, OH 44654


INDEXED

I CERTIFY THIS SURVEY TO BE CORRECT TO THE BEST OF MY KNOWLEDGE.

*Jamie D. Darr*  
JAMIE D. DARR P.S. 7755  
DONALD C. BAKER SURVEYING  
138 N. CLAY ST.  
MILLERSBURG, OHIO 44654  
PH. (330) 674-4788

MAY 25, 2000

# 22200 - M.L. DAVIS  
F.C.C. - J.D. DARR

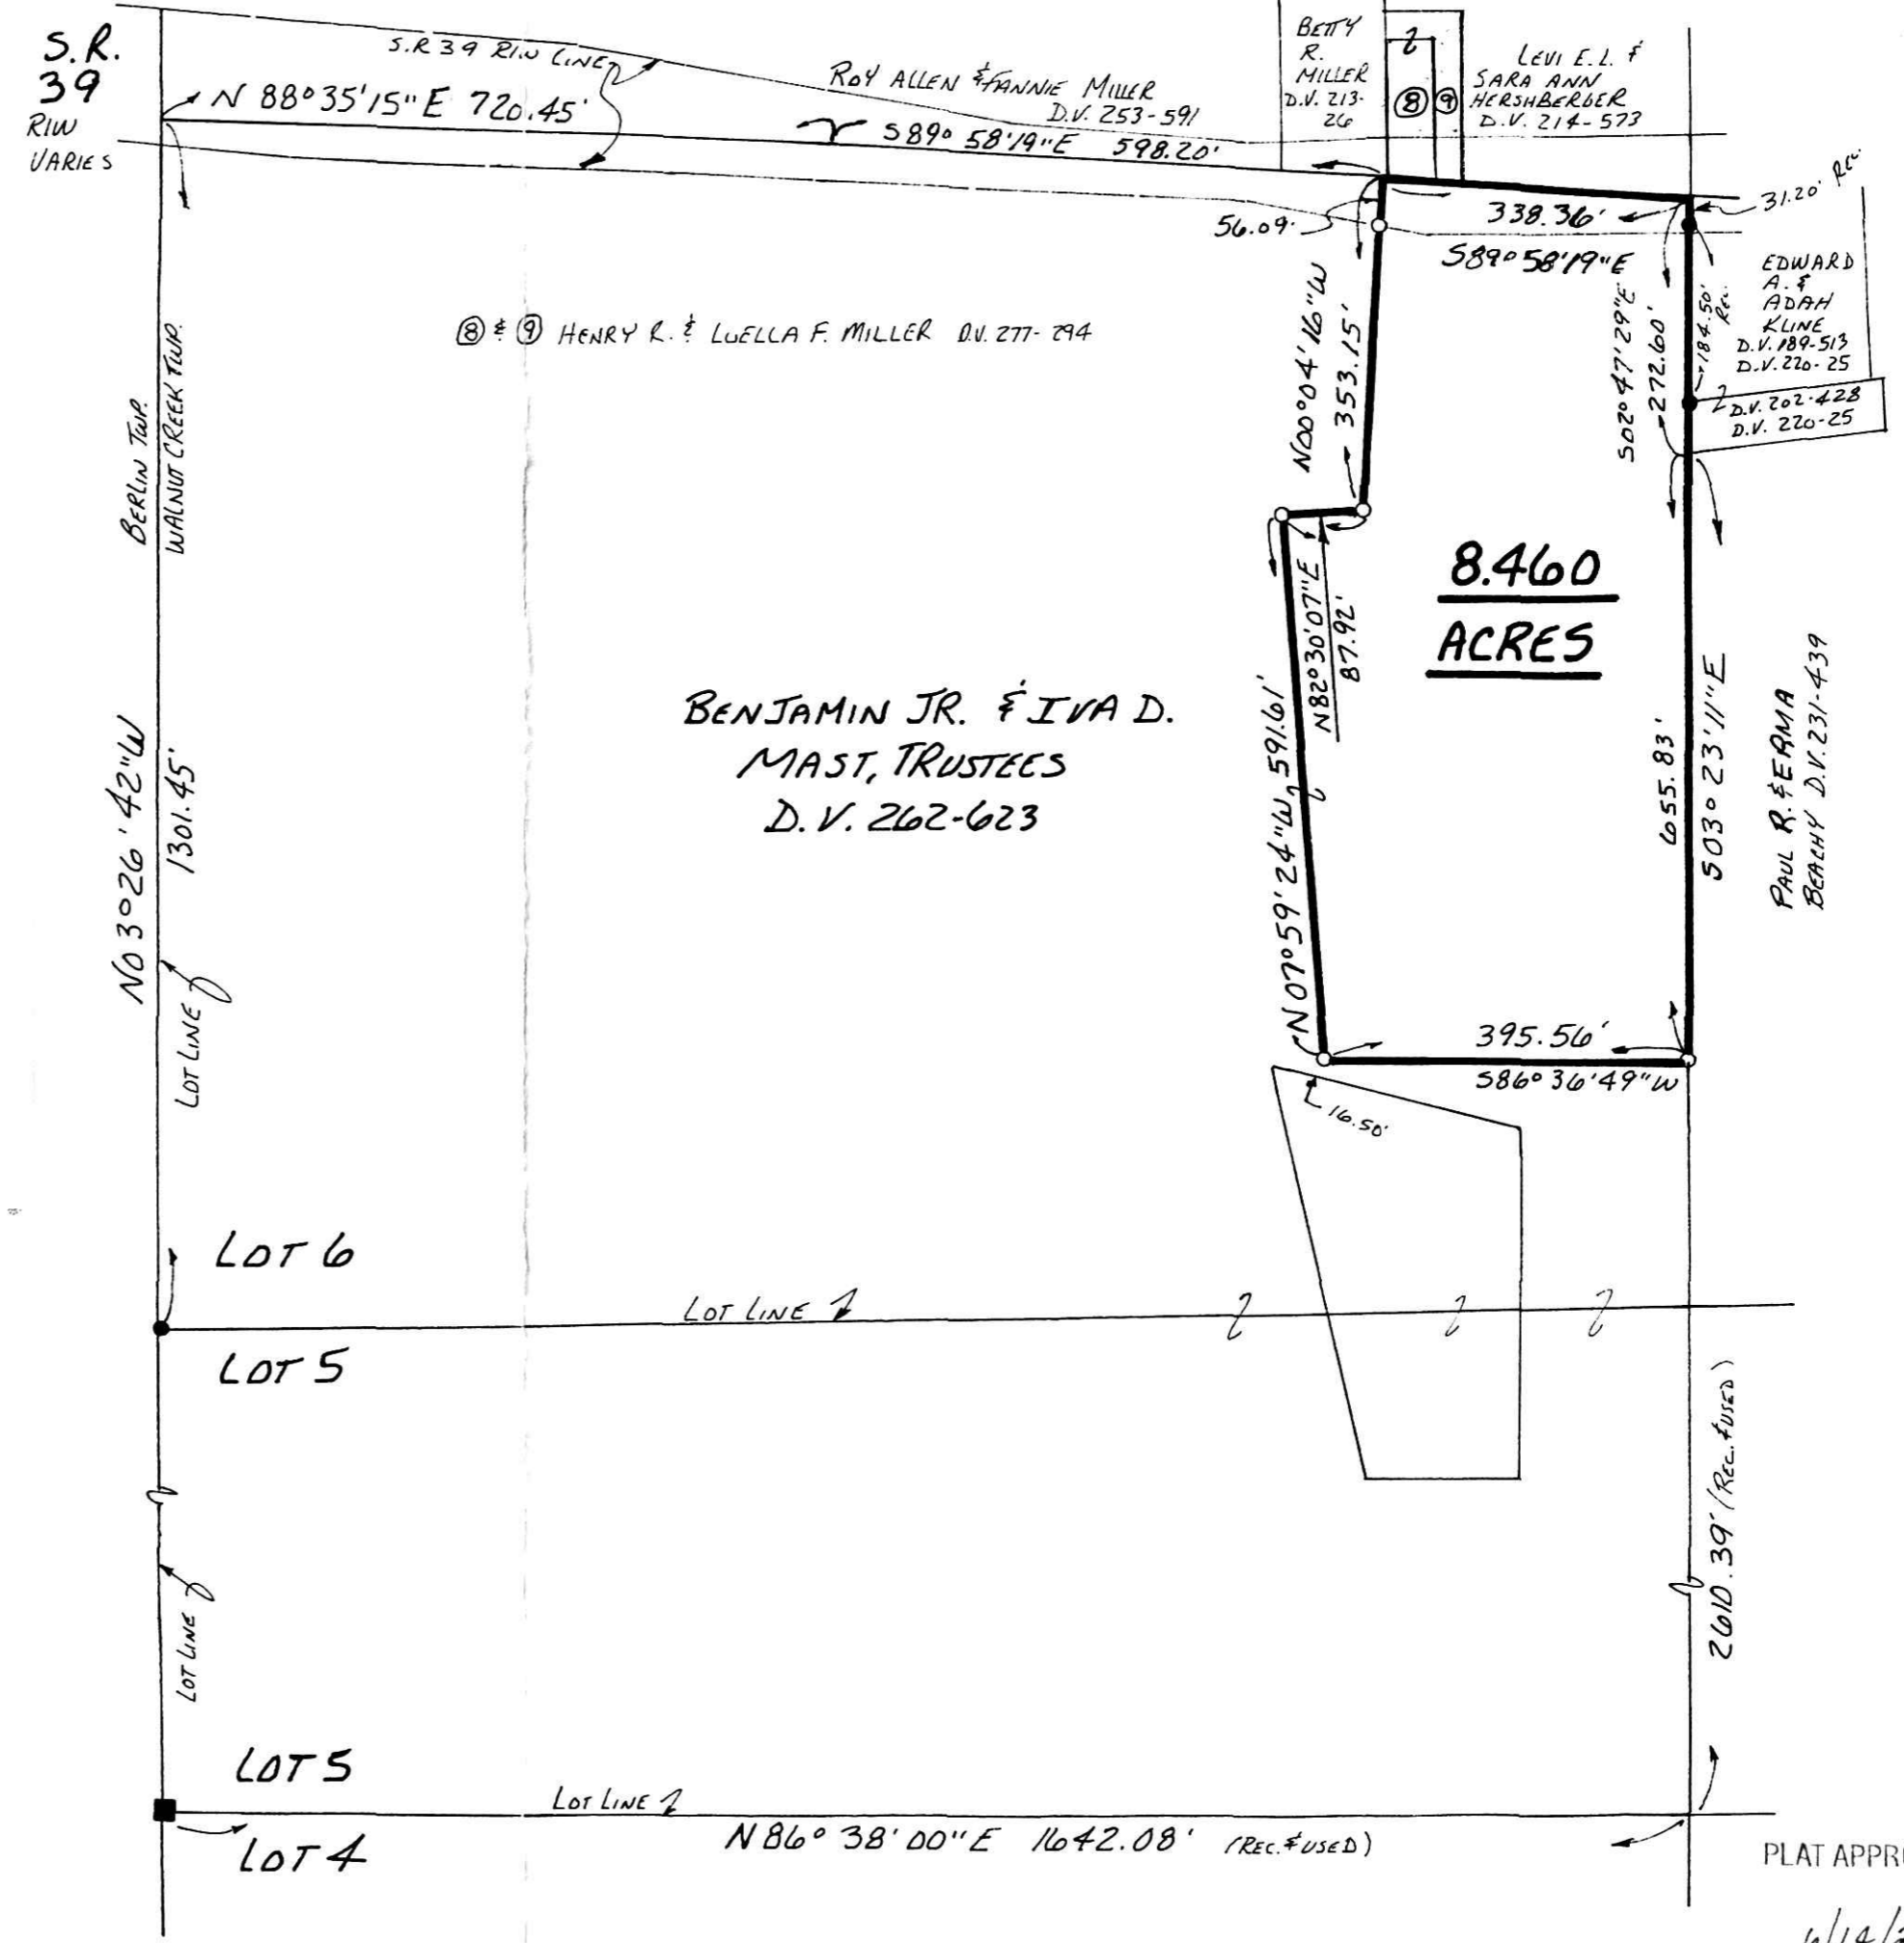

PLAT APPROVED

6/14/2000