


PAINT TOWNSHIP N.E.&N.W. QTR. SECTION 25 T-15 N; R-11 W HOLMES COUNTY, OHIO

SURVEYED FOR URIA N. PETERSHEIM

- 5/8" REBAR WITH I.D. CAP SET
- I.D. CAP MARKED "BAKER 6938"
- STONE FOUND
- R RECORD
- U USED

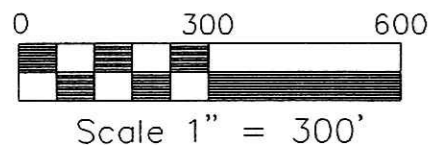


RESURVEY OF DEED VOLUME 243 PAGE 96

REFERENCES:

- DEED VOL. 220 P. 859
- DEED VOL. 250 P. 49
- DEED VOL. 161 P. 585
- DEED VOL. 243 P. 96
- PLAT VOL. 15 P. 33


BASIS BEARINGS:
PLAT VOLUME 12 PAGE 273

20000003708
 Filed for Record in
 HOLMES COUNTY, OH
 SALLY MILLER
 On 08-25-2000 At 02:48 pm.
 SMALL PLAT 20.00
 OR Book 17 Page 613 - 613
 OR vol 57 pg 501

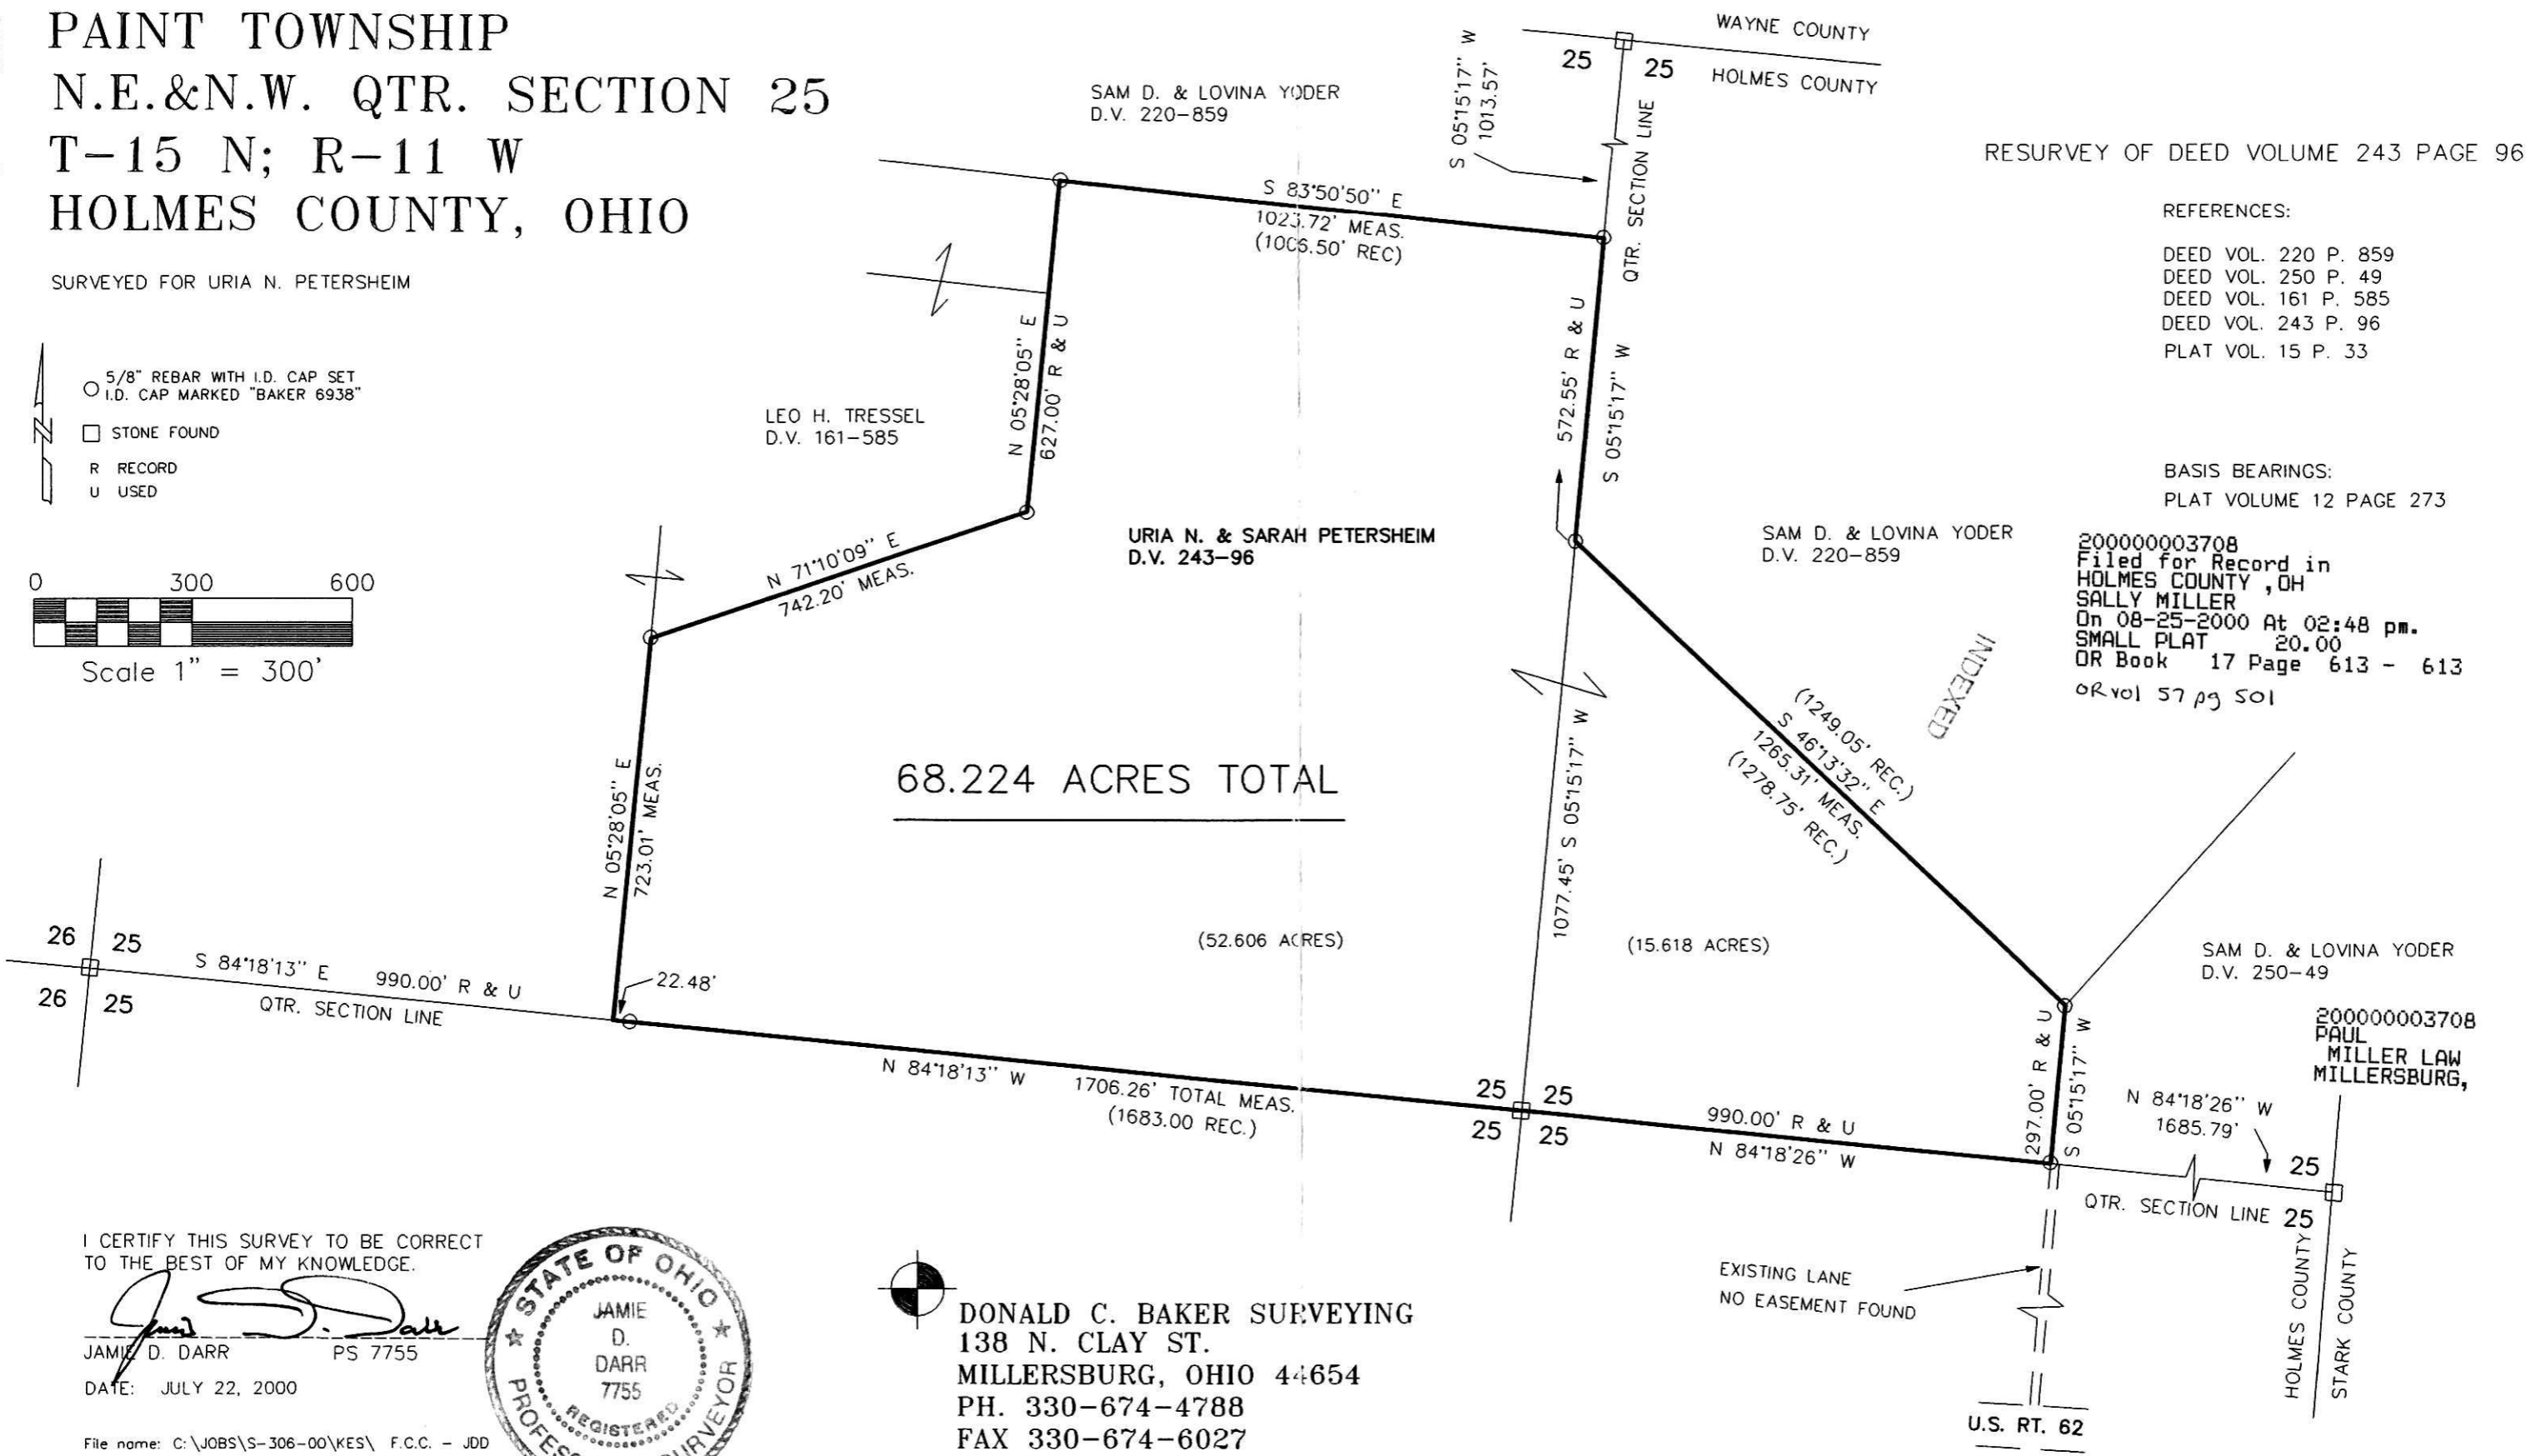

I CERTIFY THIS SURVEY TO BE CORRECT TO THE BEST OF MY KNOWLEDGE.

Jamie D. Darr
 JAMIE D. DARR PS 7755
 DATE: JULY 22, 2000

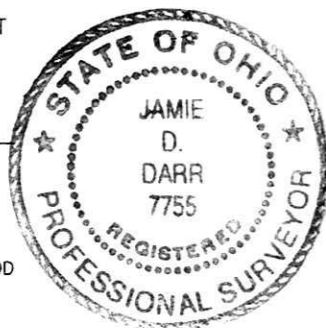

DONALD C. BAKER SURVEYING
 138 N. CLAY ST.
 MILLERSBURG, OHIO 44654
 PH. 330-674-4788
 FAX 330-674-6027

File name: C:\JOBS\S-306-00\KES\F.C.C. - JDD

EXISTING LANE
NO EASEMENT FOUND

U.S. RT. 62

PLAT APPROVED

8/24/2000