VOL 17 PAGE 636

WALNUT CREEK TOWNSHIP
S.E. QTR. SECTION 13
T-9N; R-5W
HOLMES COUNTY, OHIO

(SURVEYED FOR: ERVIN SCHROCK)

0 100 200 400

SCALE: 1" = 200'

- ■ STONE FOUND
- ● IRON P.N FOUND
- △ R.R. SPIKE SET
- ○ 5/8" Re BAR WITH I.D. CAP SET
  I.D. CAP MARKED "BAKER 6938"
  R-REC. M-MEAS.

REFERENCES:

DEED VOL. 277 PAGE 785
" " 276 " 571
" " 169 " 180
" " 270 " 349
" " 263 " 571
" " 245 " 411
" " 252 " 612

PLAT VOL. 14 PAGE 925
" " 12 " 739
" " 8 " 877

STATE OF OHIO
JAMIE D. DARR
7755
REGISTERED PROFESSIONAL SURVEYOR

I CERTIFY THIS SURVEY TO BE CORRECT TO THE BEST OF MY KNOWLEDGE.

JAMIE D. DARR P.S. 7755
DONALD C. BAKER SURVEYING
138 N. CLAY ST.
MILLERSBURG, OHIO 44654
PH (330) 674-4788

AUGUST 22, 2000

#40900 M.L. DAVIS

F.C.C. - J.D. DARR

BEARINGS FROM PLAT VOL. 10 PG. 390

INDEXED

200000004079
Filed for Record in
HOLMES COUNTY, OH
SALLY MILLER
On 09-20-2000 At 02:32 pm.
SMALL PLAT 20.00
OR Book 17 Page 636 - 636
OR vol 58 page 942

200000004079
PAUL A
MILLER ATTY
MILLERSBURG,

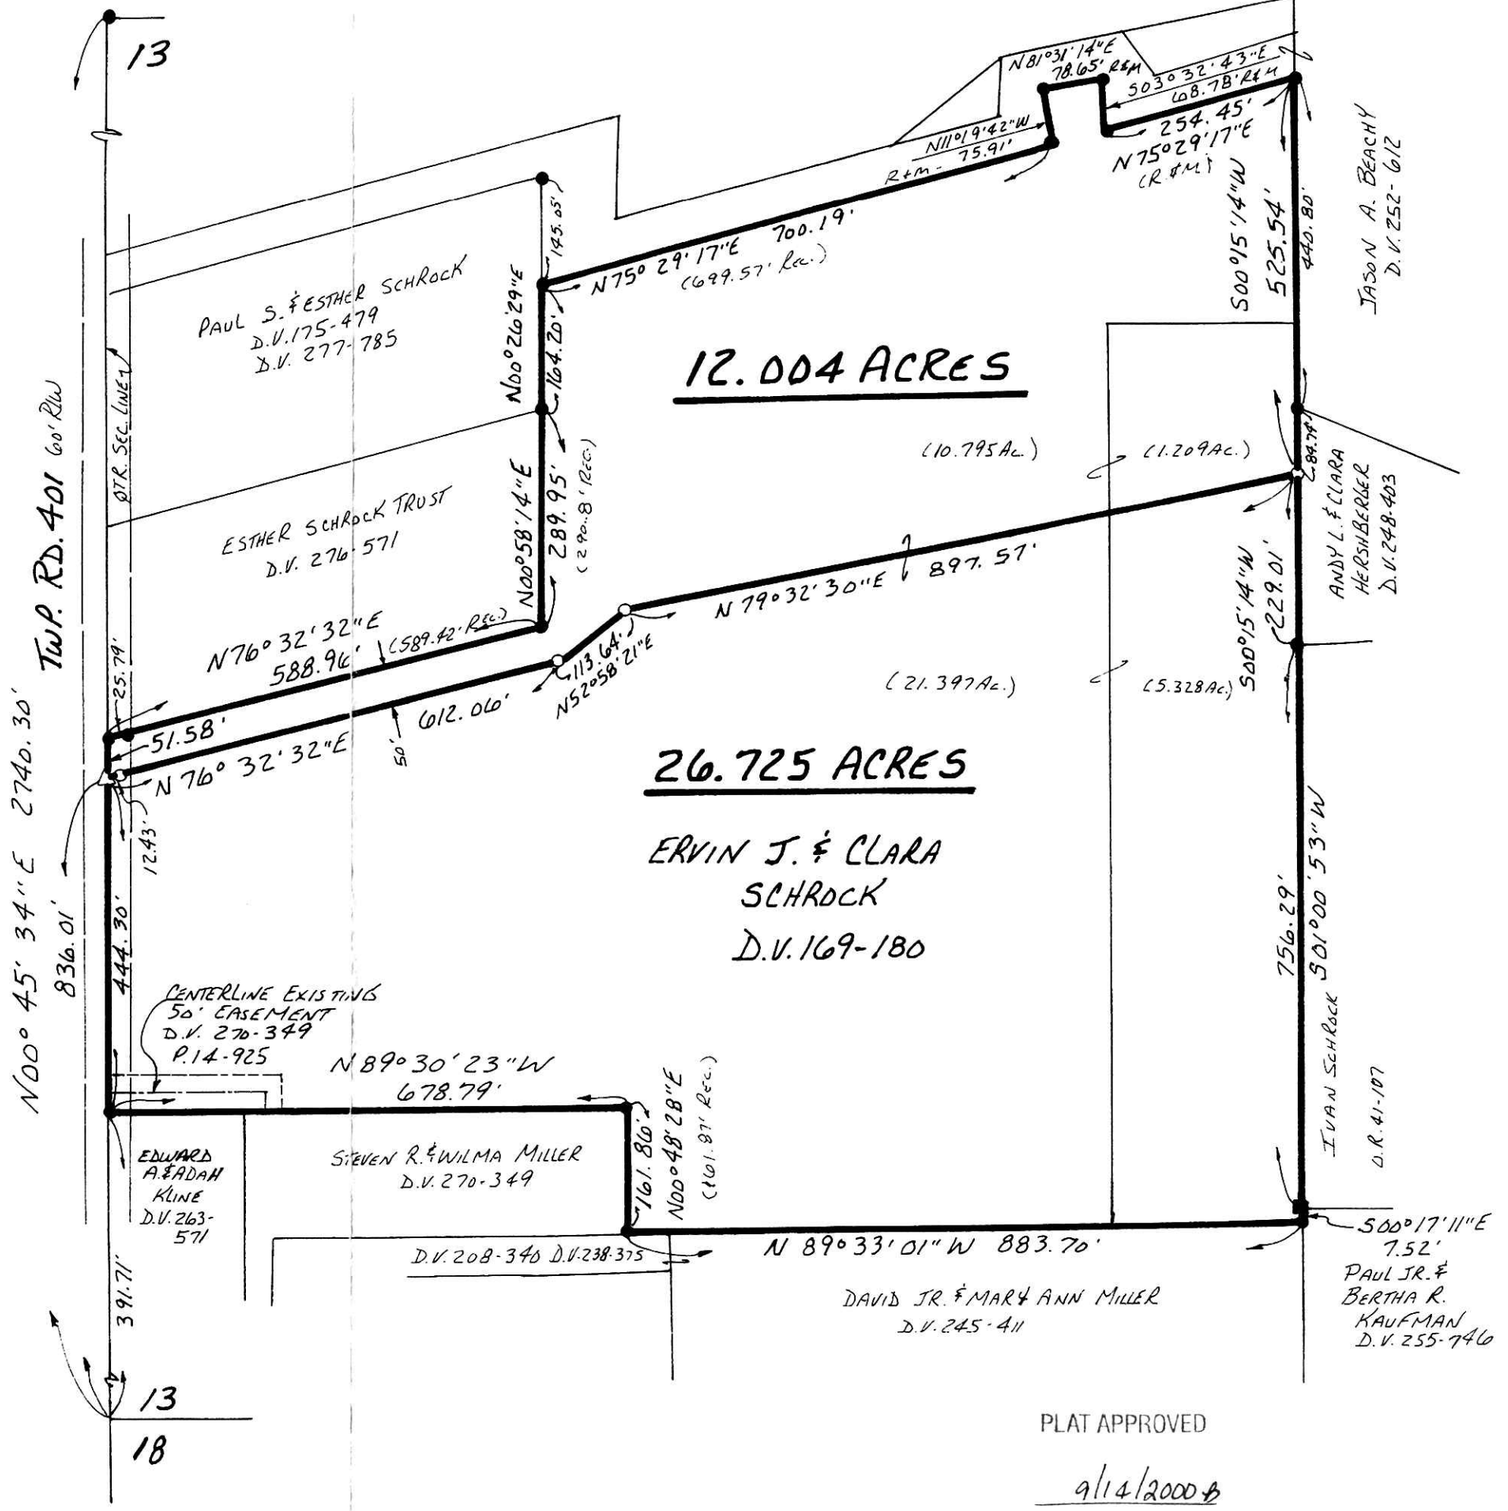

PLAT APPROVED

9/14/2000