


VOL 17 PAGE 673

DONALD C. BAKER SURVEYING  
138 N. CLAY ST.  
MILLERSBURG, OHIO 44654  
PH. 330-674-4788  
FAX 330-674-6027

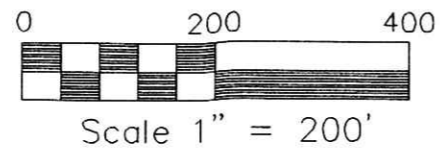

PAINT TOWNSHIP  
3RD QTR., LOT 22  
T-10 N; R-4 W  
HOLMES COUNTY, OHIO

RESURVEY OF DEED VOL. 274 PAGE 972

- IRON PIN FOUND
- 5/8" REBAR WITH I.D. CAP SET  
I.D. CAP MARKED "BAKER 6938"

REFERENCES:

- DEED VOL. 264 P. 737
- DEED VOL. 240 P. 373
- DEED VOL. 252 PAGE 225
- DEED VOL. 274 PAGE 972
- PLAT VOL. 14 P. 671
- PLAT VOL. 7 P. 366

BEARINGS FROM PLAT VOL. 14 PAGE 526

INDEXED

200000004699  
Filed for Record in  
HOLMES COUNTY, OH  
SALLY MILLER  
On 10-26-2000 At 10:37 am.  
SMALL PLAT 20.00  
OR Book 17 Page 673 - 673  
CR vol 61 pg 166

200000004699  
HOLMES CTY  
TITLE  
MILLERSBURG,

DALE L. MATHIAS JR.  
DEED VOL. 240 PAGE 373  
DEED VOL. 252 PAGE 146  
DEED VOL. 264 PAGE 737



I CERTIFY THIS SURVEY TO BE CORRECT  
TO THE BEST OF MY KNOWLEDGE.


*Donald C. Baker*  
DONALD C. BAKER PS 6938

DATE: JUNE 13, 2000

DCB / F.C.C. - FDB/ File name: C:\JOBS\S-362-00

PLAT APPROVED

*9/20/2000-b*

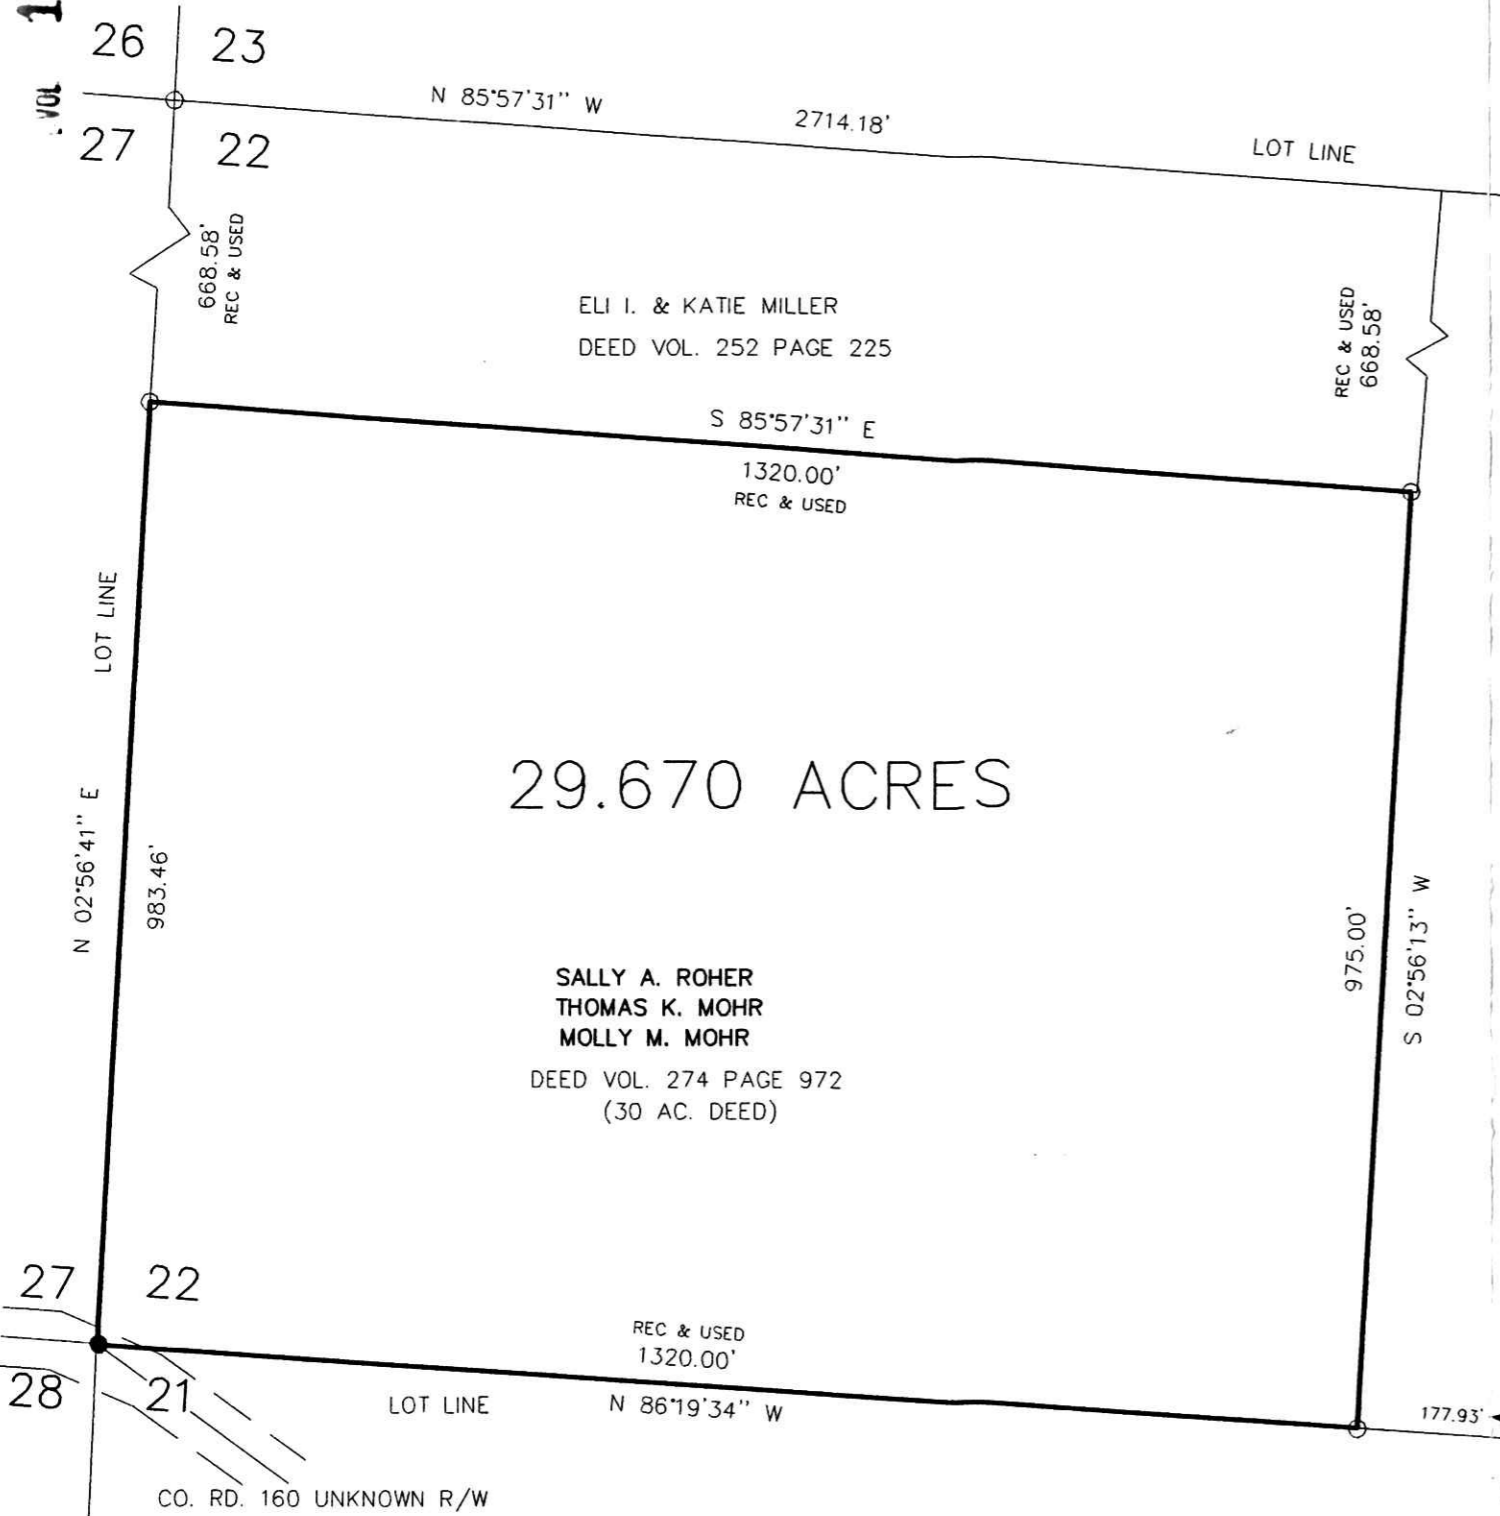

29.670 ACRES

ELI I. & KATIE MILLER  
DEED VOL. 252 PAGE 225

SALLY A. ROHER  
THOMAS K. MOHR  
MOLLY M. MOHR  
DEED VOL. 274 PAGE 972  
(30 AC. DEED)

23 | 10  
22 | 11

177.93'