


MECHANIC TOWNSHIP
 N.W. QTR. SECTION 19
 T-8N; R-7W
 HOLMES COUNTY, OHIO
 (SURVEYED FOR: WANDA BRINKER & LARRY OSWALD)

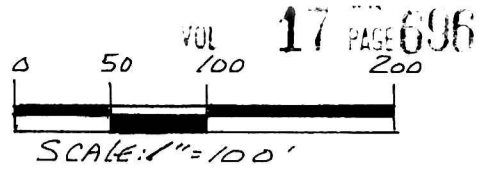


- STONE FOUND
- 5/8" RE BAR WITH I.D. CAP SET
- I.D. CAP MARKED "BAKER 6938"

REFERENCES:

DEED VOL. 220 PAGE 289
 O.R. VOL. 37 PAGE 246

BEARINGS FROM PLAT
 VOL. 9 PAGE 60

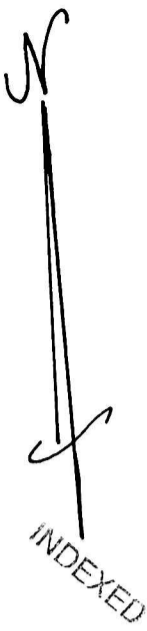


200000005047
 Filed for Record in
 HOLMES COUNTY, OH
 SALLY MILLER
 On 11-14-2000 At 02:09 pm.
 SMALL PLAT 20.00
 OR Book 17 Page 696 - 696
 OR Vol 62 page 426

200000005047
 SAMUEL M
 STEIMEL ATTY
 MILLERSBURG,

000322
 APPROVED FOR TRANSFER ONLY
 AND SUBDIVISION PLAT REQUIRED
 (O.R.C. 711.001 & 711.131)
 Lot(s) not for building unless
 approved by Board of Health,
 HOLMES CO. PLANNING COMM.

By AD Date 11/9/00

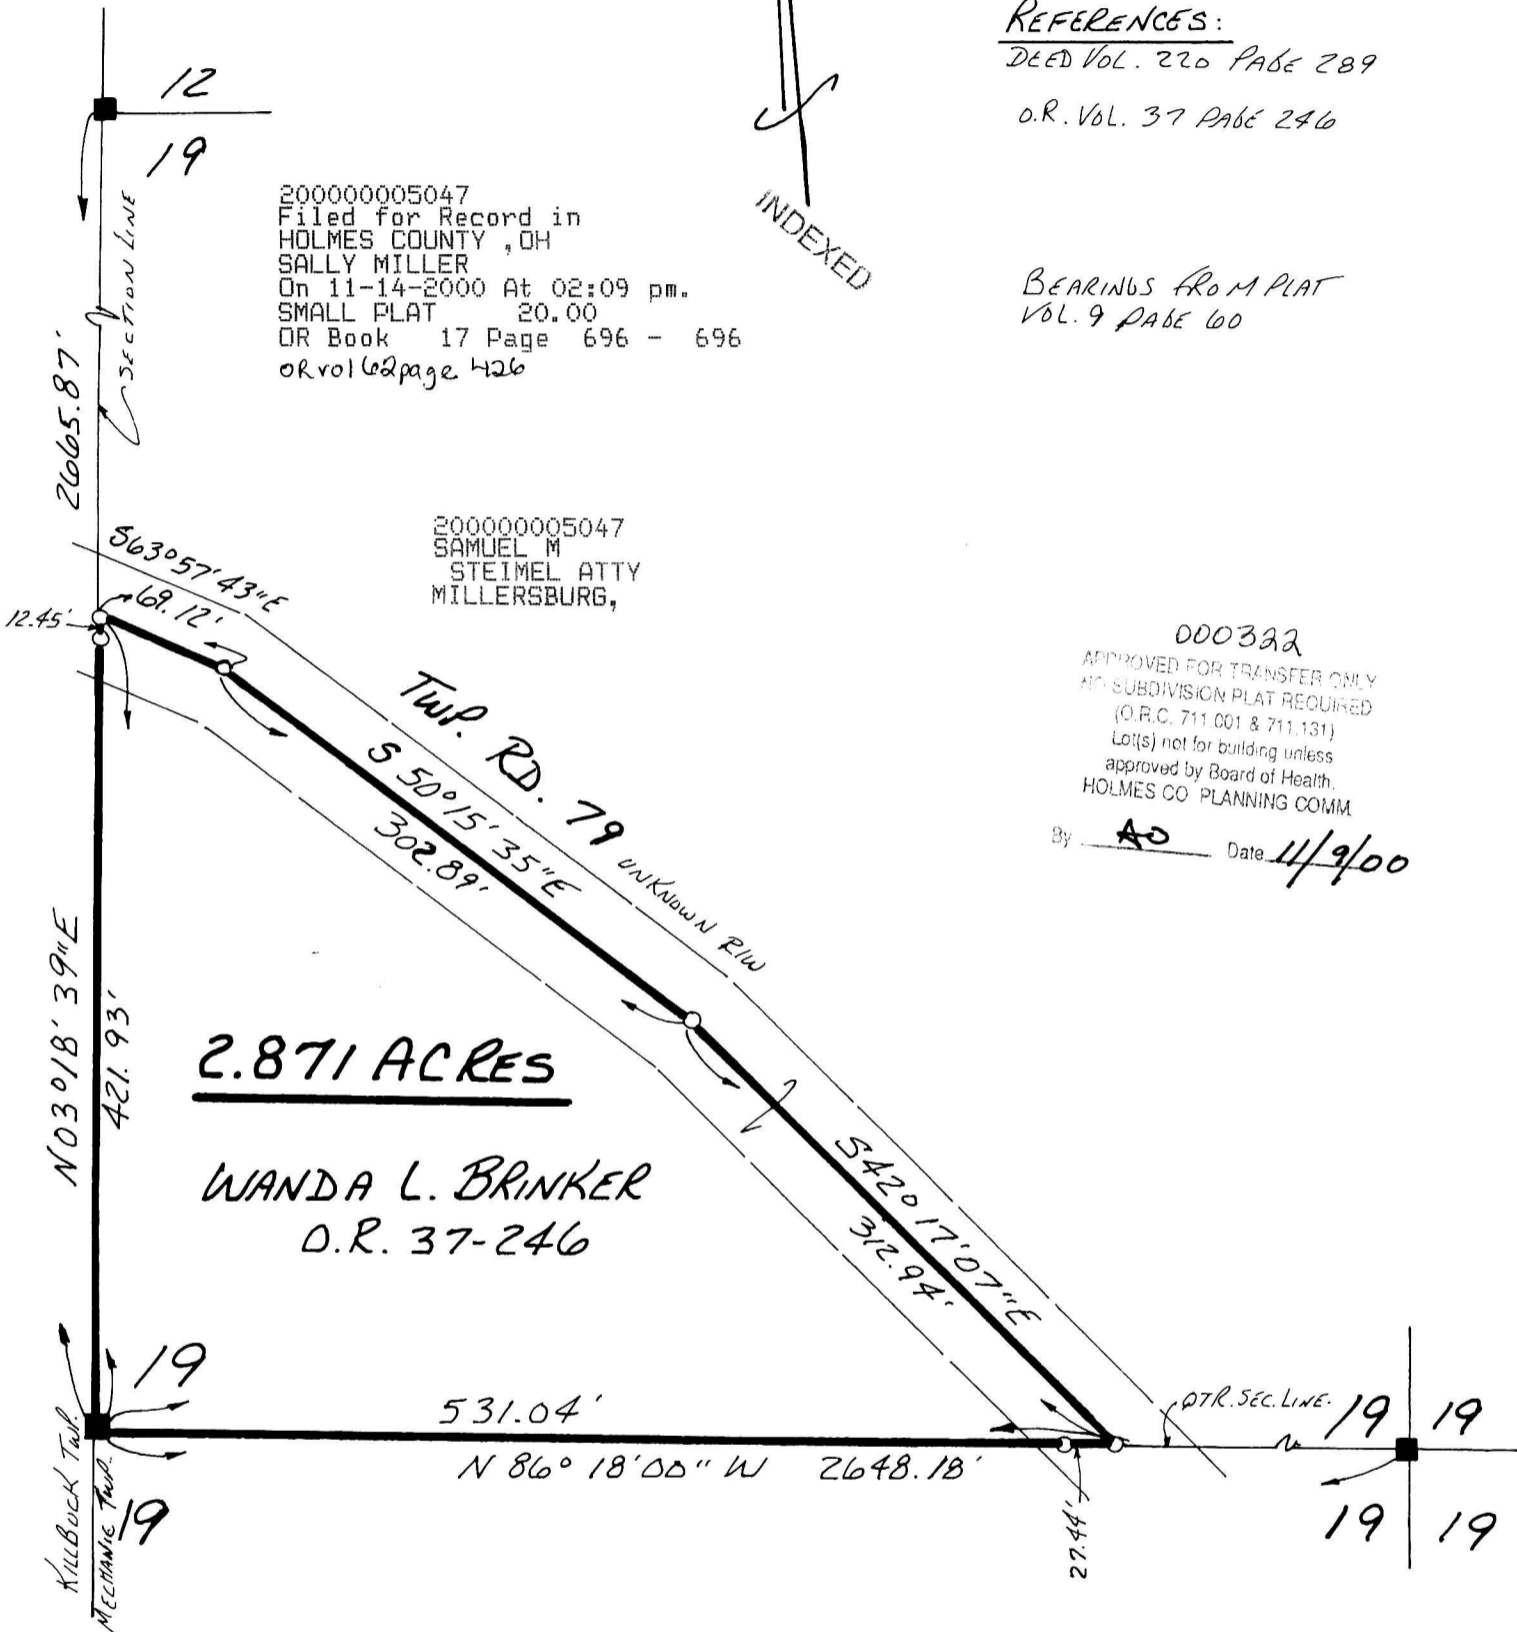

I CERTIFY THIS SURVEY TO BE CORRECT
 TO THE BEST OF MY KNOWLEDGE.

Donald C. Baker

DONALD C. BAKER P.S. 6938

DONALD C. BAKER SURVEYOR

138 N. CLAY ST.

MILLERSBURG, OHIO 44654

PH. (330) 674-4788

AUGUST 9, 2000

(#37600) #8900 - M.L. DAVIS
 F.C.C. - F.D. BAKER



PLAT APPROVED

11/13/00 *AD*