


WALNUT CREEK TOWNSHIP  
 S.E. & S.W. QTRS. SECTION 21  
 T-9N; R-5W  
 HOLMES COUNTY, OHIO  
 (SURVEYED FOR: HOLMES LIMESTONE CO.)

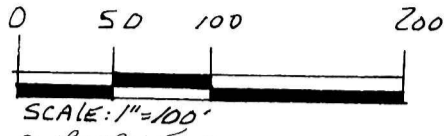

- SCALE: 1"=100'
- IRON PIN FOUND
  - 5/8" RE BAR WITH I.D. CAP SET  
I.D. CAP MARKED "BAKER 6938"

REFERENCES:  
 DEED VOL. 227 PAGE 567  
 " " 186 " 801


O.R. VOL. 24 PAGE 258  
 BEARINGS FROM PLAT VOL. 11 PAGE 33

200100006228  
 Filed for Record in  
 HOLMES COUNTY, OH  
 SALLY MILLER  
 01-25-2001 03:12 pm.  
 SMALL PLAT 20.00  
 OR Book 17 Page 772 - 772  
 OR vol 66 page 480

INDEXED

200100006228  
 CRITCHFIELD...  
 & JOHNSTON ATTYS  
 MILLERSBURG,


010019  
 APPROVED FOR TRANSFER ONLY  
 NO SUBDIVISION PLAT REQUIRED  
 (O.R.C. 711.004 & 711.131)  
 Lot(s) not for building unless  
 approved by Board of Health.  
 HOLMES CO. PLANNING COMM.  
 By AS Date 1/22/01

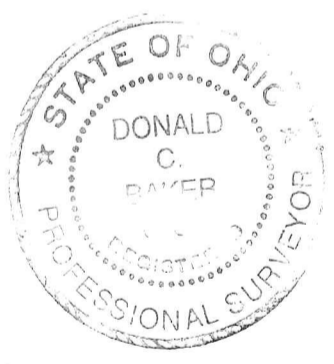

I CERTIFY THIS SURVEY TO BE CORRECT  
 TO THE BEST OF MY KNOWLEDGE.

Donald C. Baker  
 DONALD C. BAKER P. S. 6938  
 DONALD C. BAKER SURVEYING  
 138 N. CLAY ST.  
 MILLERSBURG, OHIO 44654  
 PH. 330-674-4788  
 DECEMBER 15, 2000

#80900 - M.L. DAVIS  
 F.C.C. - F.D. BAKER

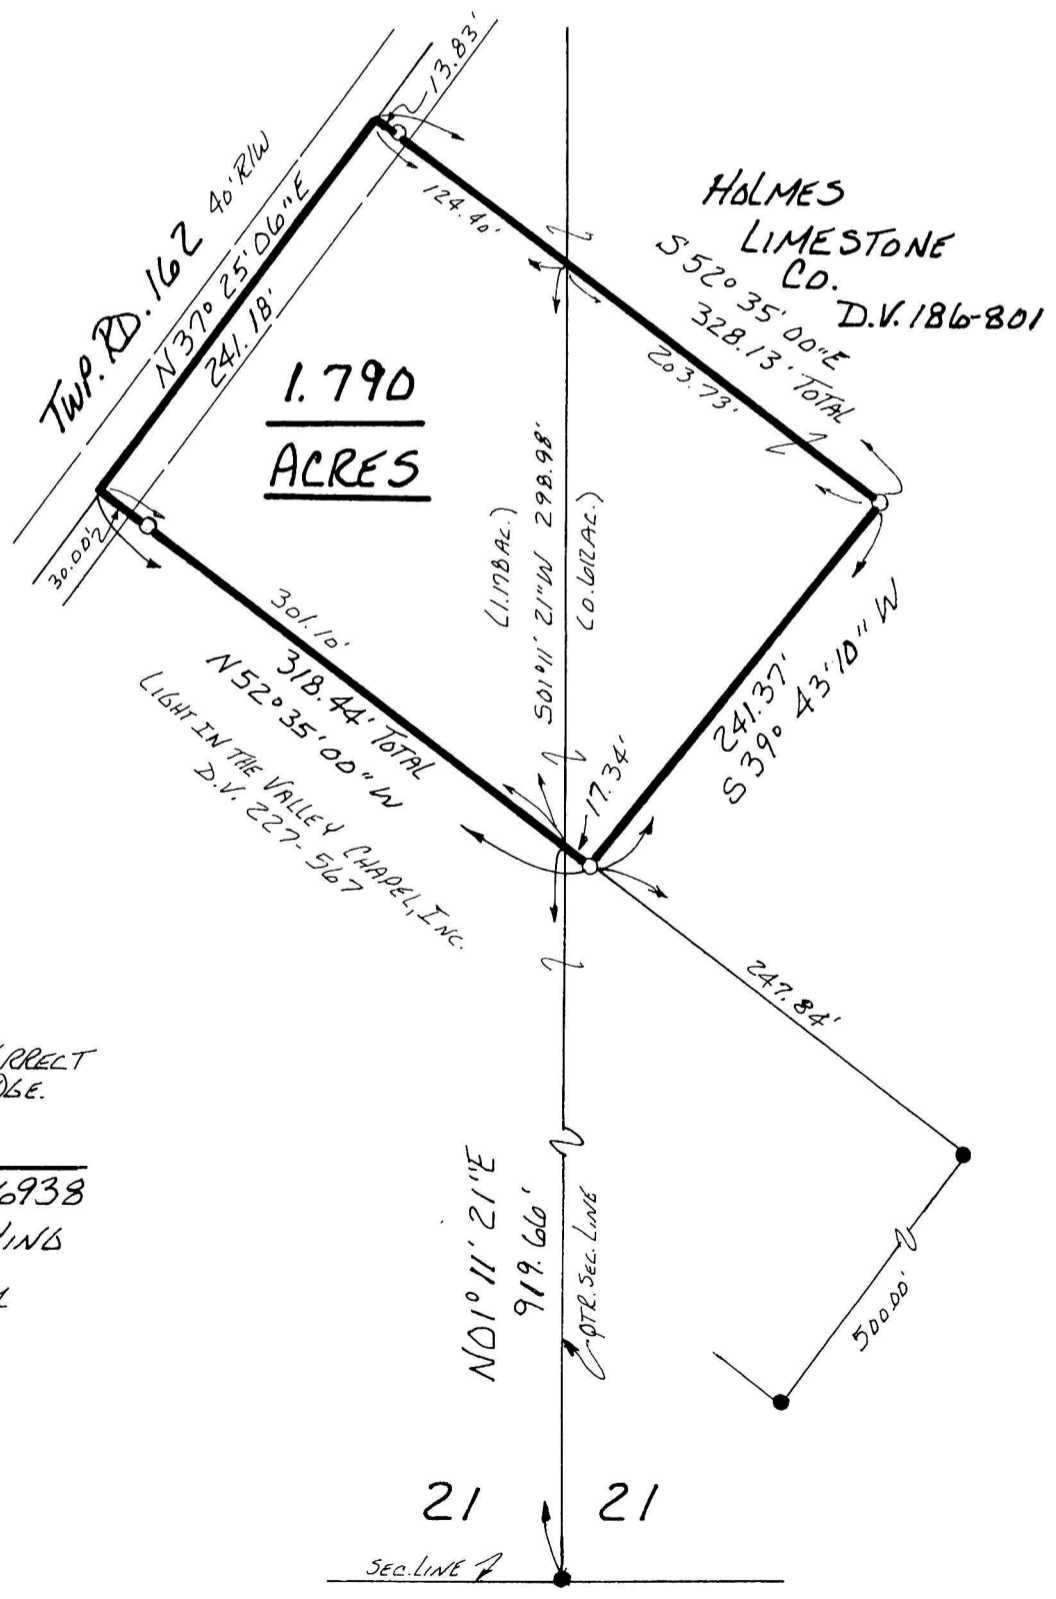

PLAT APPROVED

1/23/2001