

- IRON PIN FOUND
- 5/8" REBAR WITH I.D. CAP SET
- I.D. CAP MARKED "BAKER1A3B"

WASHINGTON TOWNSHIP
 S.W. QTR. SECTION 26
 S.E. QTR. SECTION 27
 T. 20 N; R. 15 W
 HOLMES COUNTY, OHIO
 (SURVEYED FOR: GREG HENLEY)

REFERENCES:
 Deed Vol. 274 Page 950
 " " 210 " 647
 " " 205 " 125
 BEARINGS FROM PLAT VOL. 12 PAGE 250
 RESURVEY OF DEED VOL. 274 PAGE 950




I CERTIFY THIS SURVEY TO BE CORRECT TO THE BEST OF MY KNOWLEDGE.

Donald C. Baker
 DONALD C. BAKER P.S. 6938
 DONALD C. BAKER SURVEYING
 138 N. CLAY ST.
 MILLERSBURG, OHIO 44654
 PH 330-674-4788

JANUARY 12, 2001

(Comp.)
 #78500 - M.L. DAVIS (78600-Inv.)
 F.C.C. - F.D. BAKER

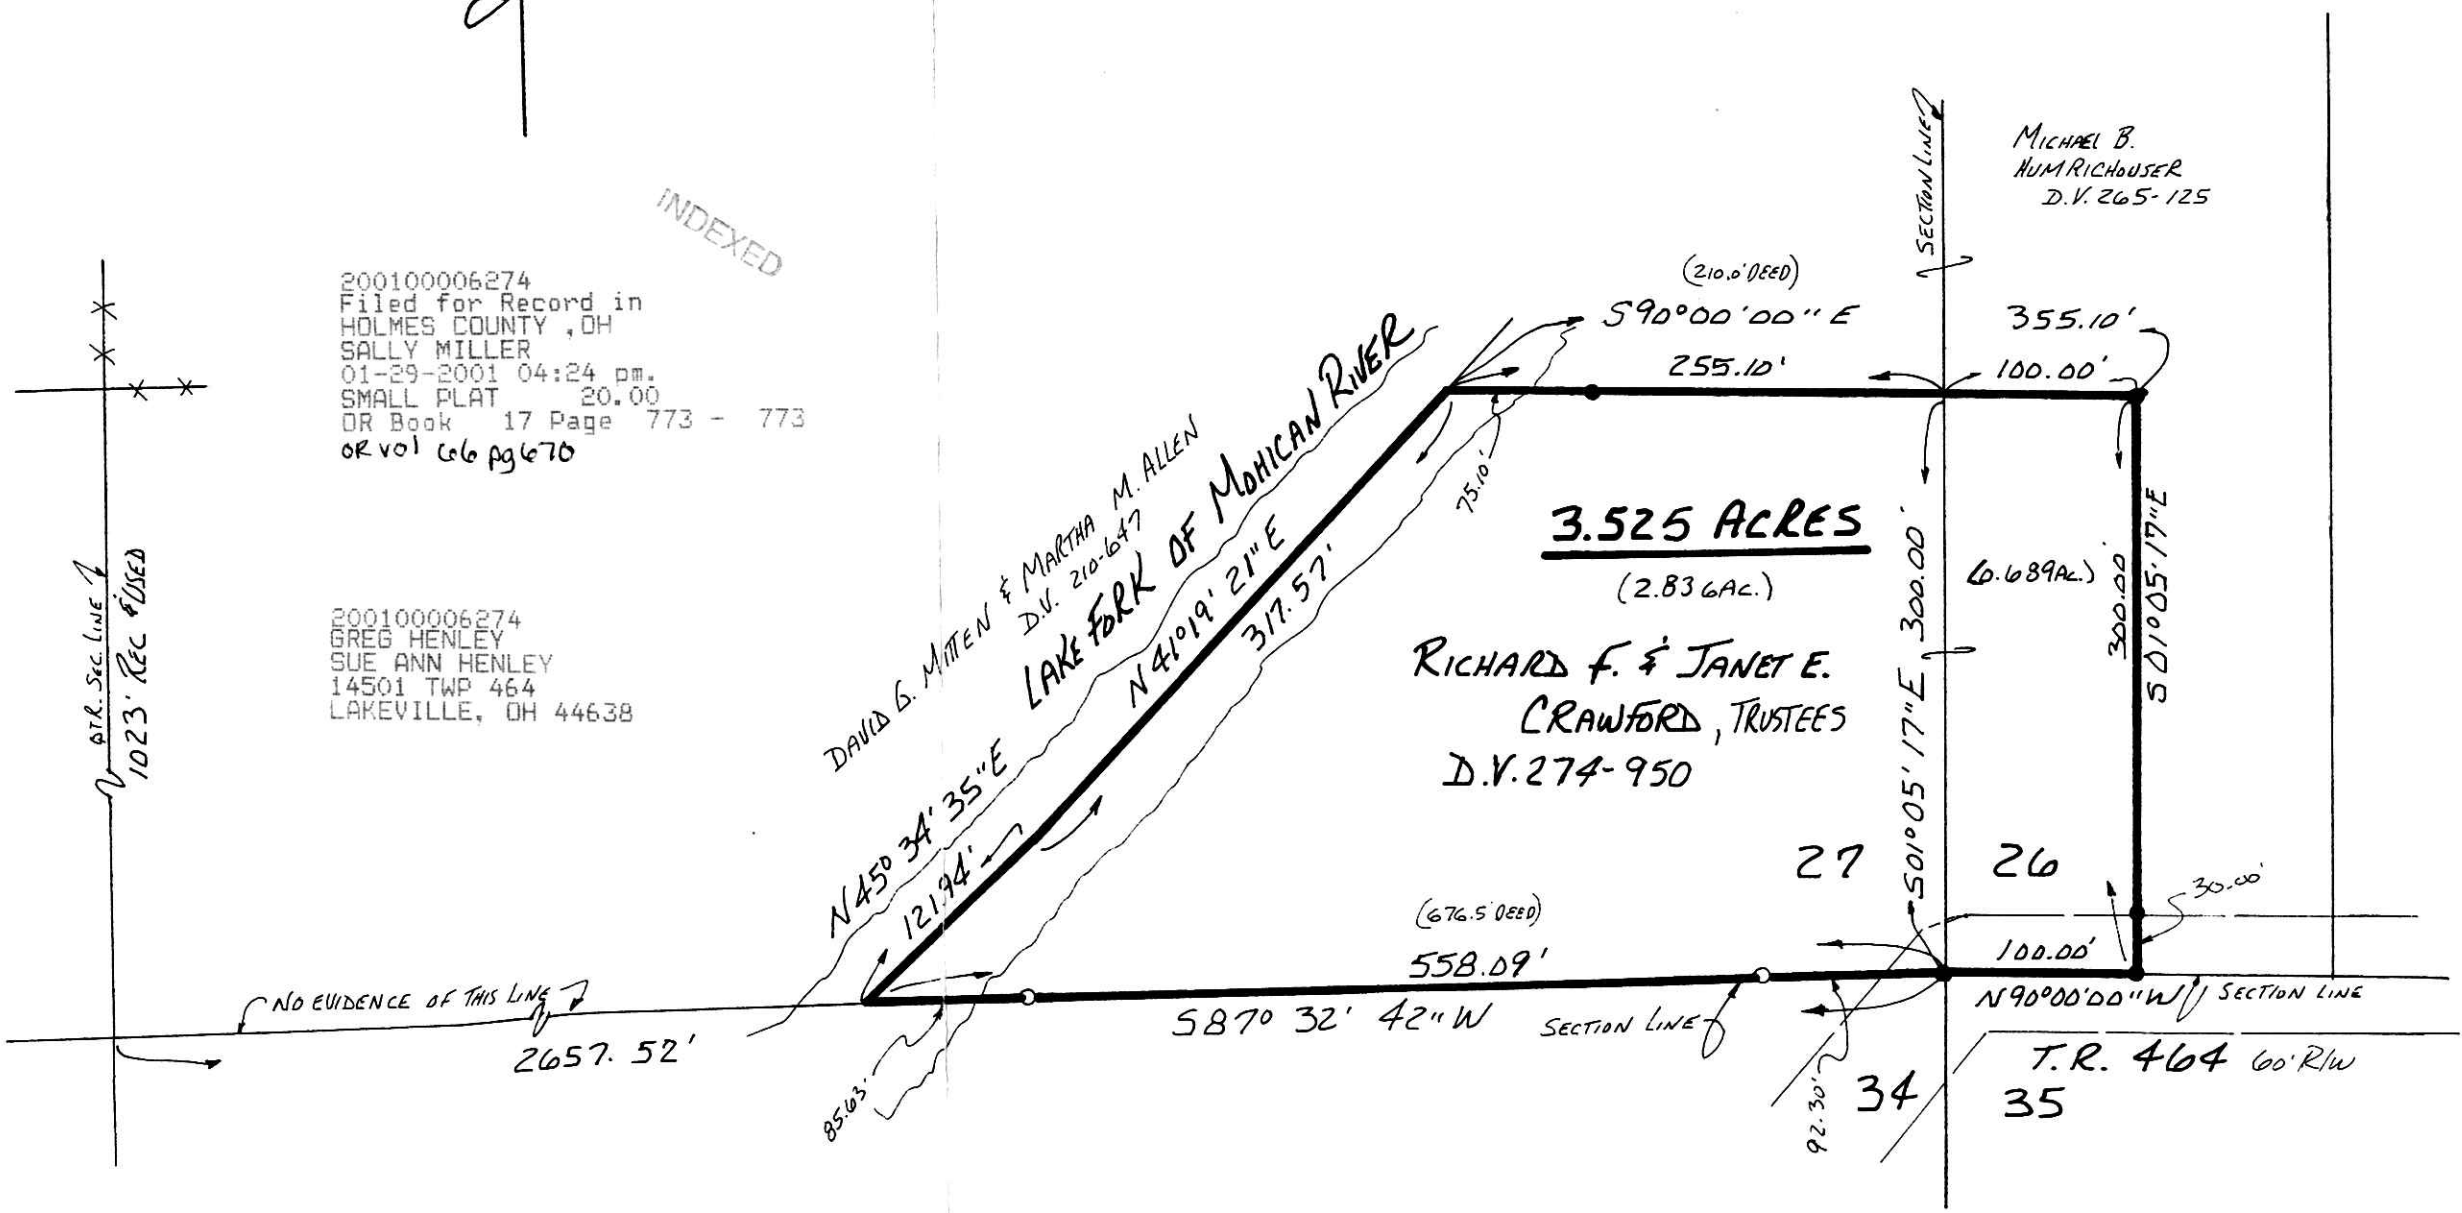

INDEXED
 200100006274
 Filed for Record in
 HOLMES COUNTY, OH
 SALLY MILLER
 01-29-2001 04:24 pm.
 SMALL PLAT 20.00
 DR Book 17 Page 773 - 773
 OR VOL 66 pg 676

200100006274
 GREG HENLEY
 SUE ANN HENLEY
 14501 TWP 464
 LAKEVILLE, OH 44638

MICHAEL B.
 HUMRICHHAUSER
 D.V. 265-125

PLAT APPROVED

1/29/2001 B