

REFERENCES:

DEED VOL. 257 PAGE 437
" " 176 " 525
" " 205 " 309

O.R. VOL. 63 PAGE 595

BEARINGS FROM PLAT VOL. 8 PAGE 490

RIPLEY TOWNSHIP
S. W. QTR. SECTION 6
T-17N; R-14W
HOLMES COUNTY, OHIO
(SURVEYED FOR: JAMES MANSON)

010100

APPROVED FOR TRANSFER ONLY
NO SUBDIVISION PLAT REQUIRED
(O.R.C. 711.001 & 711.131)
Lot(s) not for building unless
approved by Board of Health.
HOLMES CO. PLANNING COMM.


By AD Date 5/3/01

200100008018
Filed for Record in
HOLMES COUNTY, OH
SALLY MILLER
05-08-2001 02:17 pm.
SMALL PLAT 20.00
OR Book 17 Page 867 - 867
OR vol 74 pg 539

INDEXED



SCALE: 1" = 100'
● 1/8" IRON PIN FOUND
○ 5/8" RE BAR WITH I.D. CAP SET
I.D. CAP MARKED "BAKER 6938"

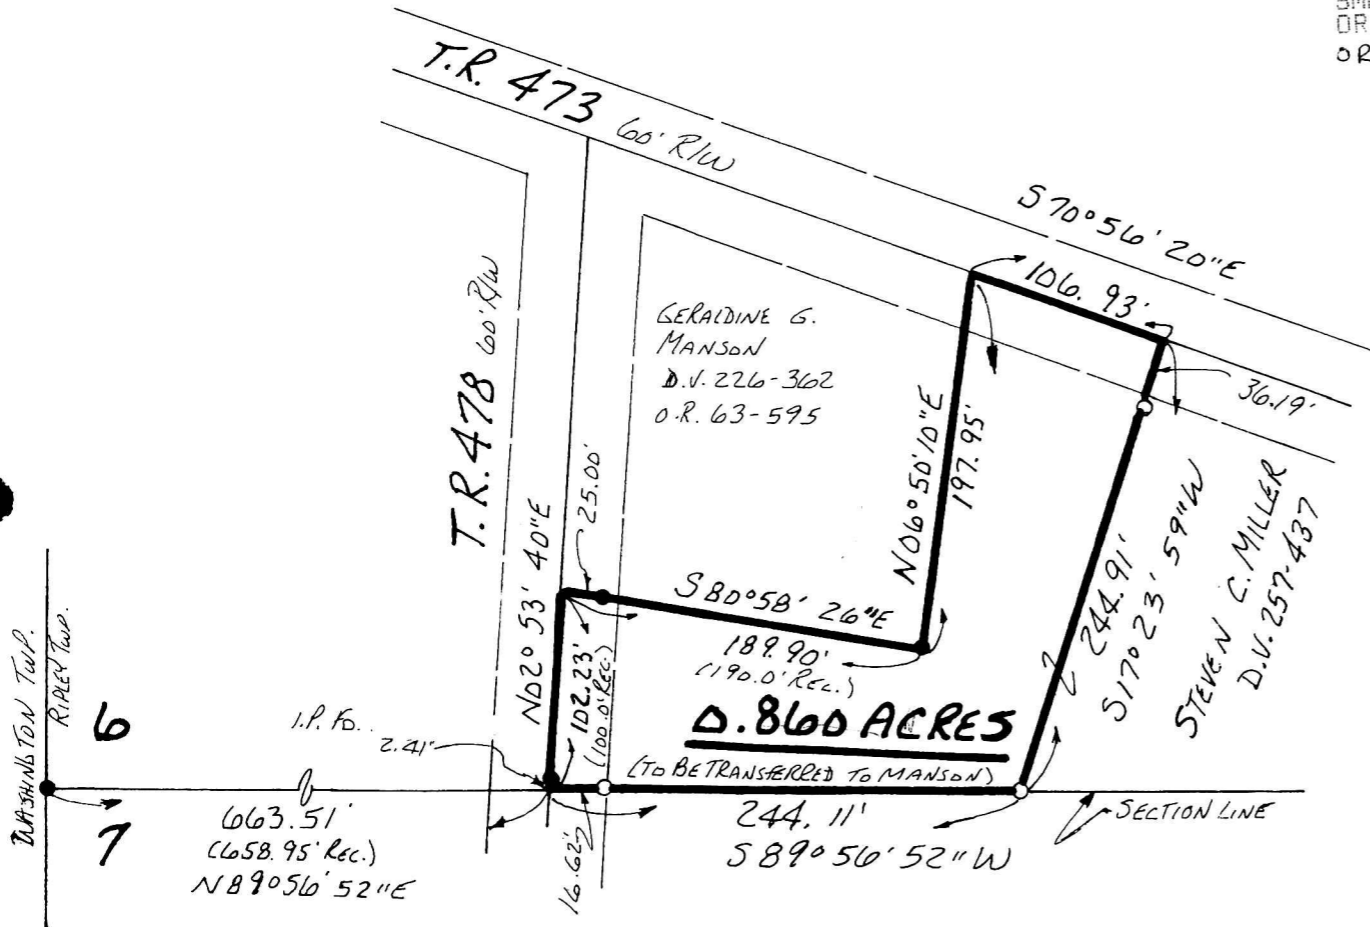

200100008018
LAUREL J
SCHMID ATTY
MILLERSBURG,

I CERTIFY THIS SURVEY TO BE CORRECT
TO THE BEST OF MY KNOWLEDGE.

Jamie D. Darr
JAMIE D. DARR P.S. 7755
DONALD C. BAKER SURVEYING
138 N. CLAY ST.
MILLERSBURG, OHIO 44654
PH. 330-674-4788

8801-M.L.DARR
FEBRUARY 23, 2001

PLAT APPROVED

5/4/01

F.C.C. J. DARR