

8-7-6

VILLAGE OF KILLBUCK LOT 133 HOLMES COUNTY, OHIO (SURVEYED FOR: BARB MARSH)

200100009567
Filed for Record in
HOLMES COUNTY, OH
SALLY MILLER
07-24-2001 12:45 pm.
SMALL PLAT 20.00
OR Book 18 Page 26 - 26
OR vol 82 pg 430

200100009567
PREFERRED TITLE
6231 FRANK AVE NW
NORTH CANTON, OH 44720

INDEXED

0 20 40 80




SCALE: 1" = 40'

- IRON PIN FOUND
- 5/8" REBAR WITH I.D. CAP SET
I.D. CAP MARKED "BAKER 6938"

REFERENCES:

DEED VOL. 200 PAGE 913
" " 232 " 658
" " 260 " 44-46

BEARINGS FROM PLAT VOL. 14 PAGE 175

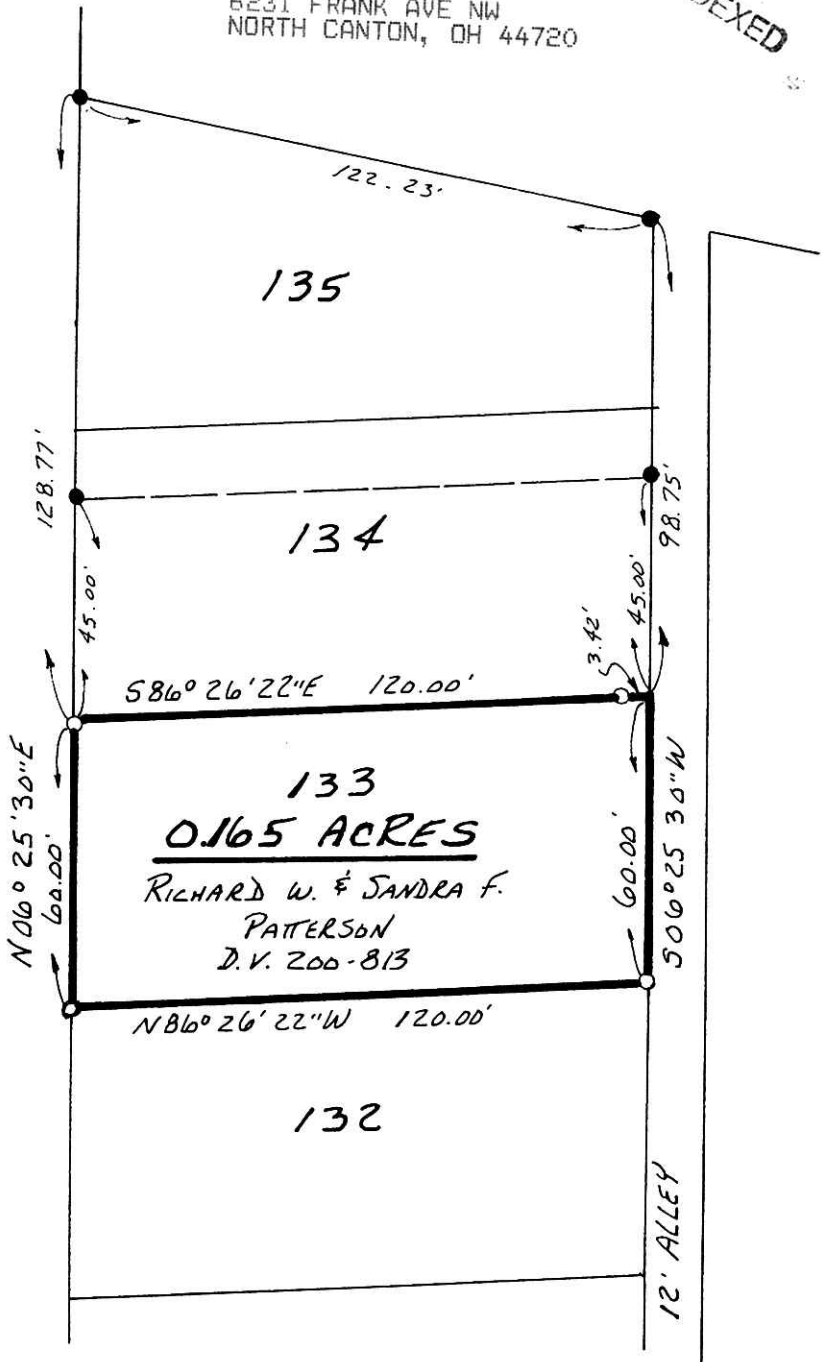

I CERTIFY THIS SURVEY TO BE CORRECT
TO THE BEST OF MY KNOWLEDGE.

Donald C. Baker

DONALD C. BAKER P.S. 6938

DONALD C. BAKER SURVEYING

138 N. CLAY STREET

MILLERSBURG, OHIO 44654

PH. 330-674-4788

MAY 25, 2001

#41101 - M.L. DAVIS

F.C.C. - F.D. BAKER

PLAT APPROVED

7/2/2001