


PAINT TOWNSHIP  
 4TH. QTR., LOT 4  
 T-10 N; R-5 W  
 HOLMES COUNTY, OHIO

RESURVEY OF DEED VOL. 153 PAGE 12

VOL 0 18 PAGE 100 28 200

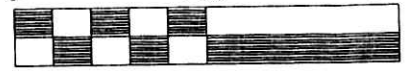


Scale 1" = 100'

REFERENCES:

- DEED VOL. 153 PAGE 12
- DEED VOL. 182 PAGE 464
- PLAT VOL. 3 PAGE 90
- BEARINGS FROM PLAT VOL. 3 PAGE 90

- IRON PIN FOUND
- 5/8" REBAR WITH I.D. CAP SET  
I.D. CAP MARKED "BAKER 6938"
- STONE FOUND

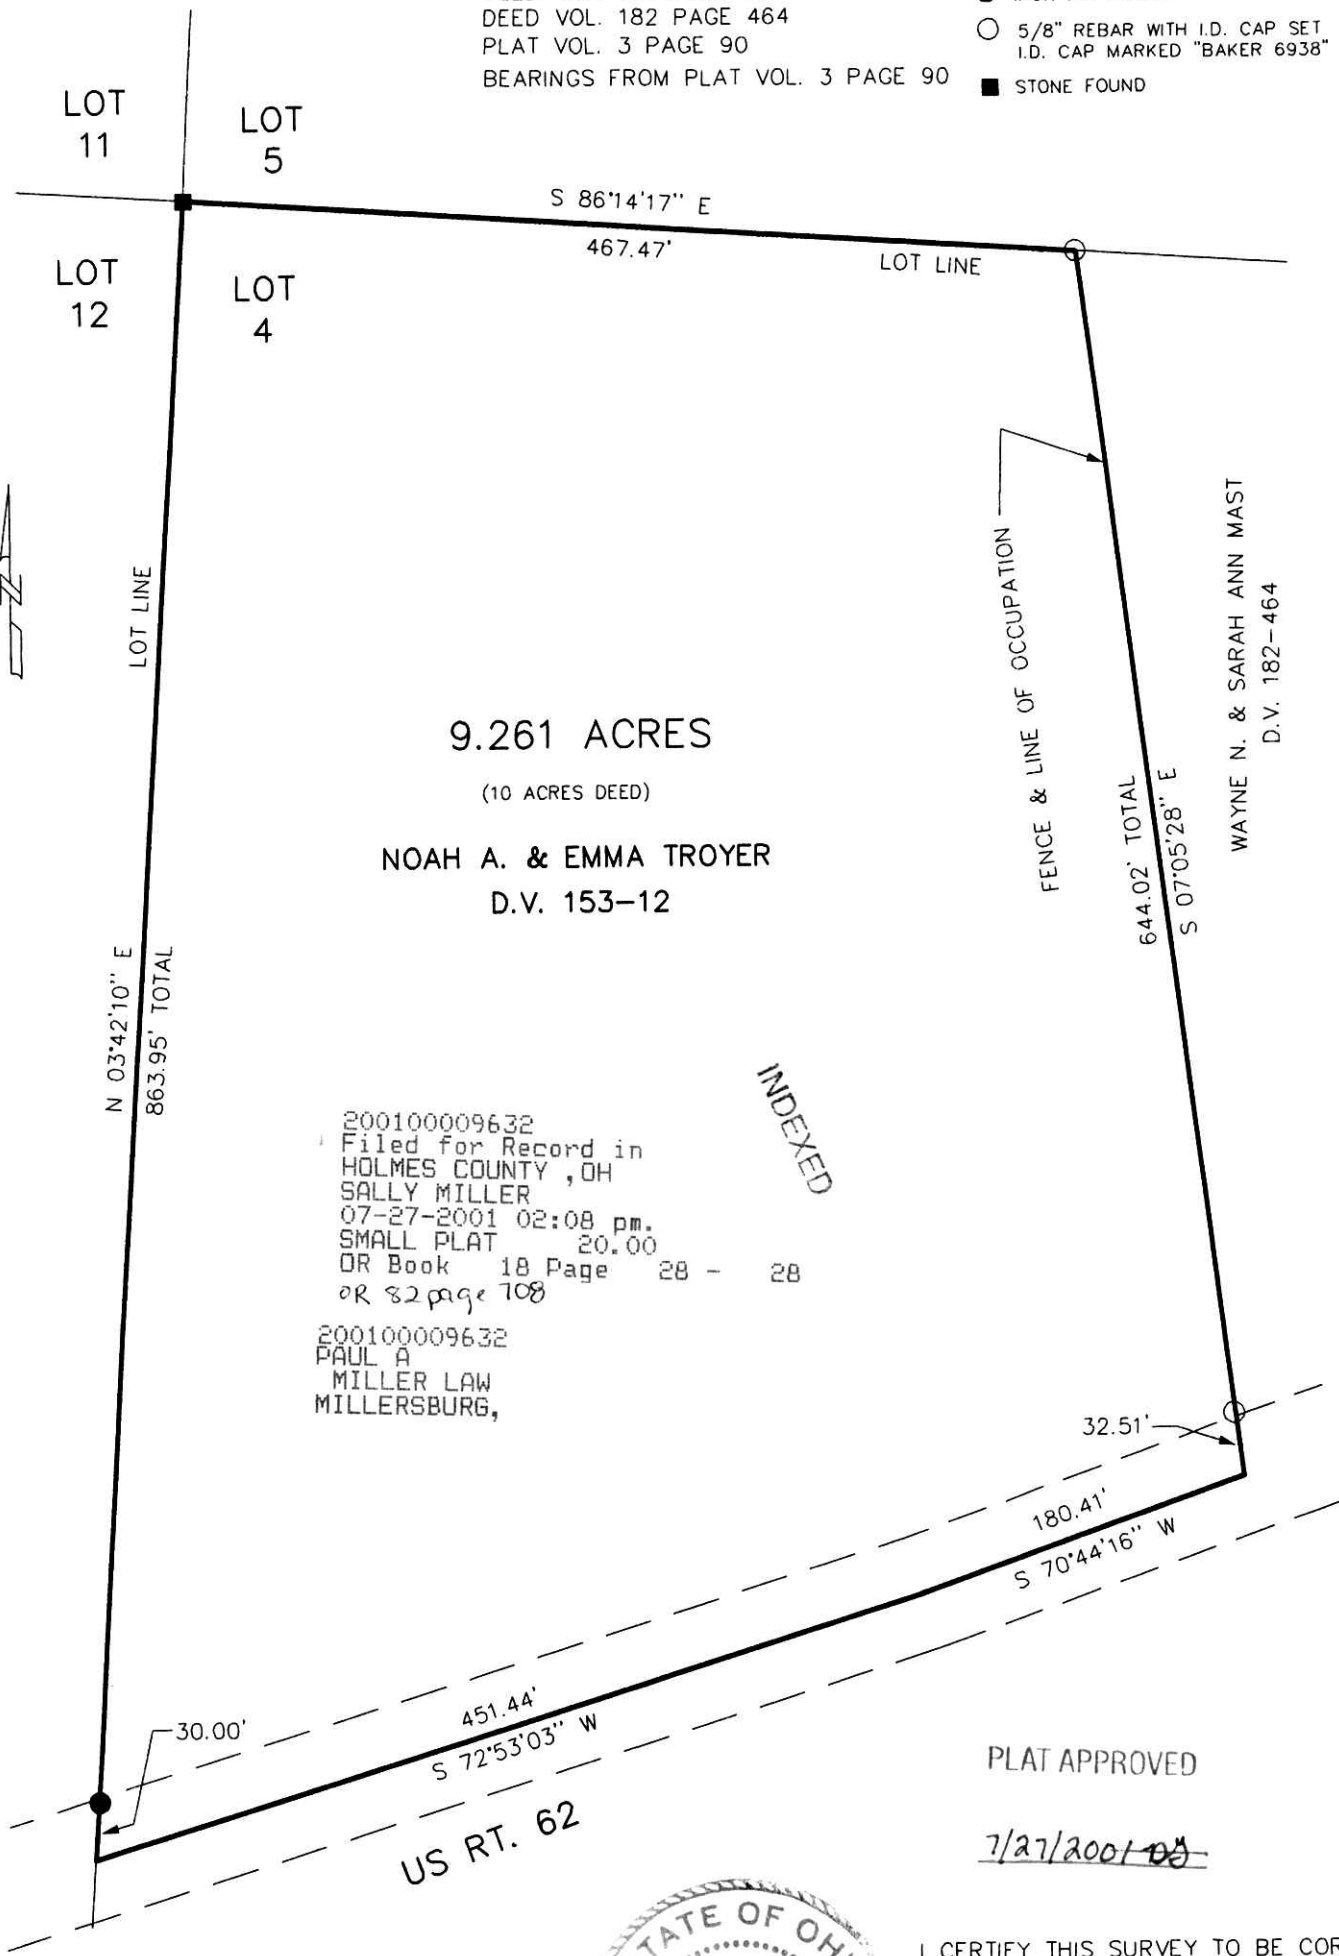

PLAT APPROVED

7/27/2001

I CERTIFY THIS SURVEY TO BE CORRECT TO THE BEST OF MY KNOWLEDGE.

*Donald C. Baker*  
 DONALD C. BAKER PS 6938

JUNE 29, 2001

File name: C:\JOBS\S-455-01  
 F.C.C. - FDB



DONALD C. BAKER SURVEYING  
 138 N. CLAY ST.  
 MILLERSBURG, OHIO 44654  
 PH. 330-674-4788  
 FAX 330-674-6027

