

RETRACEMENT OF DEED 232 PAGE 809



MONROE TOWNSHIP
 3RD. QTR., LOT 5
 T-9 N; R-8 W
 HOLMES COUNTY, OHIO

REFERENCES:

- DEED VOL. 160 PAGE 127
- DEED VOL. 232 PAGE 809
- DEED VOL. 241 PAGE 876
- DEED VOL. 247 PAGE 771
- PLAT VOL. 4 PAGE 115
- PLAT VOL. 9 PAGE 37
- PLAT VOL. 17 PAGE 562
- PLAT VOL. 12 PAGE 470
- BEARINGS FROM PLAT VOL. 17 PAGE 562

200100010839
 Filed for Record in
 HOLMES COUNTY, OH
 SALLY MILLER
 09-27-2001 02:48 pm.
 SMALL PLAT 20.00
 OR Book 18 Page 90 - 90
 off ReVol 88 818

200100010839
 JOHN
 BARRINGTON ATTY
 WOOSTER, OH

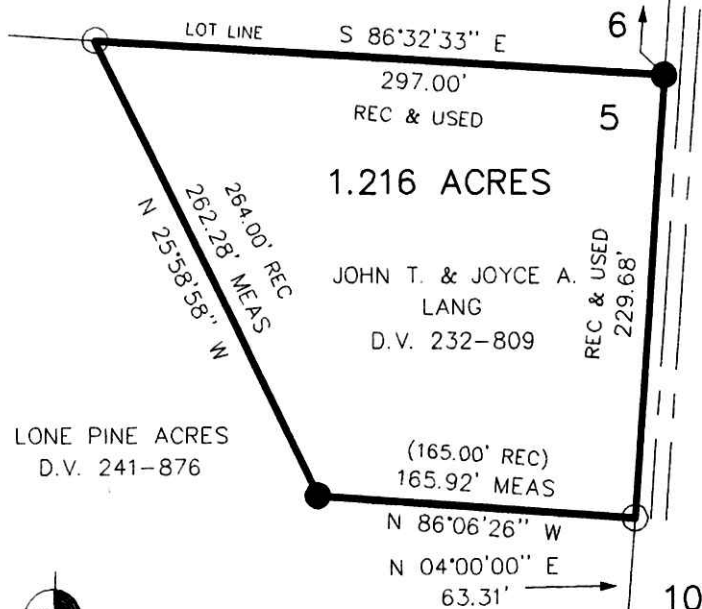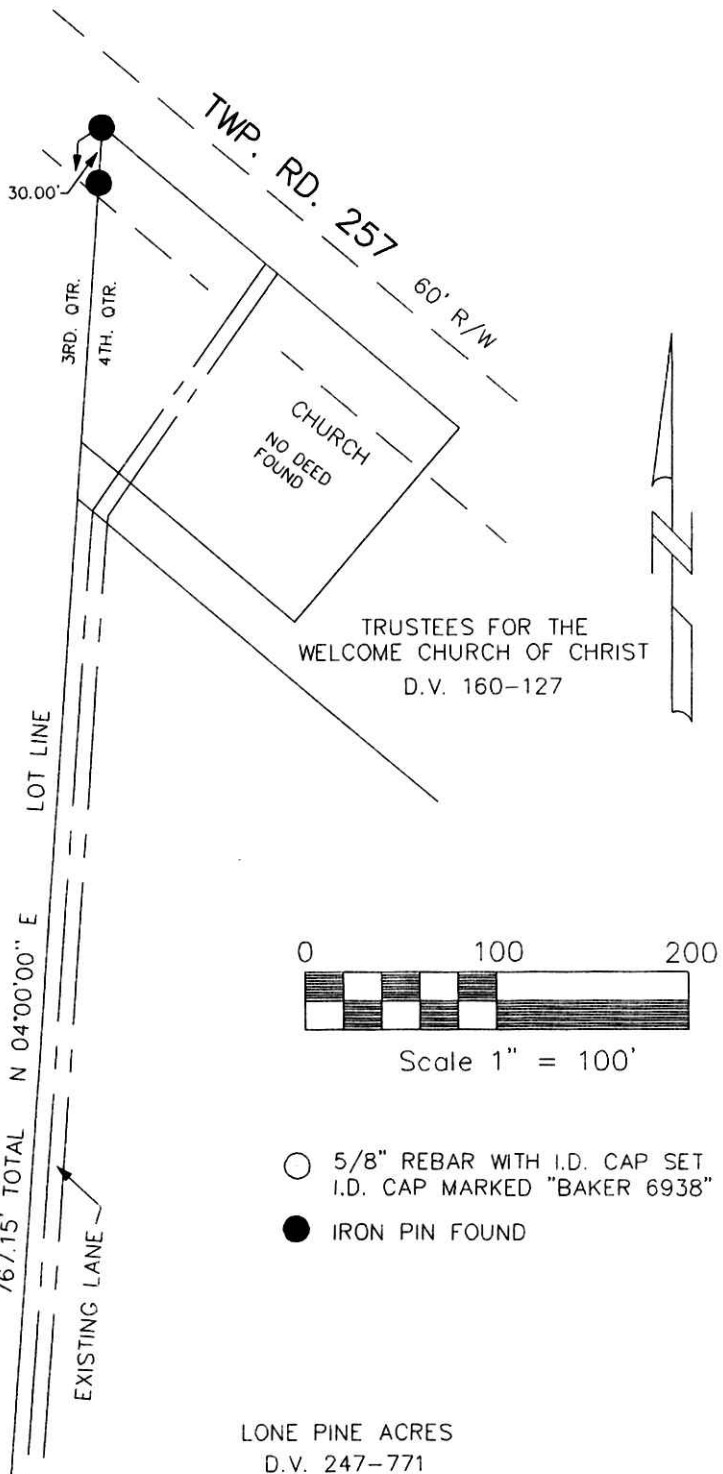

I CERTIFY THIS SURVEY TO BE CORRECT TO THE BEST OF MY KNOWLEDGE.

Donald C. Baker
 DONALD C. BAKER P.S. 6938

SEPT. 6, 2001 REVISED SEPT. 19, 2001
 C:\JOBS1\S-710-01\ERZ F.C.C. - FDB

DONALD C. BAKER SURVEYING
 138 N. CLAY ST.
 MILLERSBURG, OHIO 44654
 PH. 330-674-4788
 FAX 330-674-6027

15 PLAT APPROVED

9/25/01