

MONROE TOWNSHIP  
 2ND. QTR., LOTS 14, 15 & 16  
 T- 9 N R- 8 W  
 HOLMES COUNTY, OHIO

REFERENCES:  
 DEED VOL. 239 PAGE 354  
 DEED VOL. 273 PAGE 587  
 O.R. VOL. 9 PAGE 696  
 O.R. VOL. 9 PAGE 699  
 O.R. VOL. 33 PAGE 593  
 O.R. VOL. 62 PAGE 18

VOL 18 PAGE 242


BEARINGS FROM O.R. VOL. 33 PAGE 593

SURVEYED FOR ADAM CAMPBELL

- STONE FOUND
- ▲ R.R. SPIKE FOUND
- P.K. NAIL FOUND
- 5/8" REBAR FOUND
- 5/8" REBAR WITH I.D. CAP SET  
I.D. CAP MARKED "BAKER 6938"

200200014752  
 Filed for Record in  
 HOLMES COUNTY, OH  
 SALLY MILLER  
 03-27-2002 03:36 pm.  
 SMALL PLAT 20.00  
 OR Book 18 Page 242 - 242  
 OR vol 108 pg 292, 295

INDEXED

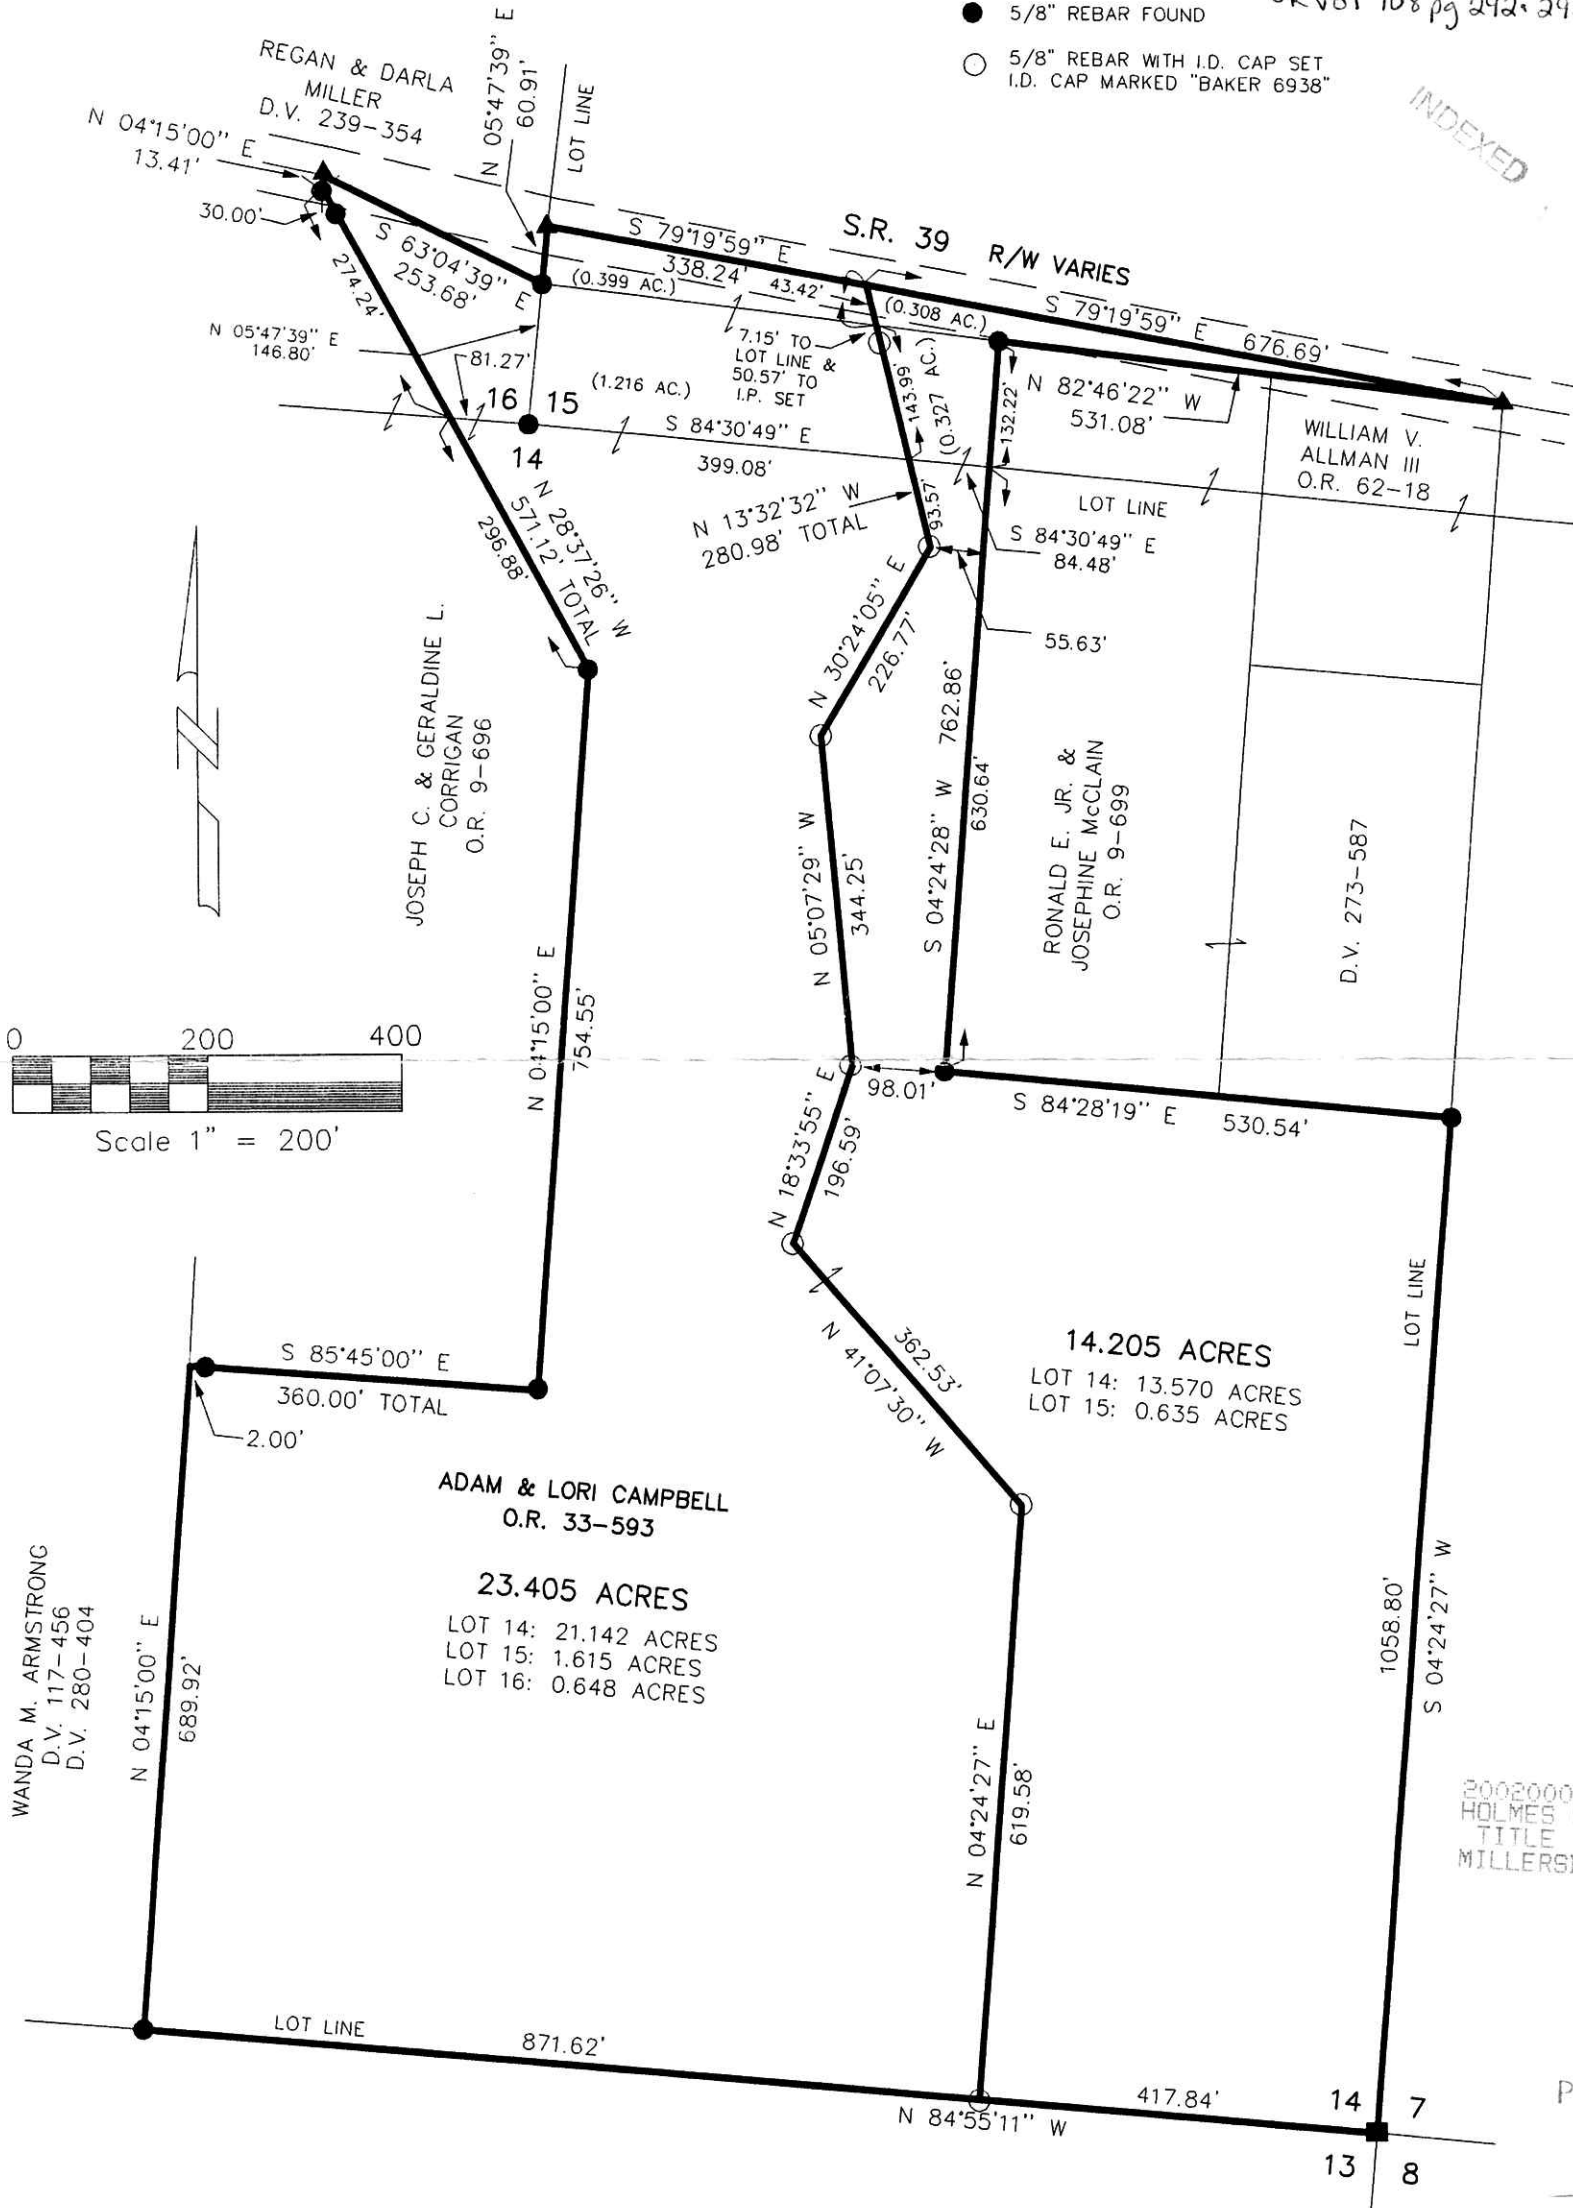


200200014752  
 HOLMES CTY  
 TITLE  
 MILLERSBURG,

PLAT APPROVED  
 3/27/2002



DONALD C. BAKER SURVEYING  
 138 N. CLAY ST.  
 MILLERSBURG, OHIO 44654  
 PH. 330-674-4788  
 FAX 330-674-6027

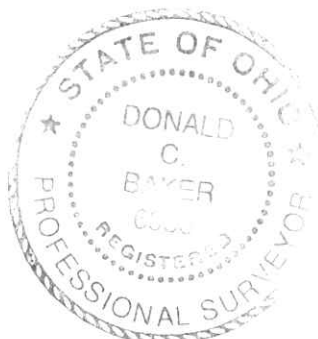

I CERTIFY THIS SURVEY TO BE CORRECT TO THE BEST OF MY KNOWLEDGE.

*Donald C. Baker*  
 DONALD C. BAKER P.S. 6938

FDB/ FCC DATE: MARCH. 7, 2002  
 File name: C:\JOBS1\S-140-02\ERZ